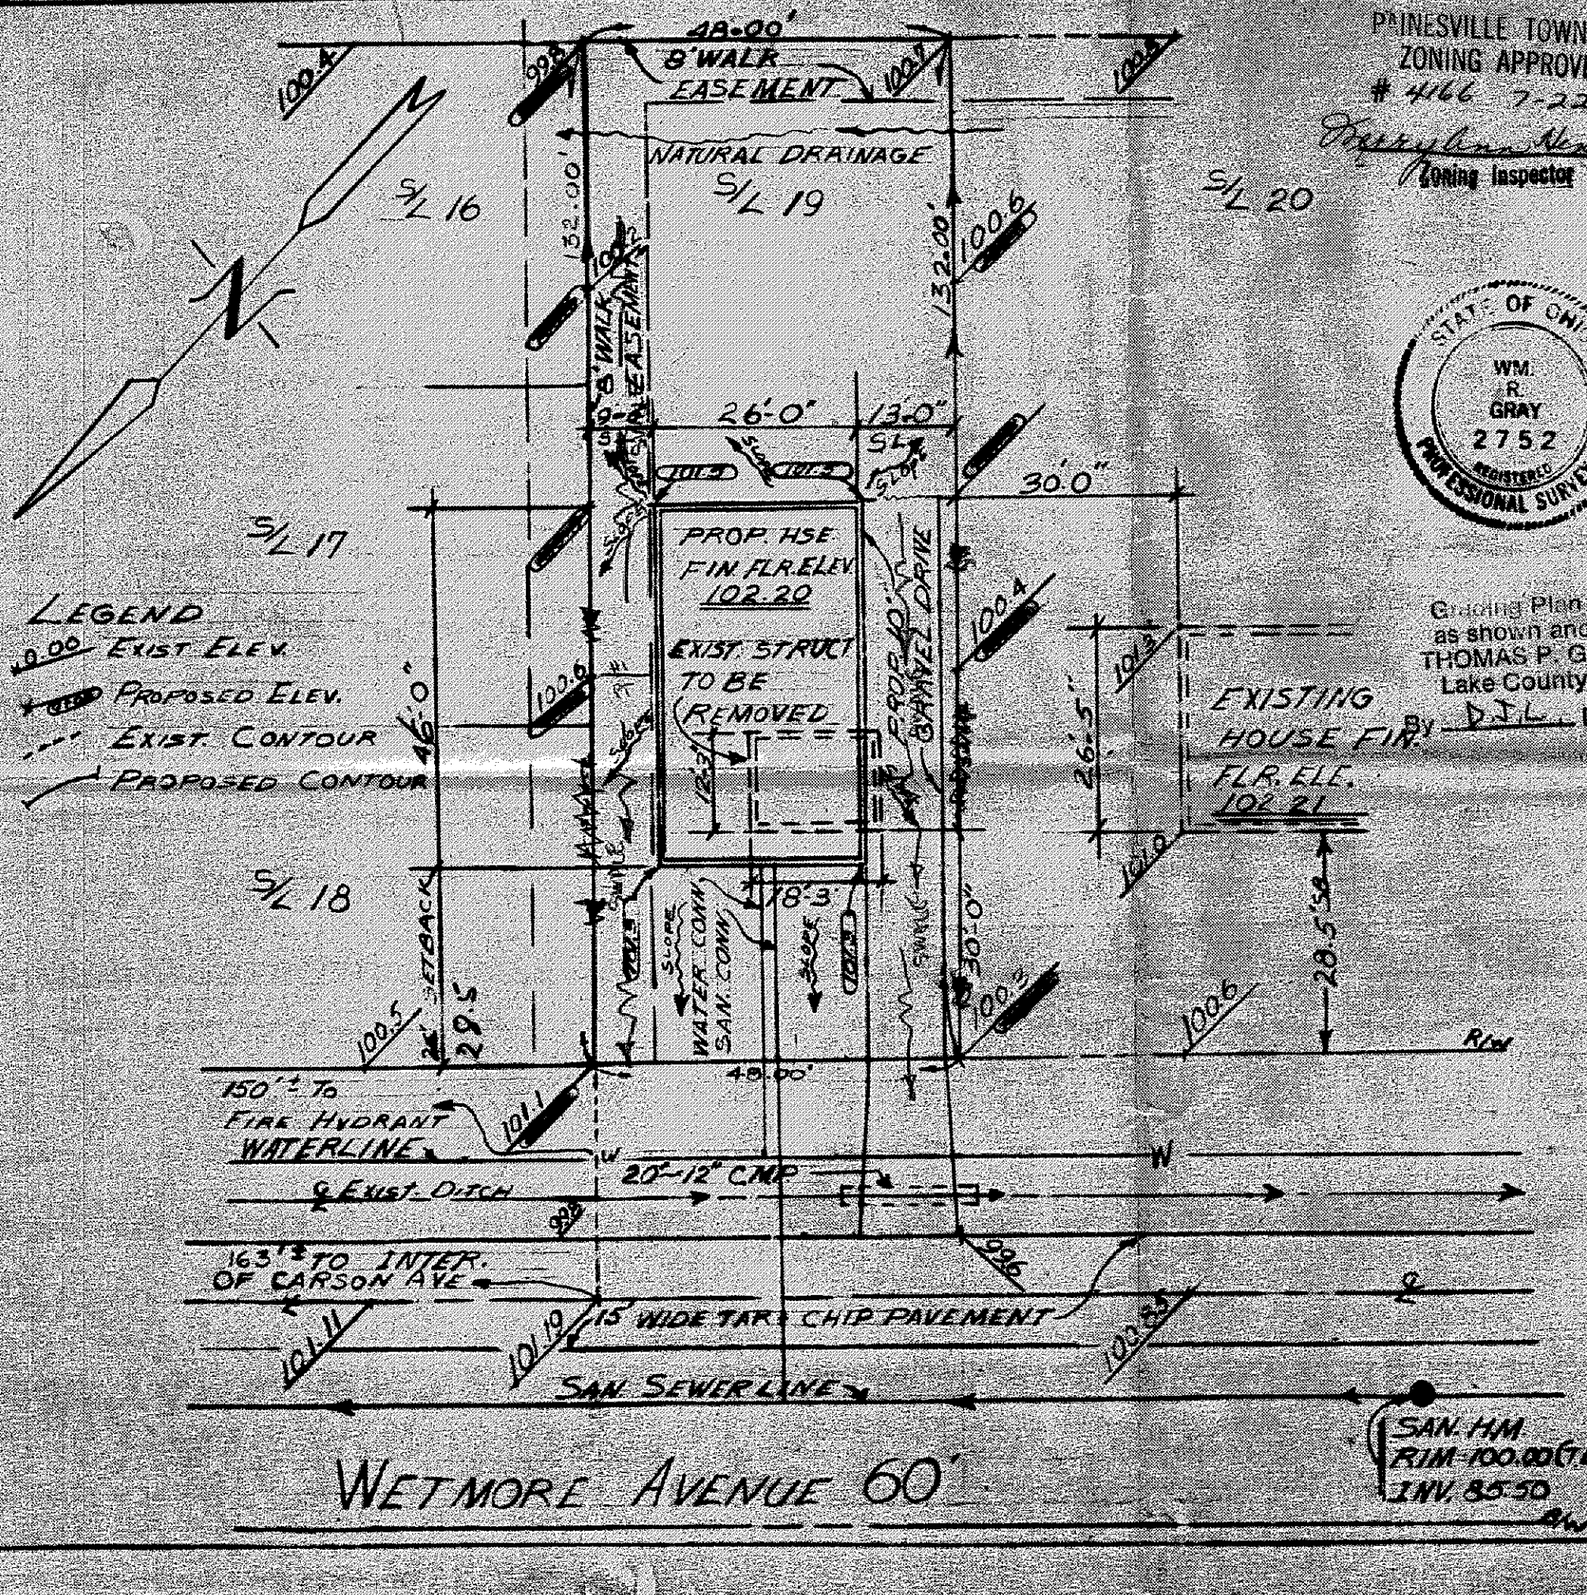

PAINESVILLE TOWNSHIP Appeal Board
ZONING APPROVED Changes noted
4166 7-22-77
Merry Ann Henderson
Zoning Inspector

STATE OF OHIO
WM. R. GRAY
2752
REGISTERED
PROFESSIONAL SURVEYOR

Grading Plan Approved as shown and/or noted
THOMAS P. GILLES, P.E.
Lake County Engineer
By D.J.L. Date 7/25/77

SITE PLAN FOR:

BILL BARBIS
RENWOOD AVENUE
EUCLID, OHIO
BEING SUBLOT NUMBER 19
BLOCK 122 IN G.C. MEIGS
RESURVEY OF A PART ORIGINAL
LOT NO. 20, LOCATED IN
PAINESVILE TOWNSHIP,
OHIO

PREPARED BY:

WM. R. GRAY ASSOC. INC.
7547 MENTOR AVENUE
MENTOR, OHIO

SCALE: =1"=20'

DATE: 6-2-77

CERTIFICATION:

I HEREBY CERITIFY THAT THIS PLAT IS CORRECT TO THE BEST OF MY KNOWLEGE

BY Wm R Gray

WM. R. GRAY REG. SURV. #2752