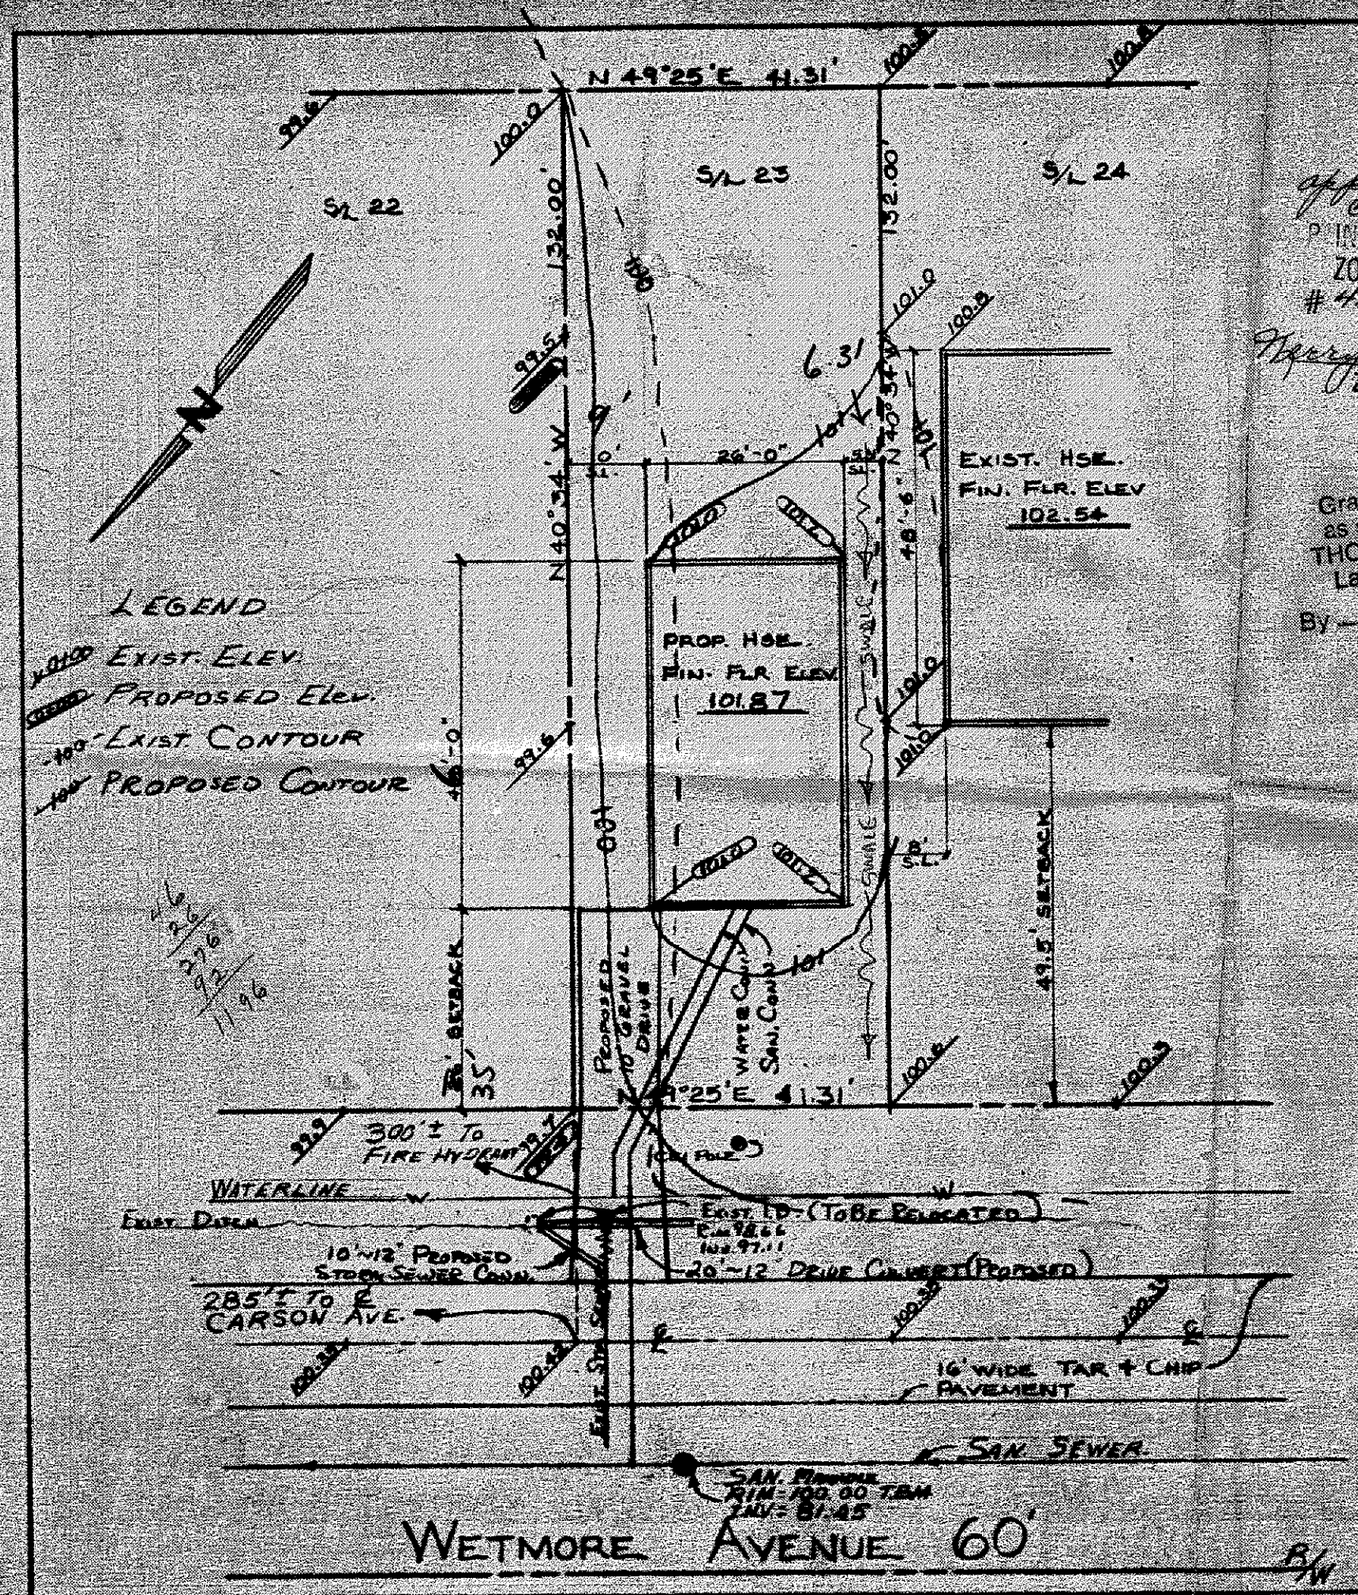

Appeals Board changes noted
PAINESVILLE TOWNSHIP
ZONING APPROVED
#4194 7-22-77
Nerry Ann Henderson
Zoning Inspector

Grading Plan Approved as shown and/or noted
THOMAS P. GILLES, P.E.
Lake County Engineer
By D.J.L. Date 7/25/77

SITE PLAN FOR:

BILL BARBIS
RENWOOD AVENUE
EUCLID, OHIO

BEING SUBLOT NUMBER 23 IN THE J. FRANK POLLOCK SUBDIVISION IN PAINESVILLE TOWNSHIP, OHIO

PREPARED BY:

WM. R. GRAY ASSOC. INC.
7547 MENTOR AVENUE
MENTOR, OHIO

SCALE: 1"=20'
DATE: 6-3-77

CERTIFICATION:

I HEREBY CERTIFY THAT THIS PLAT IS CORRECT TO THE BEST OF MY KNOWLEDGE.

BY: Wm. R. Gray
WM. R. GRAY REG. SURV. #2752

STATE OF OHIO
WM. R. GRAY
2752
REGISTERED
PROFESSIONAL SURVEYOR