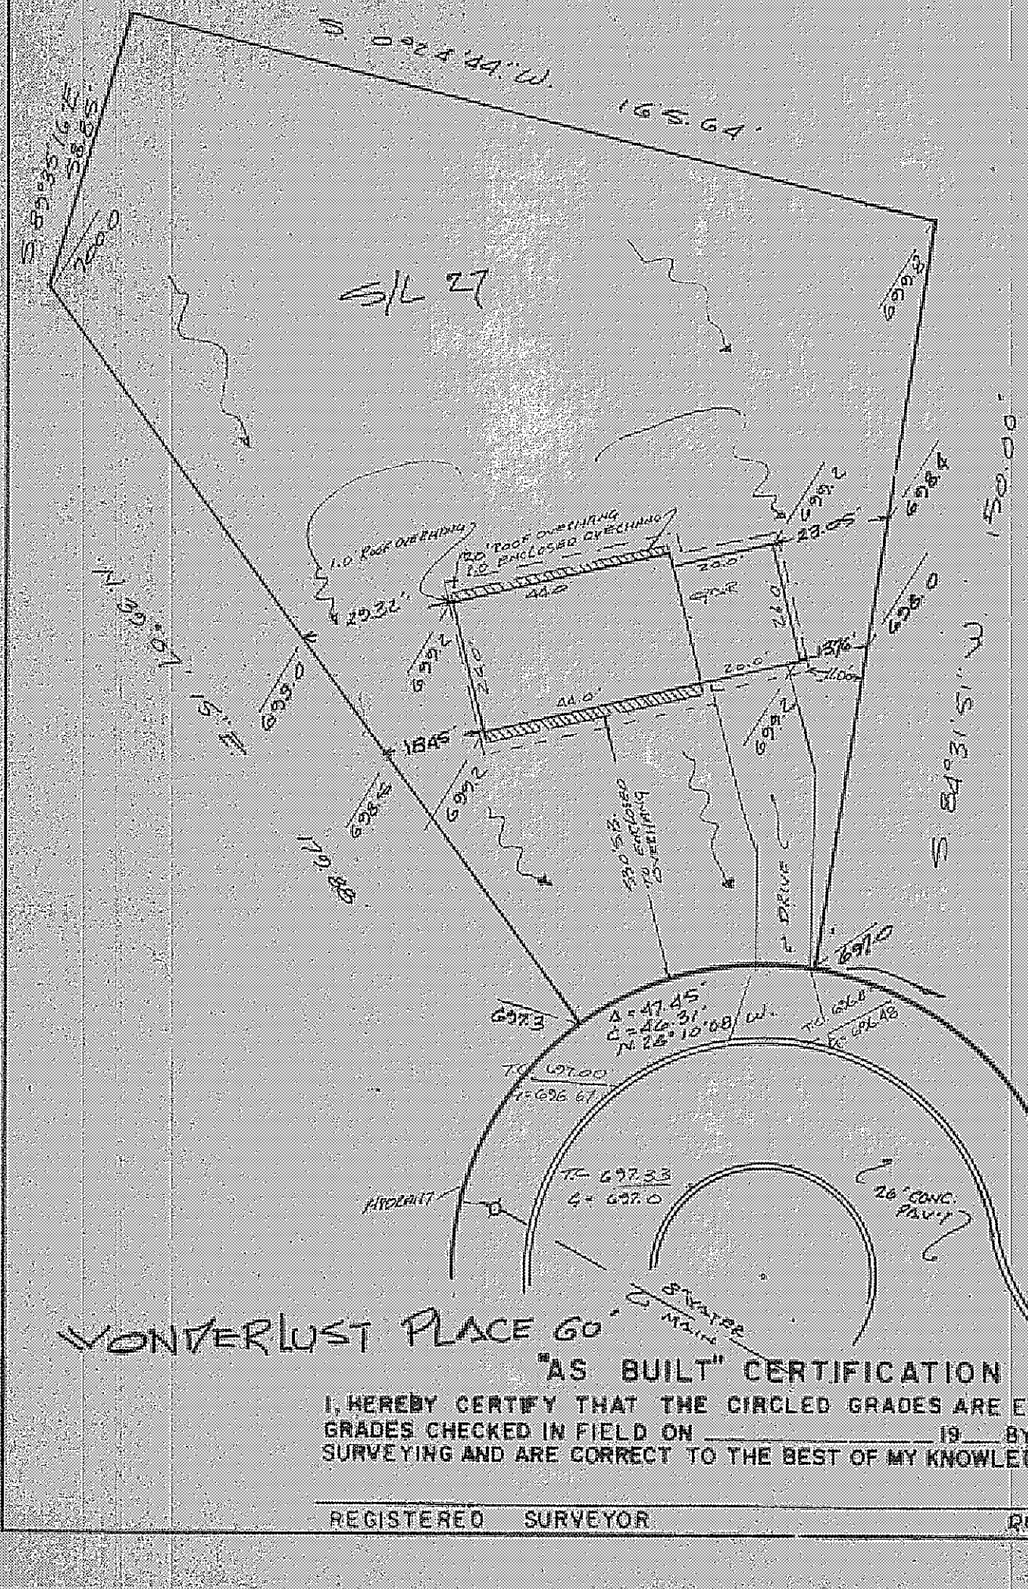
S. 09°24'44" W.
165.64'
S 55°35'15" E
200.0'
S/L 27
N. 69°07'
S. E.
179.88'
1.0 Rock Overhang
20' Roof Overhang
1.0 Enclosed Overhang
44.0'
23.05'
20.0'
27.0'
18.5'
5.00'
44.0'
20.0'
18.45'
1932'
