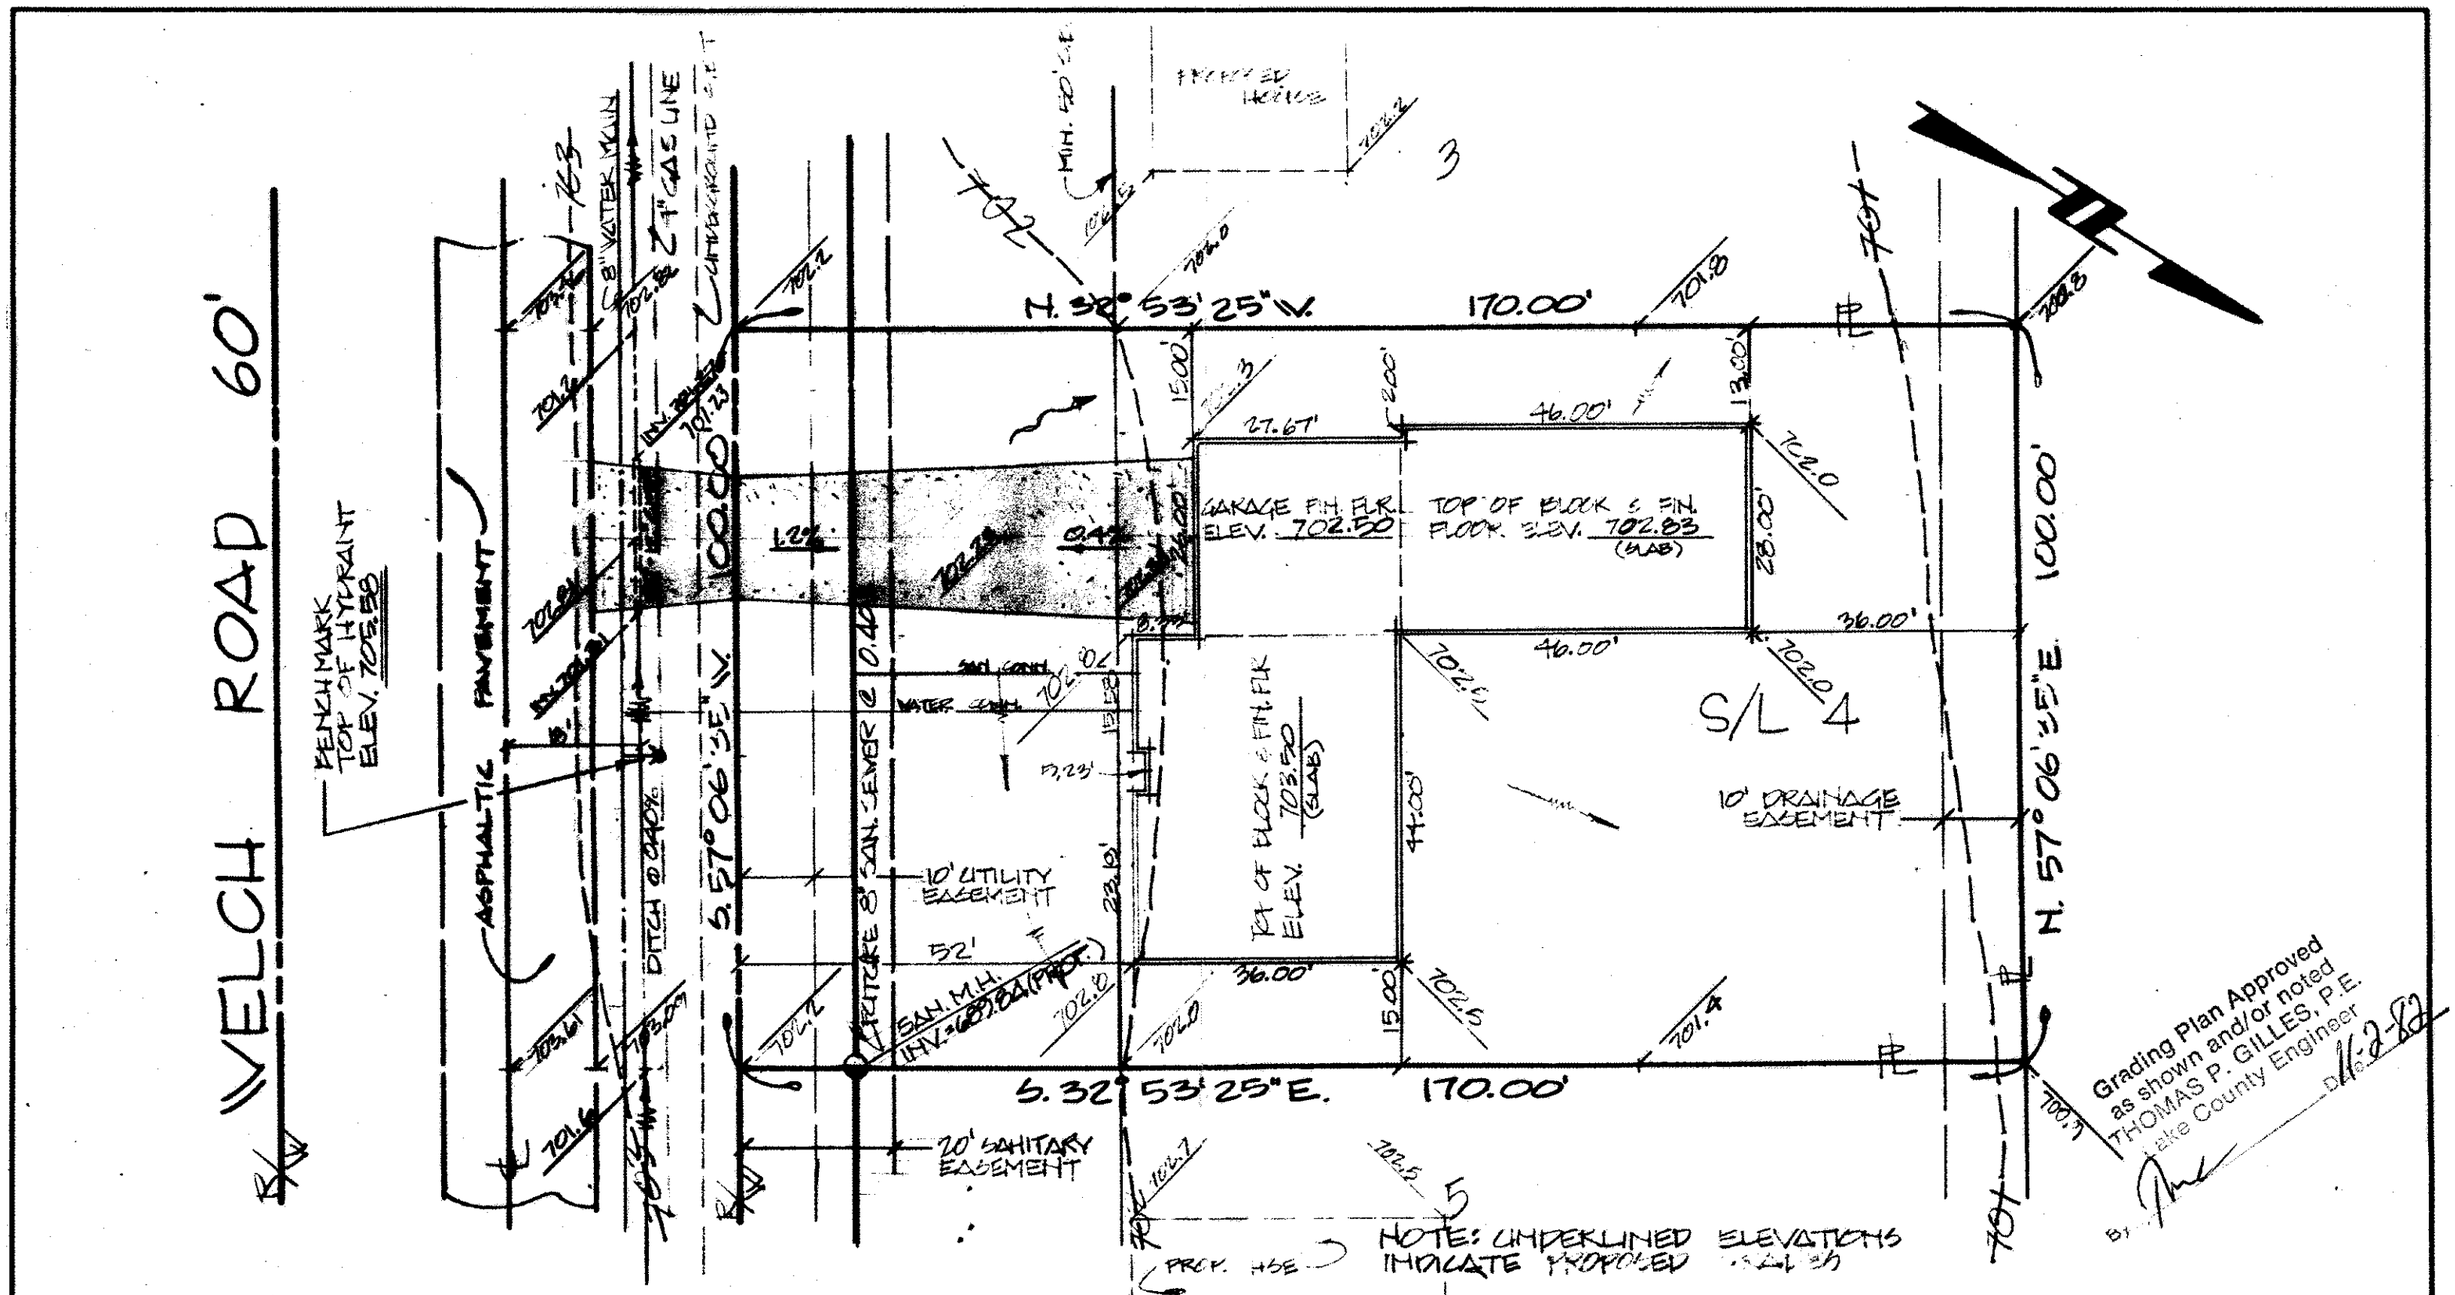

DESIGN CERTIFICATION

THIS PLAT WAS PREPARED BY ME, AND IS CORRECT TO THE BEST OF MY KNOWLEDGE AND BELIEF.

Timothy F. Hooper

REG. SURVEYOR NO. 6786

AS BUILT CERTIFICATION

I HEREBY CERTIFY THAT THE CIRCLED GRADES ARE EXISTING FINISH GRADES CHECKED IN THE FIELD ON _____ AND THAT SURVEY IS CORRECT TO THE BEST OF MY KNOWLEDGE AND BELIEF.

REG. SURVEYOR NO. _____

COLPETZER · WOODS
CONSULTANTS, INC.
9470 MENTOR AVENUE • MENTOR, OHIO 44066 • (216) 357-7569

DATE [illegible]
SCALE 1" = 20'
DRWN BY [illegible]
CHKD BY _____
JOB NO. [illegible]
FB [illegible] PG [illegible]

SITE PLAN FOR:
CASEMENT HOMES
1351 MADISON AVENUE
PAINESVILLE, OHIO
BEING SUBLOT NO. 4 IN CEDAR GLEN SUBD. NO. 1 IN PAINESVILLE TWP., OHIO.