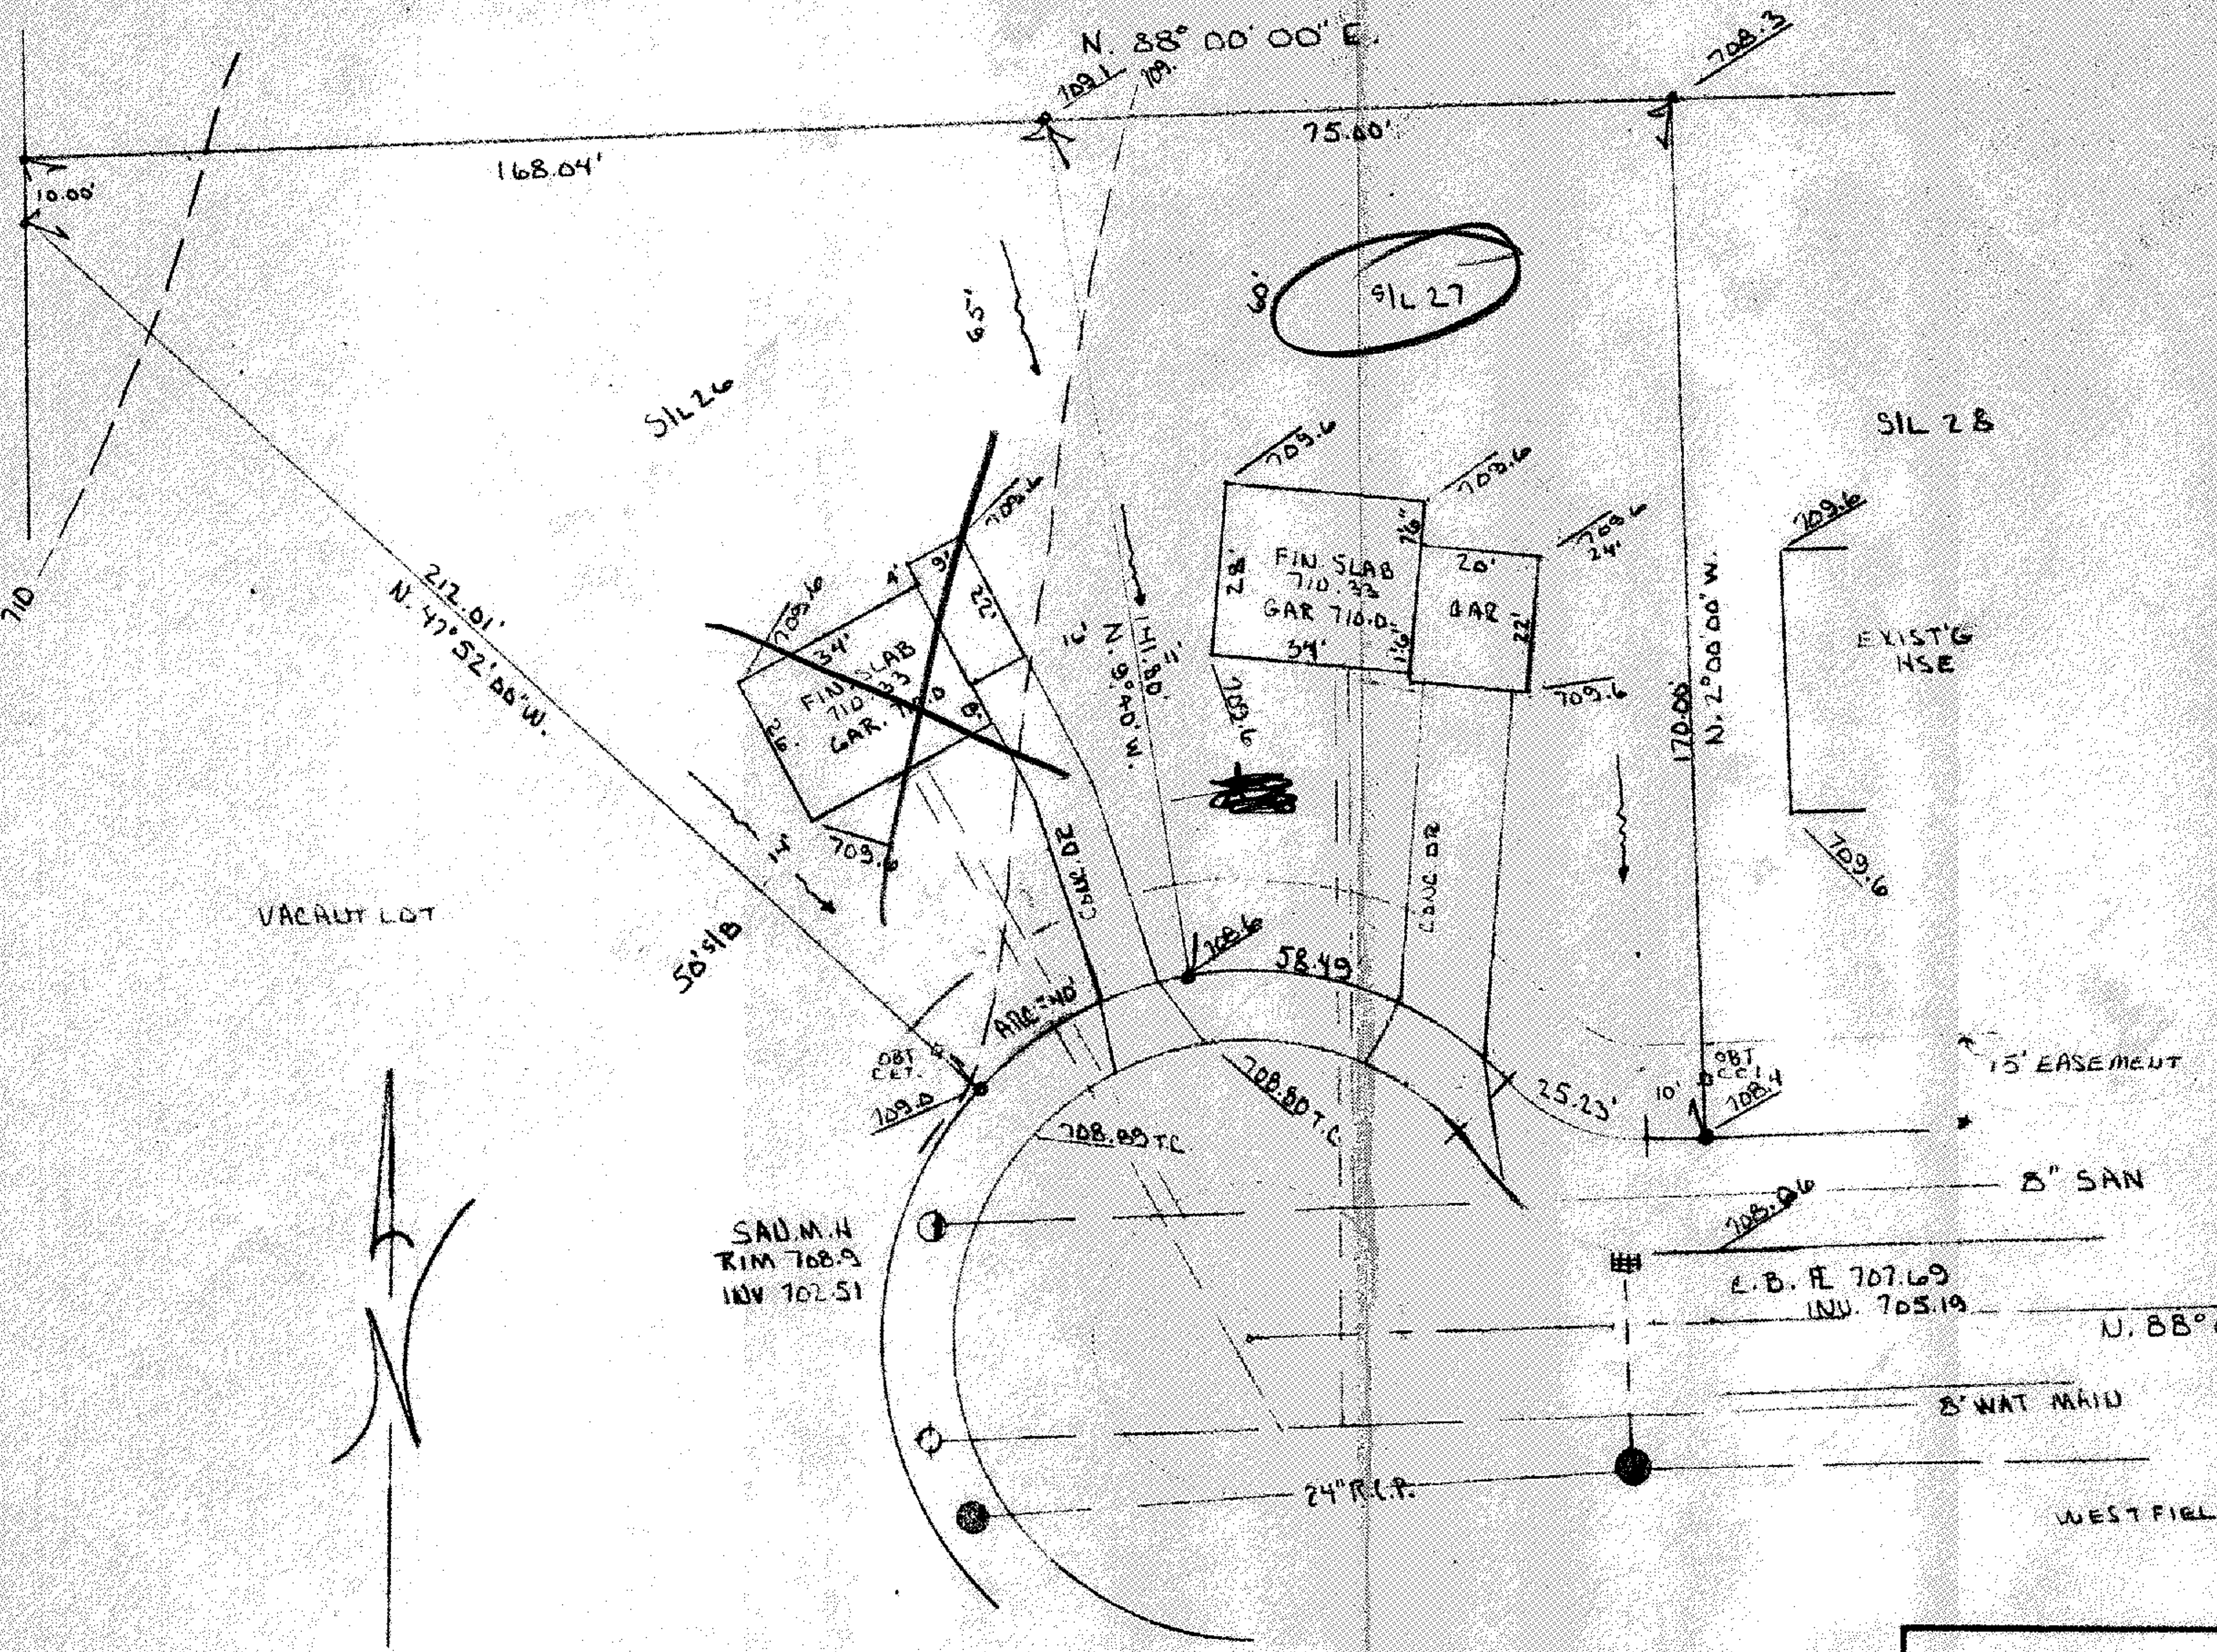

This Permit Expires
OCT 13 1983
PAINESVILLE TOWNSHIP
ZONING APPROVED
5623
S/L 27 ONLY
K. M. Hal
Zoning Inspector 10/13/82

I HEREBY CERTIFY THAT THIS PLAN WAS PREPARED BY ME AND IS CORRECT TO THE BEST OF MY KNOWLEDGE AND BELIEF.

John C Skoniecz
REG SURVEYOR # 6380

JOHN C SKONIECZNY
7739 VIEWMOUNT DR
PAINESVILLE OHIO
44077
PH 352-7742

EXIST'G / PROP GRADES
SWALE
• I PIN SET

Grading Plan Approved
as shown and/or noted
THOMAS P. GILLES, P.E.
Lake County Engineer
By ___ Date 10-15-82

BENCH MARK
TOP STEM OF HYDRANT AT INTERSECTION OF WESTFIELD CIRCLE AND DARTMOUTH DR
ELV. 711.67

SITE PLAN
FOR
SID SIMON Lexington Homes

SCALE: 1" = 30	APPROVED BY	DRAWN BY J.C.S.
DATE: OCT. 82		
OF SUBLOTS ~~26~~ · 27 IN THE HEATHERSTONE SUBD.		
TOWNSHIP OF PAINESVILLE		LAKE COUNTY OHIO
		DRAWING NUMBER 82-371

TELEDYNE POST 18AB-01E