


000\00039\00039-24.dwg Wed May 08 16:19:34 2002 Copyright Barrington Consulting Group, Inc.

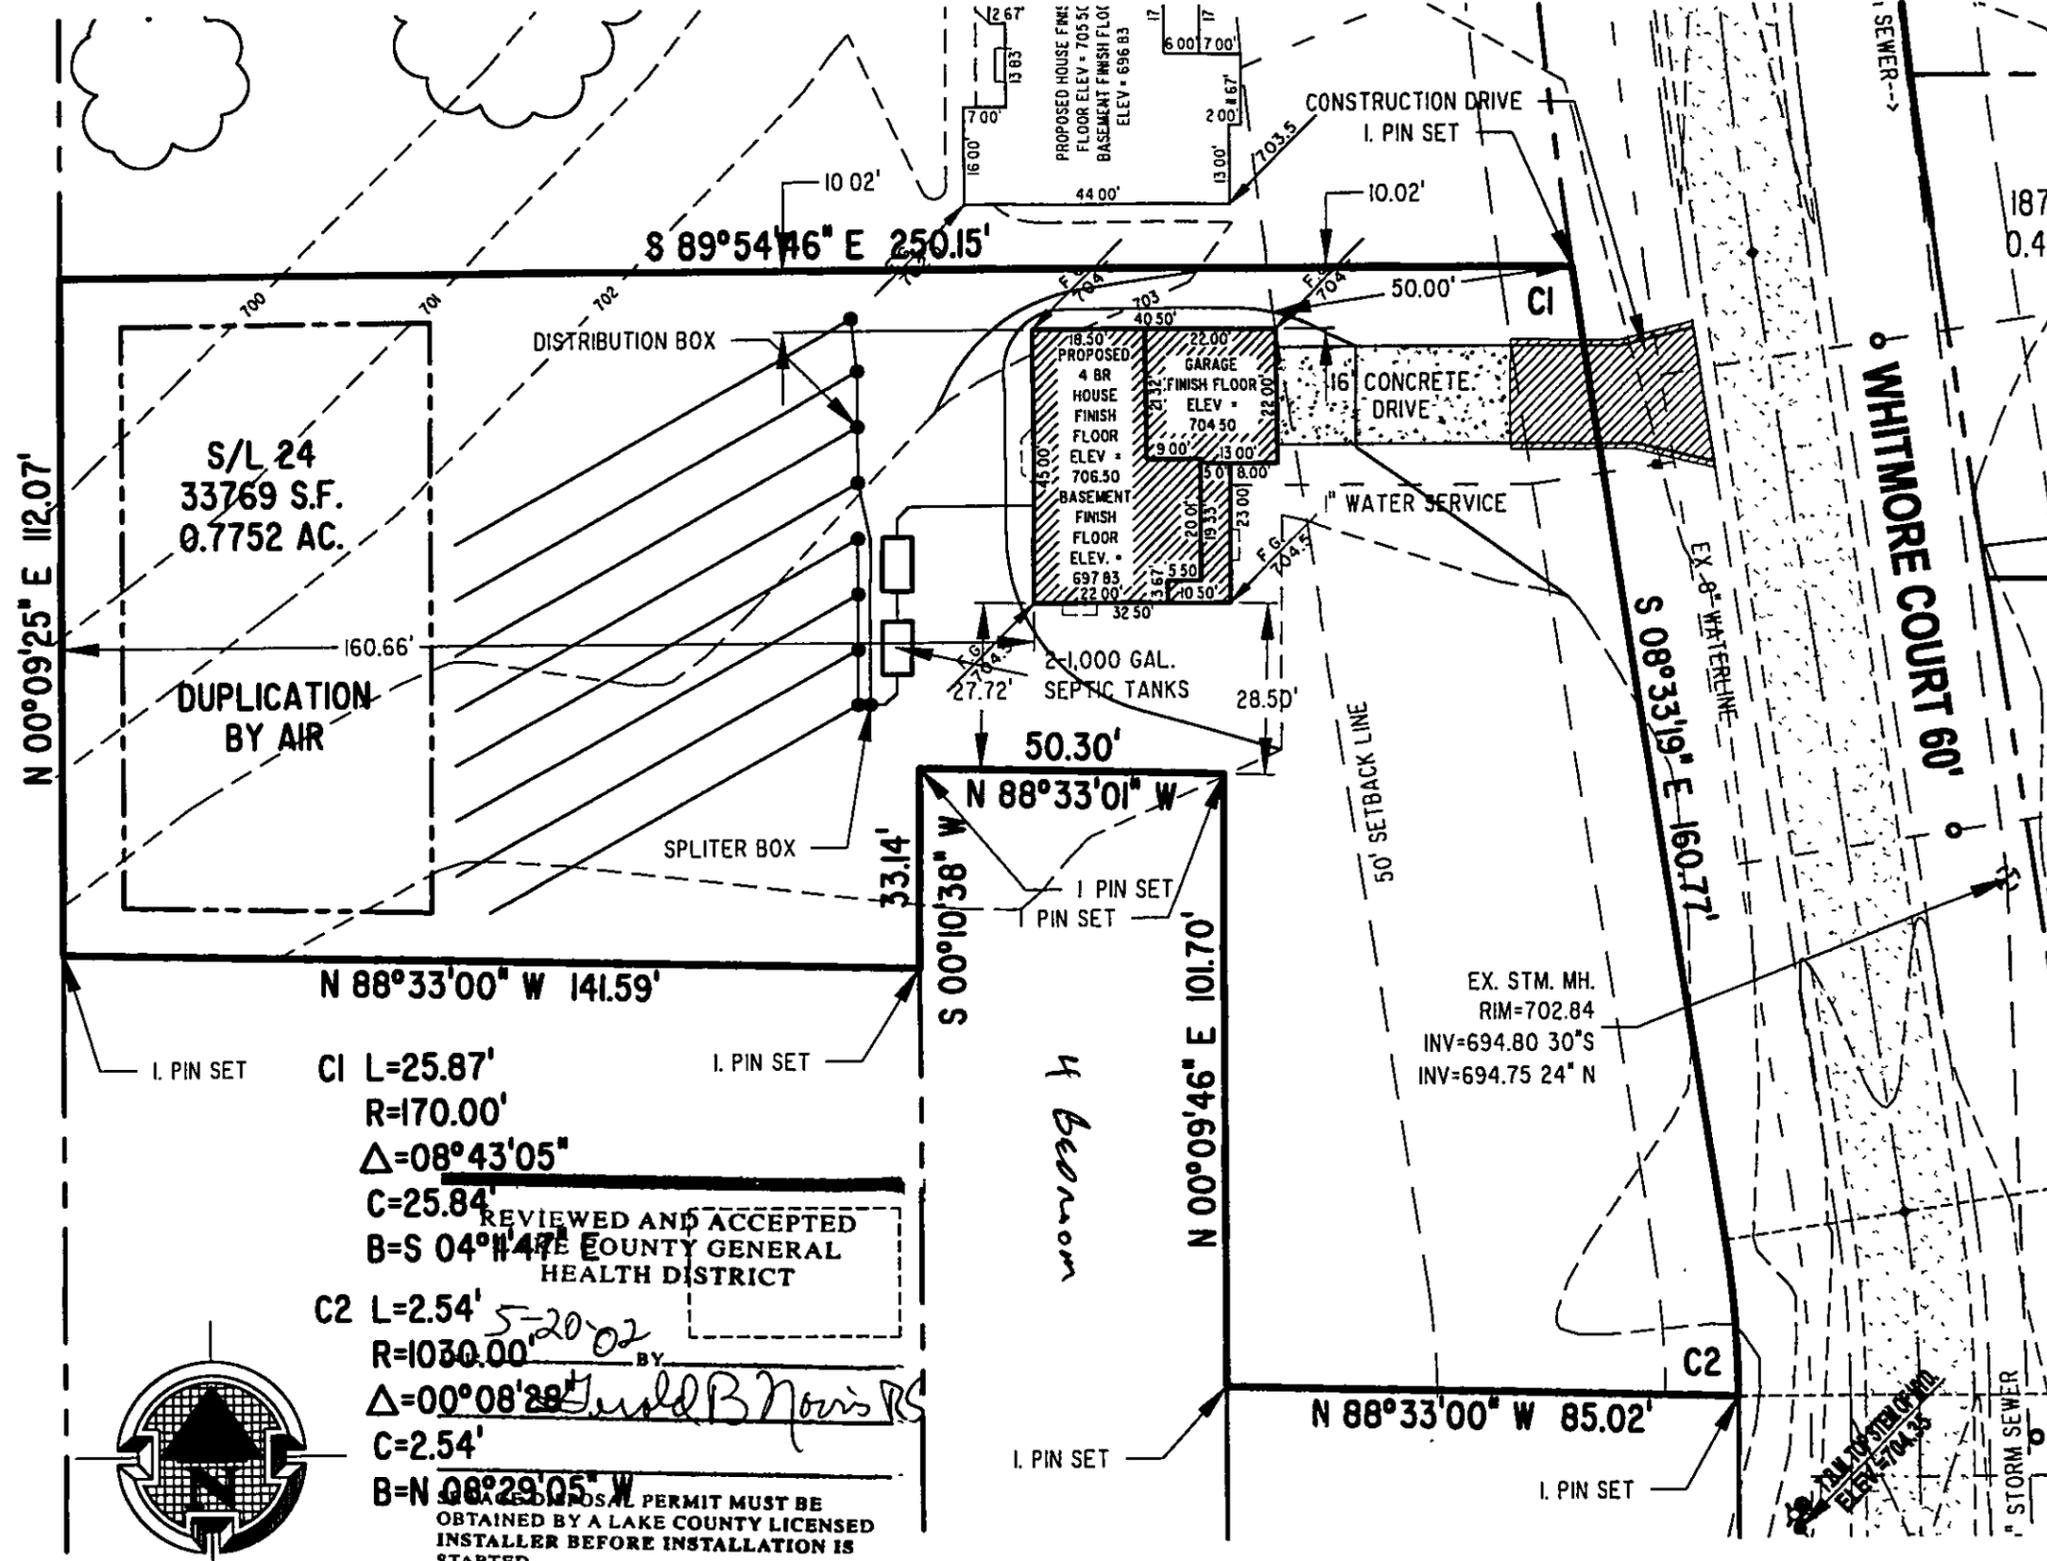

GENERAL NOTES:

1. BENCHMARK - TOP STEM OF FIRE HYDRANT ACROSS FROM SUBLLOT 21, ELEVATION=704.35.
2. DRIVEWAY APRON TO BE 6" THICK CONCRETE.
3. ALL DOWNSPOUTS TO BE OUTLETTED TO SPLASH BLOCKS.
4. CONTRACTOR RESPONSIBLE FOR CONTACTING THE OHIO UTILITY PROTECTION SERVICE (1.800.362.2764) AND ALL UTILITY COMPANIES A MINIMUM OF 48 HOURS PRIOR TO CONSTRUCTION.
5. THE LOCATION BOTH HORIZONTAL AND VERTICAL OF EXISTING UNDERGROUND UTILITIES SHOWN HEREON, HAVE BEEN OBTAINED BY A DILIGENT AND COMPREHENSIVE SEARCH OF AVAILABLE RECORDS. VERIFICATION BY FIELD OBSERVATION HAS BEEN CONDUCTED WHERE PRACTICAL, HOWEVER, BARRINGTON CONSULTING GROUP, INC. DOES NOT GUARANTEE THE COMPLETENESS, NOR ACCURACY THEREOF.
6. CONTRACTOR SHALL VERIFY ELEVATIONS OF LATREAL INVERTS IN THE FIELD PRIOR TO FOUNDATION EXCAVATION.
7. EROSION AND SEDIMENT-CONTROL PRACTICES TO BE INSTALLED AS DESCRIBED IN THE RAIN WATER LAND DEVELOPMENT MANUAL AS DIRECTED BY THE LAKE COUNTY SOIL AND WATER CONSERVATION DISTRICT.
8. TEMPORARY SEEDING SHALL BE APPLIED ON ALL DISTURBED SOIL THAT WILL NOT BE REWORKED FOR WITHIN 30 DAYS. THESE IDLE AREAS TO BE SEEDED WITHIN 7 DAYS.

CERTIFICATION:

"I THE UNDERSIGNED HEREBY CERTIFIES THAT THIS TOPOGRAPHY INDICATED BY 1 FOOT CONTOURS AND ELEVATION SHOWN HEREON REPRESENTS AN ACTUAL SURVEY MADE BY ME ON THE 7th DAY OF JULY, 2000 AND THE ELEVATIONS WERE TAKEN AT AN APPROPRIATE INTERVAL AND AS OF THAT DAY THEY EXISTED AS INDICATED HEREON.


"I HEREBY CERTIFY THAT THIS PLAN WAS PREPARED BY ME AND IS CORRECT TO THE BEST OF MY KNOWLEDGE AND BELIEF"

REVIEWED AND ACCEPTED
 COUNTY GENERAL HEALTH DISTRICT
 BY: *David B. Norris* P.E.
 DATE: 5-20-02

ALL NECESSARY PERMITS MUST BE OBTAINED BY A LAKE COUNTY LICENSED INSTALLER BEFORE INSTALLATION IS STARTED



Barrington
 CONSULTING GROUP, INC.

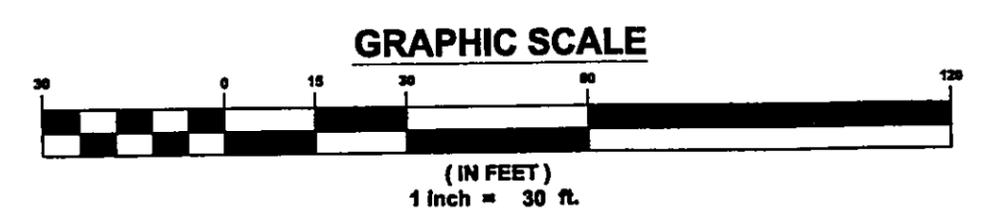

Grading Plan Approved as shown and/or noted
 JAMES R. GILLS, P.E.
 Lake County Engineer
 By: *WJH* Date: 5/21/02

DAVID W. NOVAK, P.S. No. 7507

REVISIONS	BY

Barrington
 CONSULTING GROUP, INC.
 3842 WESTERN PARKWAY, SUITE 10
 WILLOUGHBY, OHIO 44094
 PHONE 440.946.1761 FAX 440.918.0486



SITE PLAN
 SUBLLOT 24 WHITMORE COURT, PAINESVILLE TWP, OHIO 44077
 WHITMORE SUBDIVISION
 LITTLE MOUNTAIN HOMES, INC.

DRAWN D.W. NOVAK
CHECKED DWN
DATE MAY 6, 2002
SCALE 1" = 30'
JOB NO 00039-24
SHEET 1/2