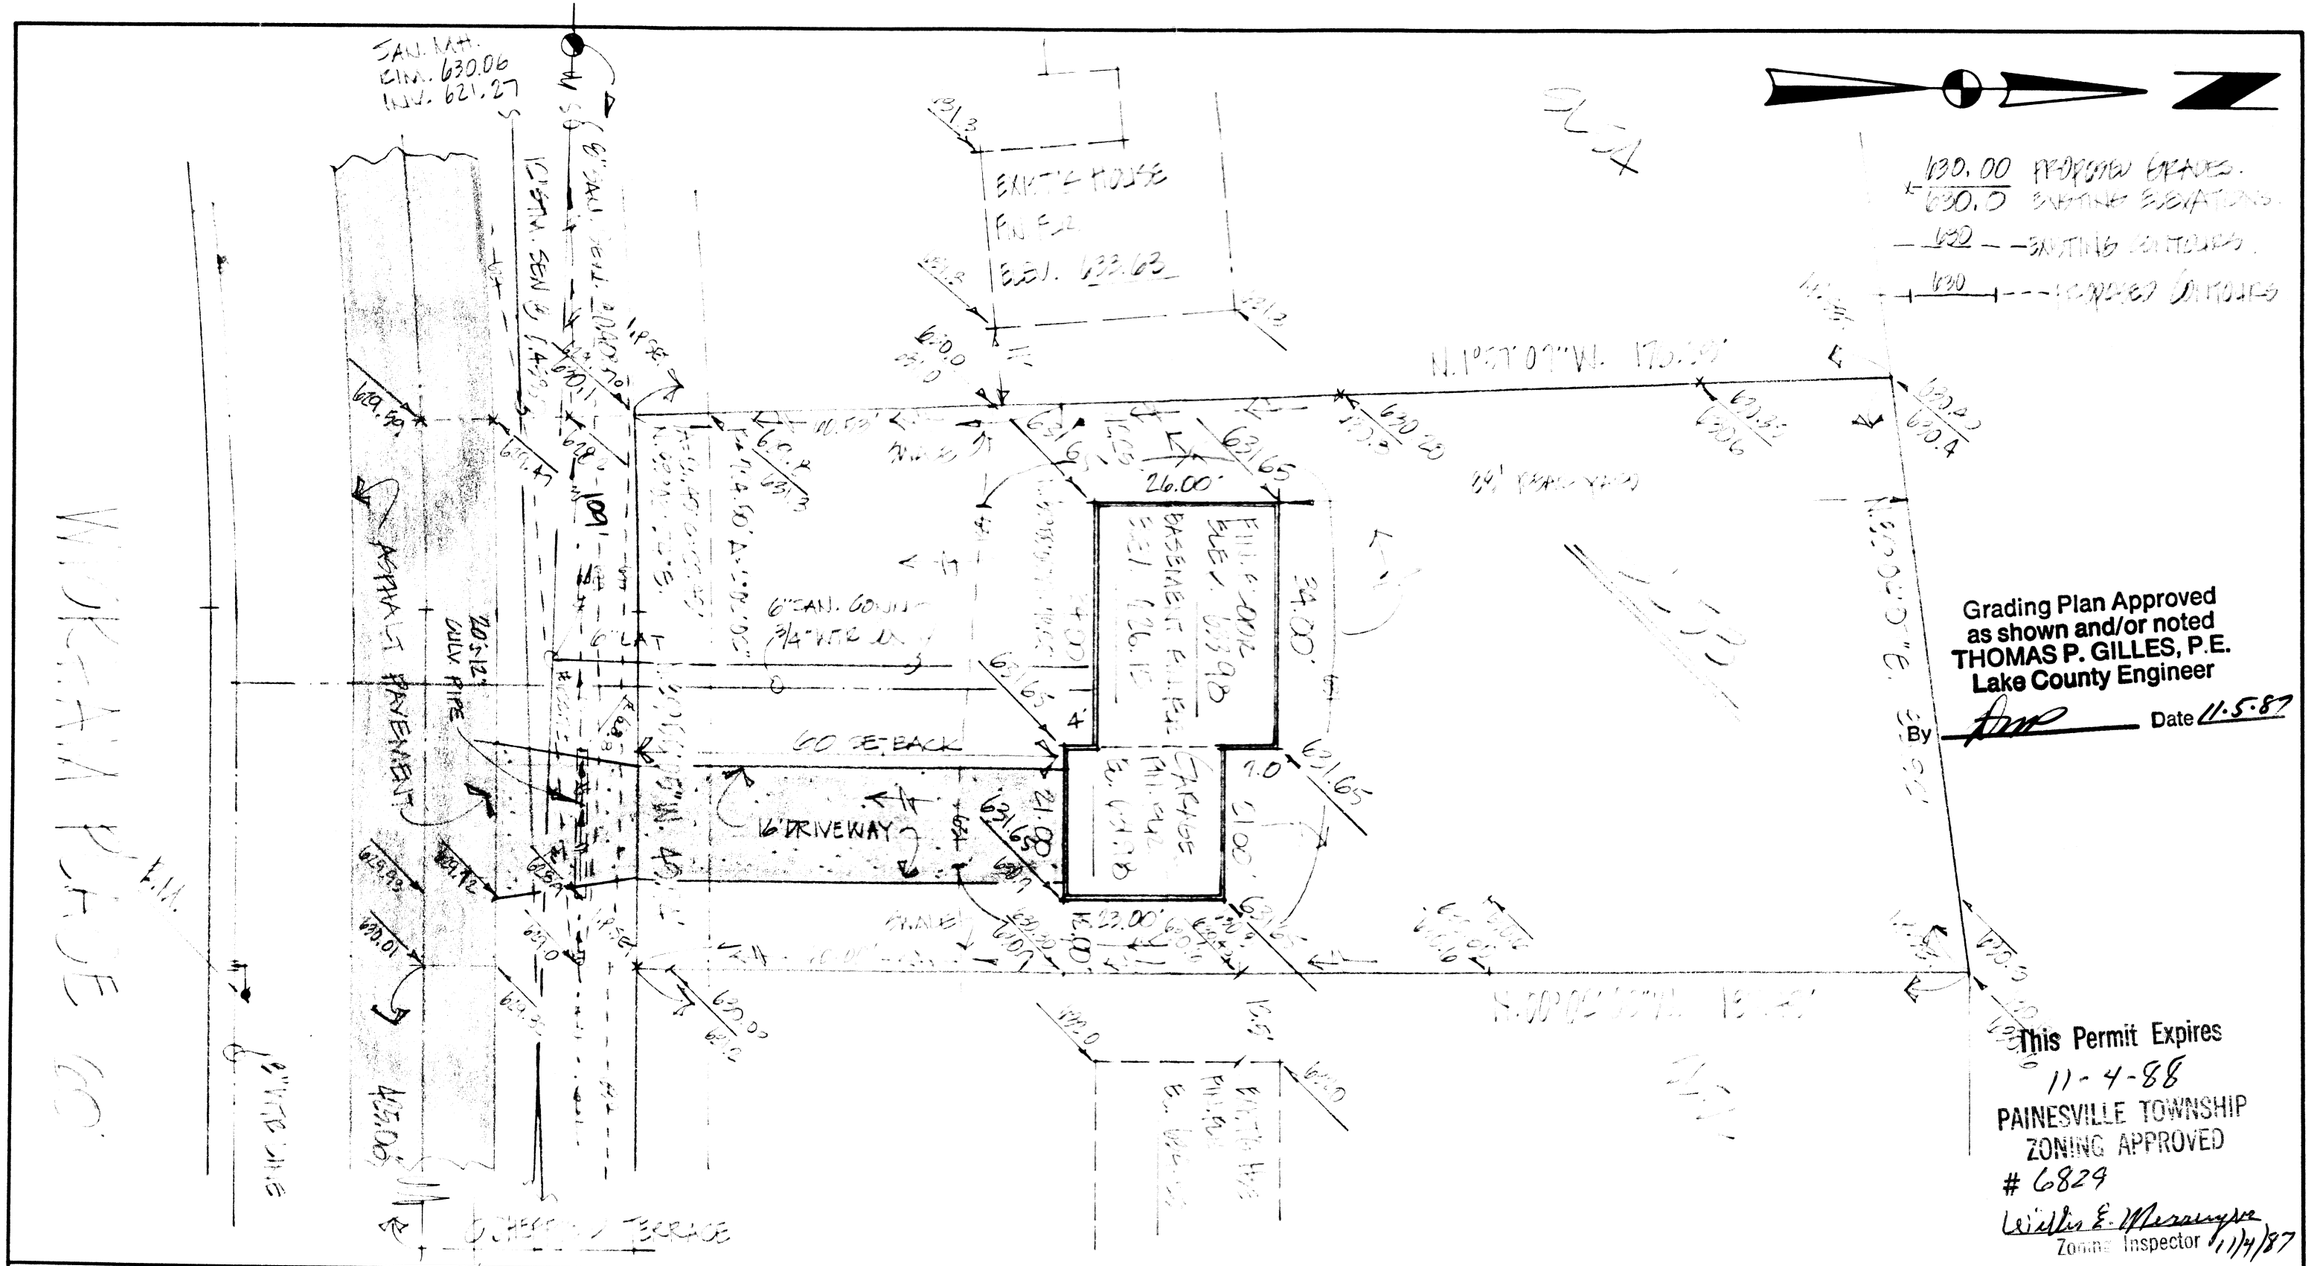

Grading Plan Approved
as shown and/or noted
THOMAS P. GILLES, P.E.
Lake County Engineer

By [signature] Date 11-5-87

This Permit Expires
11-4-88
PAINESVILLE TOWNSHIP
ZONING APPROVED
6829
Willis E. Merrington
Zoning Inspector 11/4/87

DESIGN CERTIFICATION	AS BUILT CERTIFICATION			
THIS PLAT WAS PREPARED BY ME. AND IS CORRECT TO THE BEST OF MY KNOWLEDGE AND BELIEF. [signature] REG. SURVEYOR NO. 5244	I HEREBY CERTIFY THAT THE CIRCLED GRADES ARE EXISTING FINISH GRADES CHECKED IN THE FIELD ON _____ AND THAT SURVEY IS CORRECT TO THE BEST OF MY KNOWLEDGE AND BELIEF. REG. SURVEYOR NO.	COLPETZER · WOODS CONSULTANTS, INC. 9470 MENTOR AVENUE • MENTOR, OHIO 44060 • (216) 357-7569	DATE 10/31/87 SCALE 1"=20' DRWN BY [illegible] CHKD BY JOB NO. 79-156 FB 331 PG 67	SITE PLAN FOR: EDWARD H. TRESSER, INC. 8100 DEERWOOD ROAD, MENTOR, OHIO 44060 [illegible]