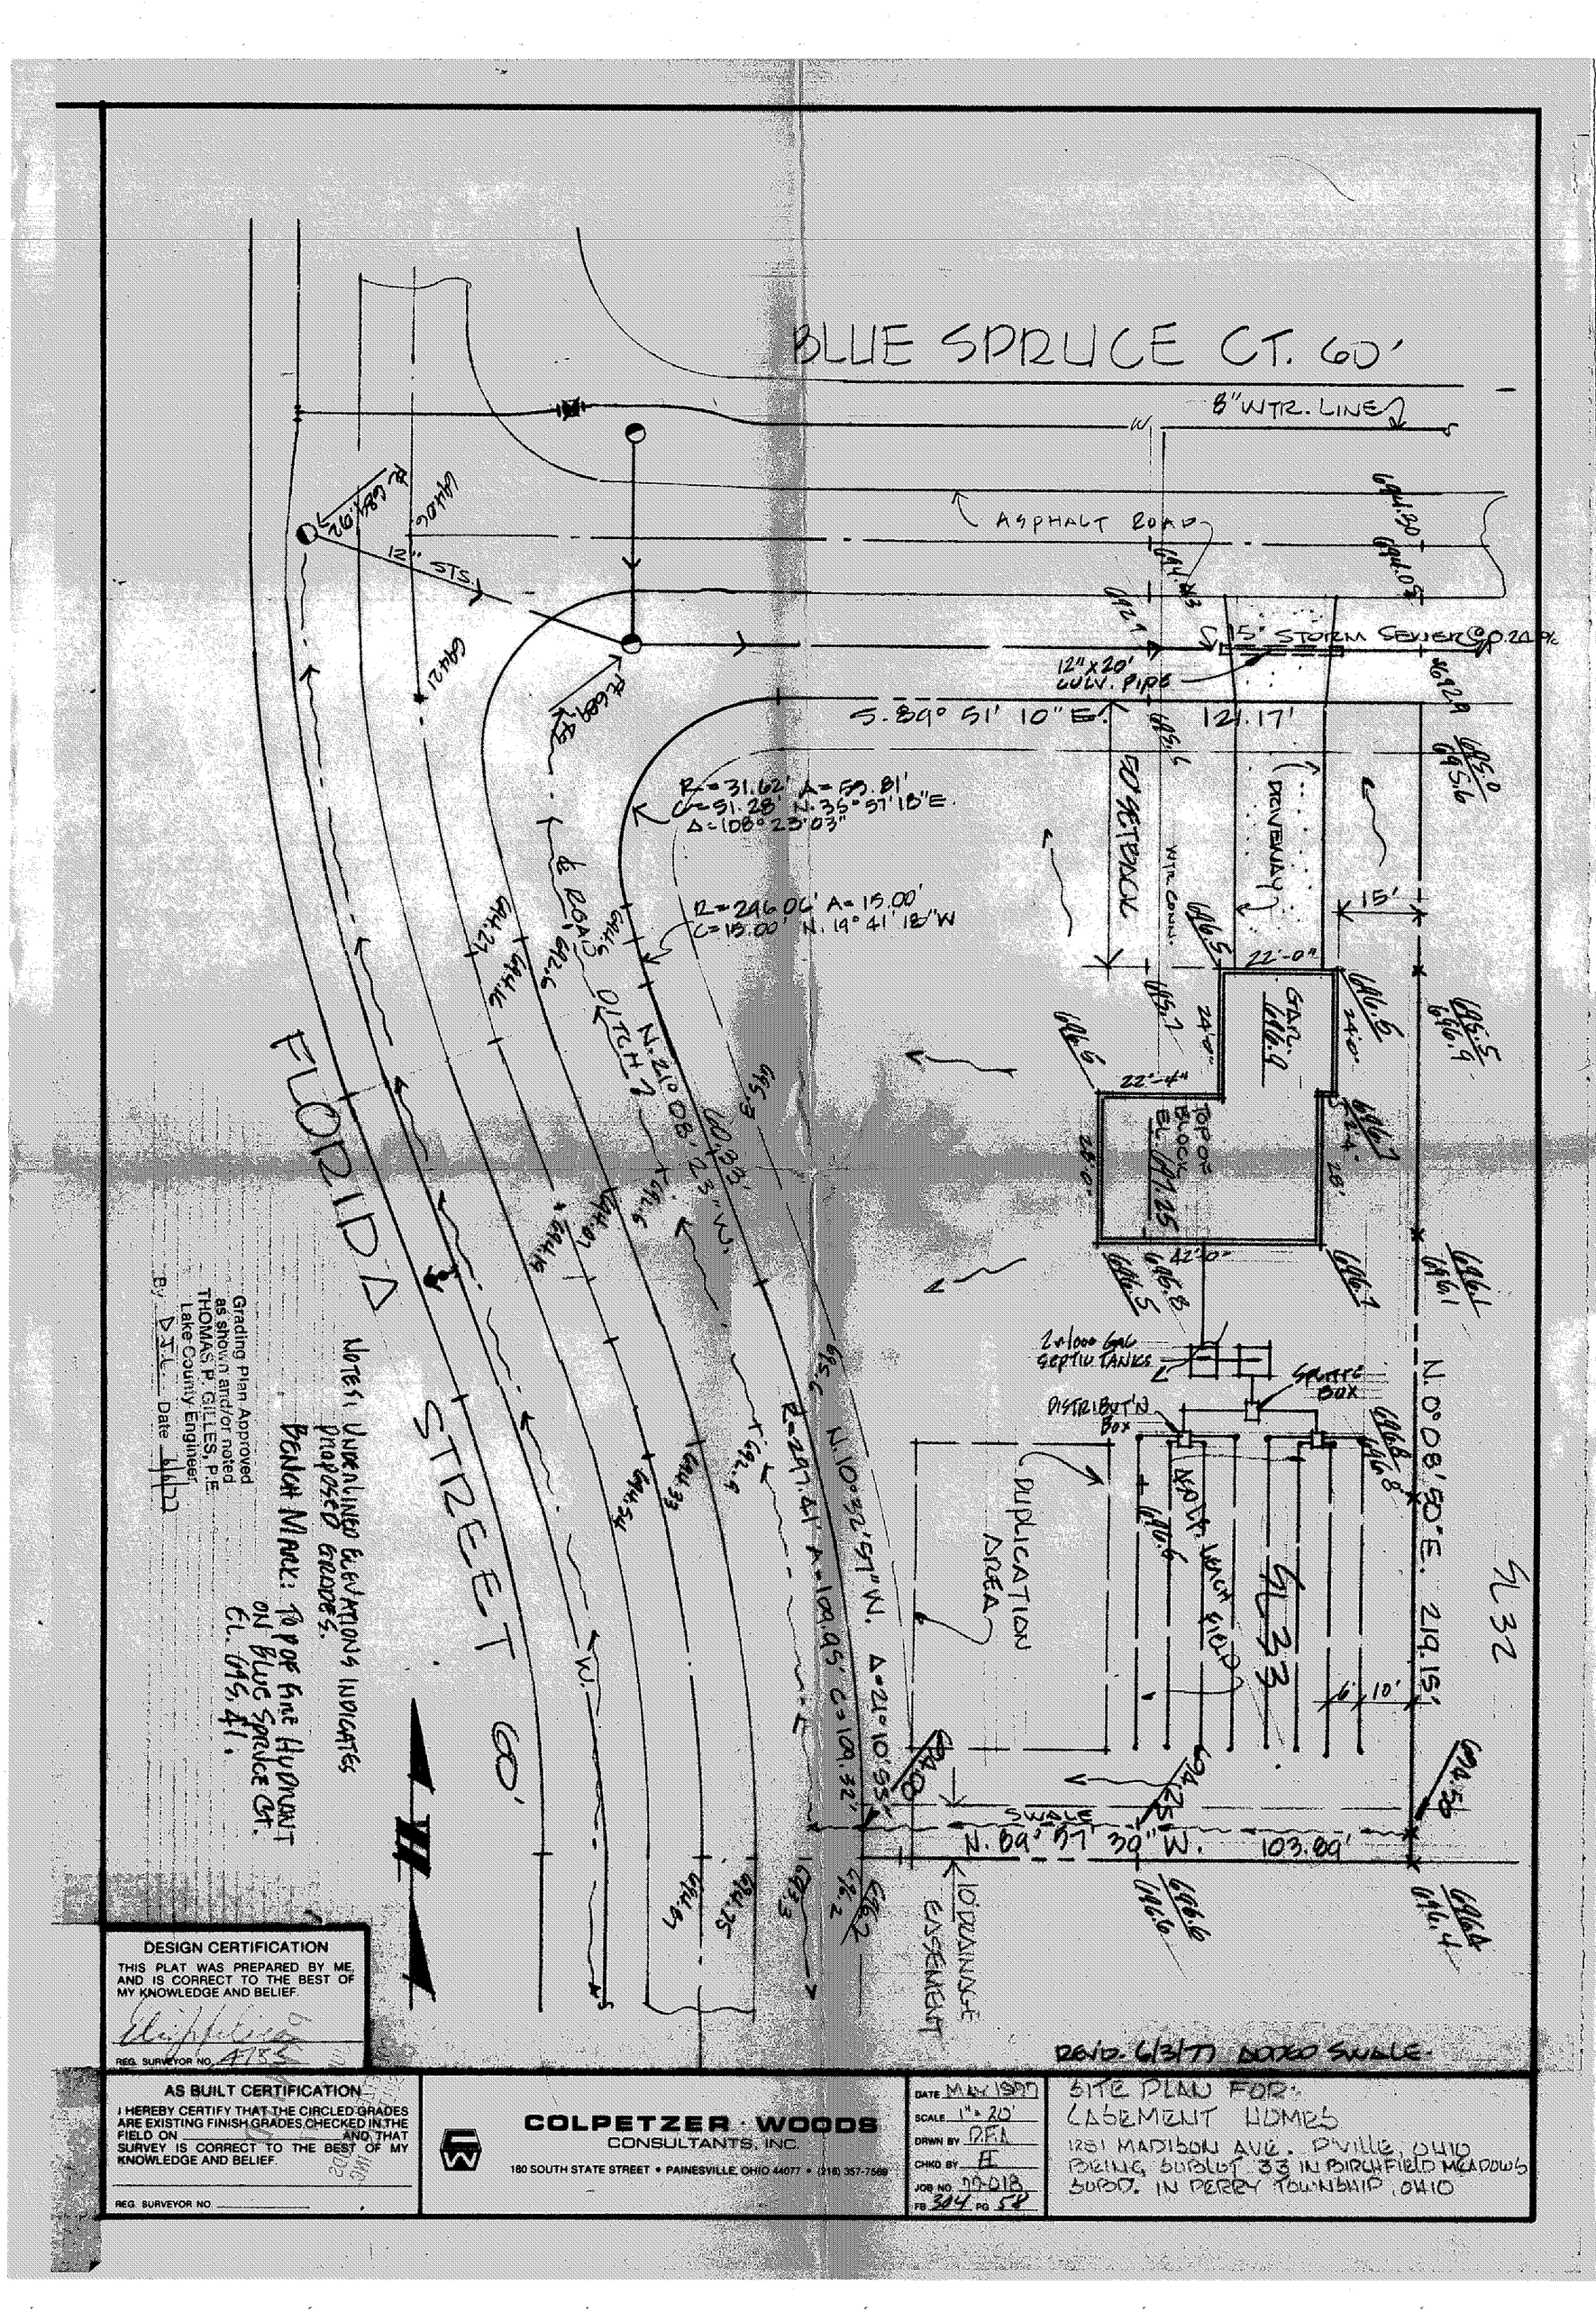


**DESIGN CERTIFICATION**

THIS PLAT WAS PREPARED BY ME AND IS CORRECT TO THE BEST OF MY KNOWLEDGE AND BELIEF.

REG. SURVEYOR NO. 4755

**AS BUILT CERTIFICATION**

I HEREBY CERTIFY THAT THE CIRCLED GRADES ARE EXISTING FINISH GRADES CHECKED IN THE FIELD ON _____ AND THAT SURVEY IS CORRECT TO THE BEST OF MY KNOWLEDGE AND BELIEF.

REG. SURVEYOR NO. _____

**COLPETZER · WOODS**
CONSULTANTS, INC.
160 SOUTH STATE STREET • PAINESVILLE, OHIO 44077 • (216) 357-7569

DATE MAY 1977
SCALE 1" = 20'
DRWN BY DFA
CHKD BY [illegible]
JOB NO. 77-019
FB 304 PG 58

SITE PLAN FOR:
EASEMENT HOMES
1281 MADISON AVE. PVILLE, OHIO
BEING SUBLOT 33 IN BIRCHFIELD MEADOWS SUBD. IN PERRY TOWNSHIP, OHIO