APPROVED
SIDE LINES & SET BACK
PERRY TOWNSHIP ZONING
PERMIT NO. 1367
ZONING INSPECTOR

Grading Plan Approved
as shown and/or noted
THOMAS P. GILLES, P.E.
Lake County Engineer
By JWK Date 12-6-73

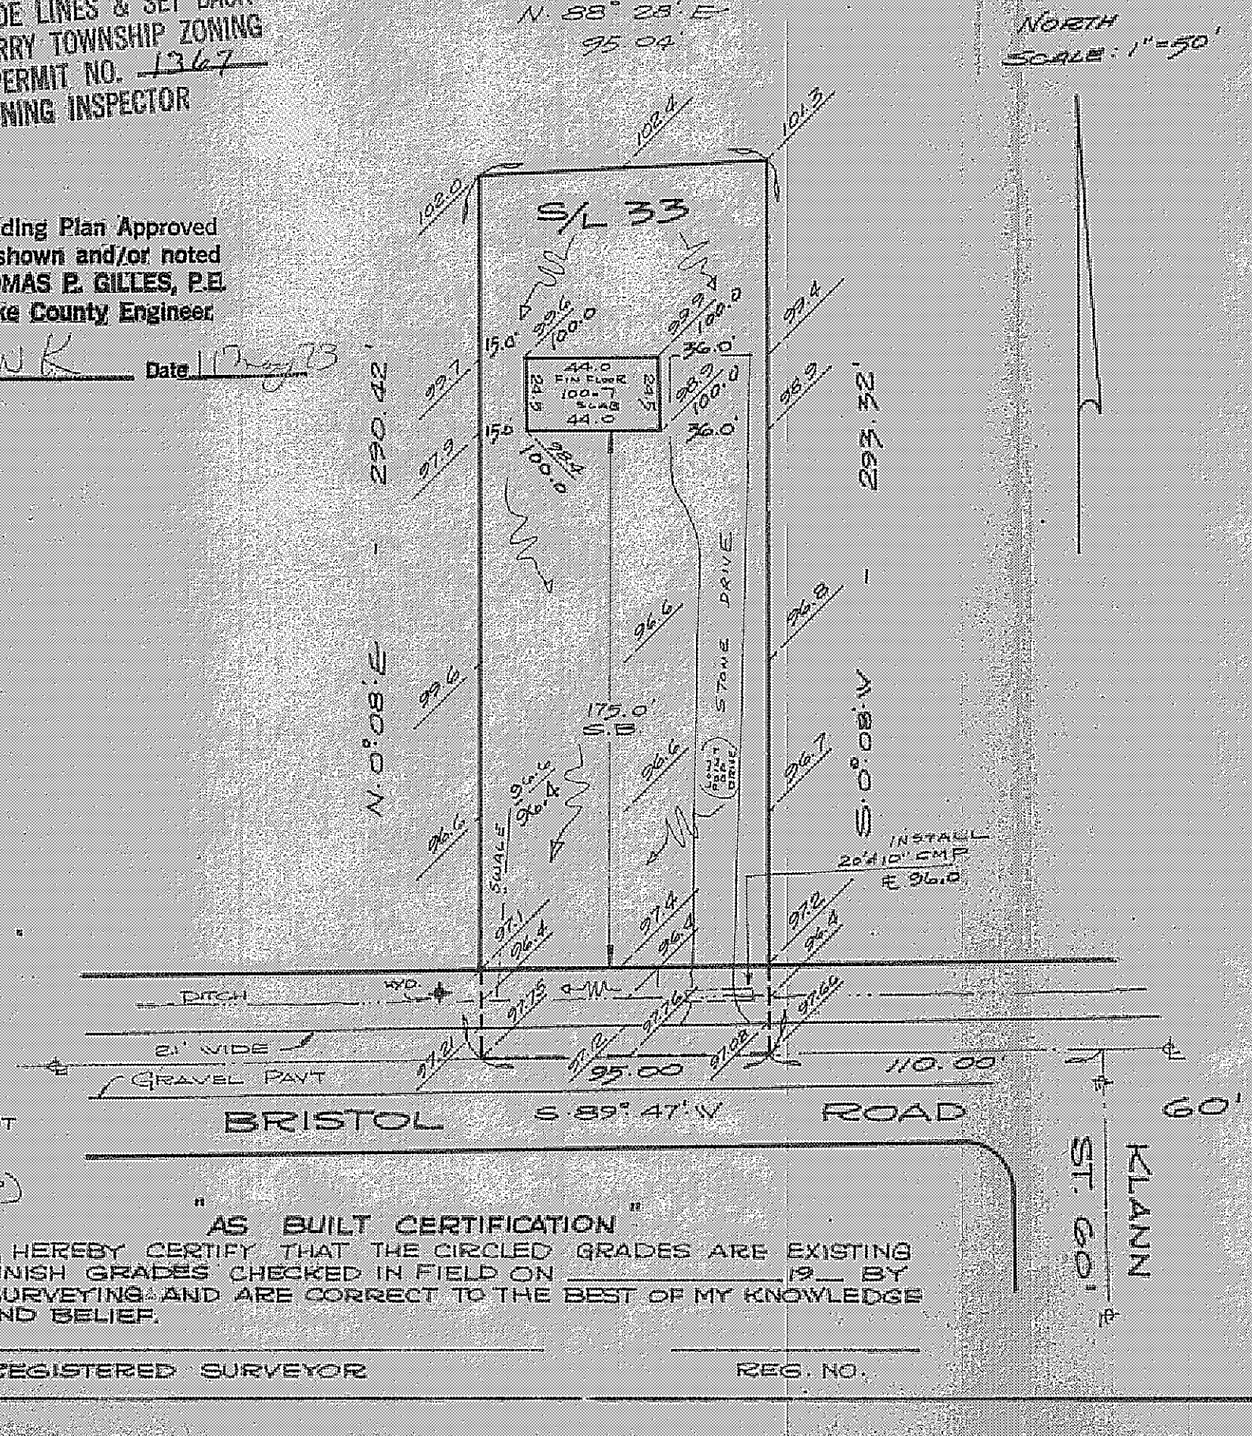
N. 88° 28' E.
95.04'
NORTH
SCALE: 1"=50'
S/L 33
102.4
101.3
100.0
99.4
99.3
99.2
99.1
97.9
96.8
96.6
96.4
96.7
97.4
97.2
97.1
96.9
96.7
96.4
96.6
96.4
96.4
96.4