SITE PLAN

FOR

JOE KOZLOWSKI

BEING S/L 6, WELLINGTON RIDGE ESTATES SUBDIVISION IN THE TOWNSHIP OF PERRY, COUNTY OF LAKE, STATE OF OHIO.

N

1" = 30'

CURVE DATA	①	②	③
RADIUS	630.00	30.00	330.00
CHORD	131.46	42.19	50.83
BEARING	S 38°40'15"E	S 72°58'19"E	N 71°09'02"E

LOW YIELD WATER FIXTURES REQUIRED ON ALL:

- Shower Head
- Toilet

SEWAGE DISPOSAL PERMIT MUST BE OBTAINED BY A LAKE COUNTY LICENSED INSTALLER BEFORE INSTALLATION IS STARTED.

Reviewed and Accepted
LAKE COUNTY GENERAL HEALTH DISTRICT
Date April 1 1991
JOEL LUCIA, R. S., M. P. H.
Health Commissioner
BY Nancy Nichols

A. To be brought to finished grade
1. Septic tank manhole covers
2. Splitter box cover
3. Distribution box cover

B. No footer drains or downspouts to be discharged into septic tanks

C. All waste water to be discharged into septic tanks

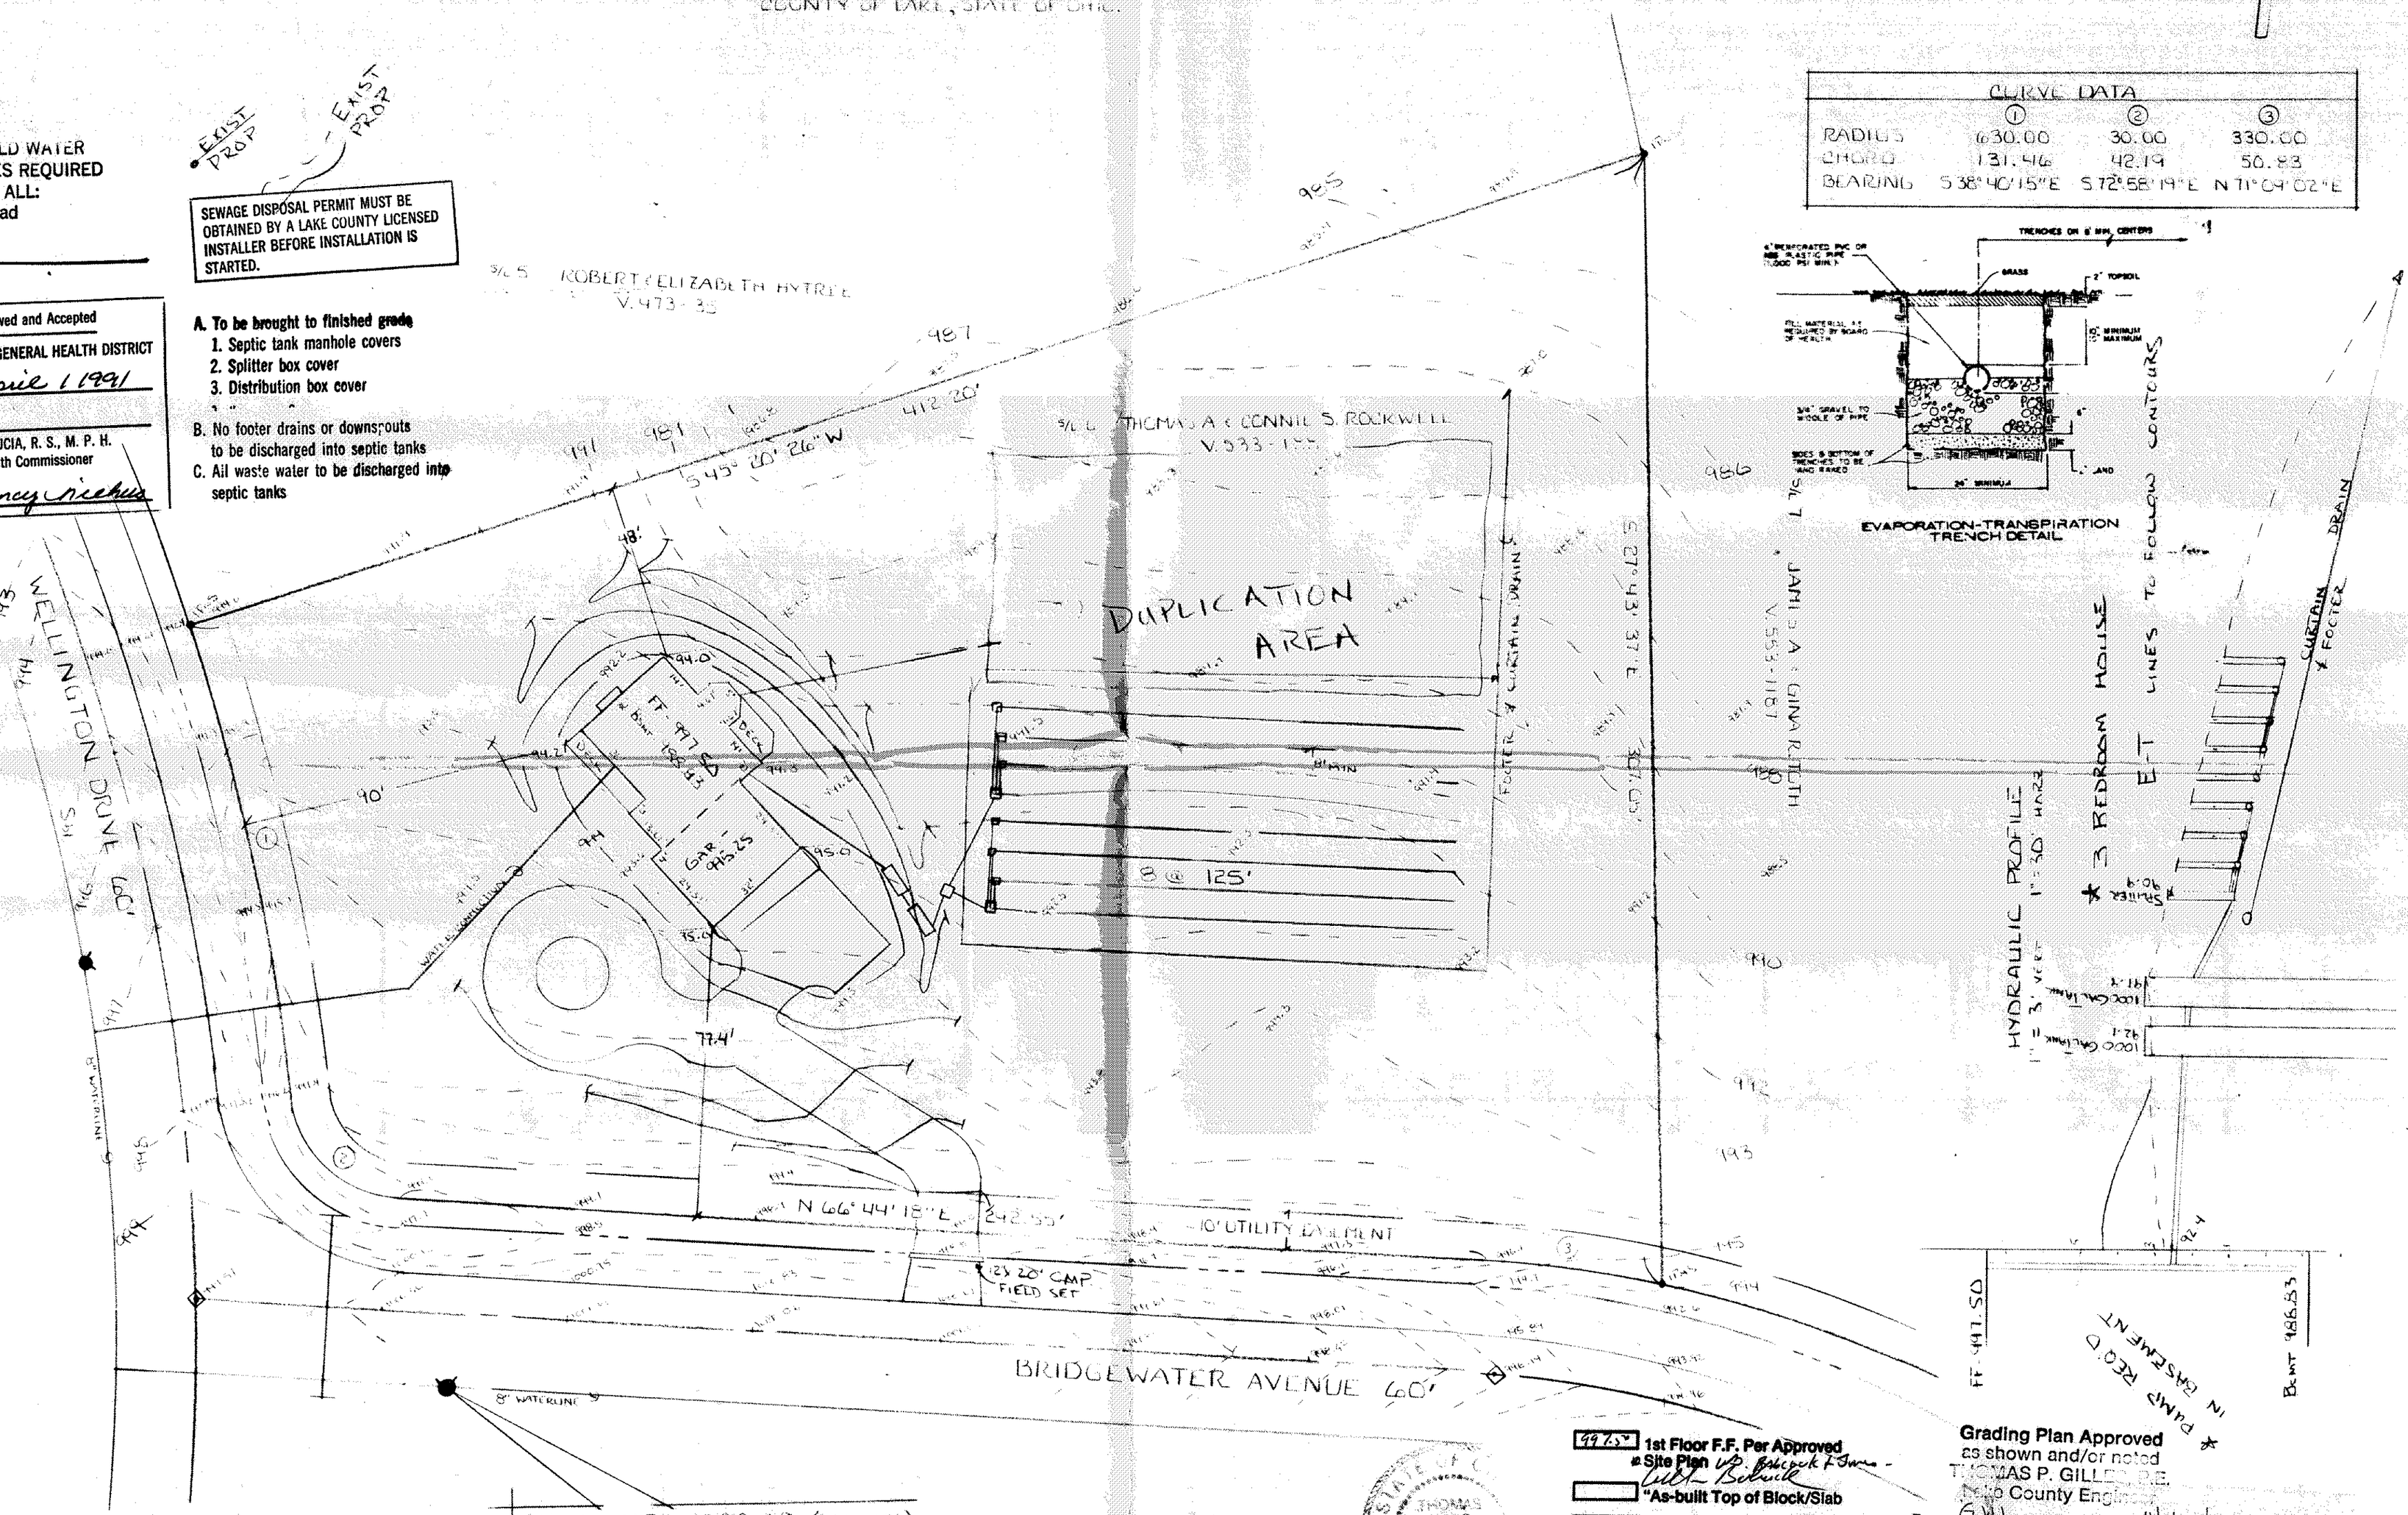

EVAPORATION-TRANSPIRATION TRENCH DETAIL

997.50 1st Floor F.F. Per Approved Site Plan W.D. Babcock & Sons - Wilt Babcock

"As-built Top of Block/Slab

1st Floor F.F. Per "As-built" Site plan

APPROVED
SIDE LINES & SET BACK
PERRY TOWNSHIP ZONING
PERMIT NO. 4454
ZONING INSPECTOR Don King

Grading Plan Approved as shown and/or noted
THOMAS P. GILLES, P.E.
Lake County Engineer
By GJH Date 4/2/91

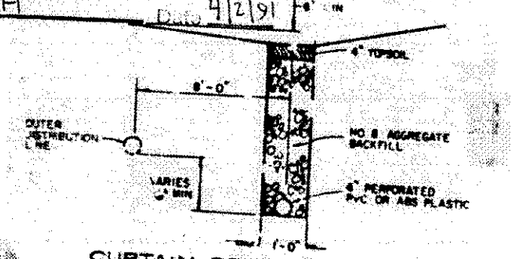

I, the undersigned hereby certify that this topography, indicated by 1' contours, and elevations shown hereon represent an actual field survey made by me on 3-11-91 and that the elevations were taken at appropriate intervals and that as of that date they existed as indicated hereon.

J M Coffman PS
No. 6857

STATE OF OHIO THOMAS MARC COFFMAN

VILLAGE SURVEYING CO.
202 THIRD STREET, FAIRPORT HARBOR, OHIO 44077
(216) 357-1359