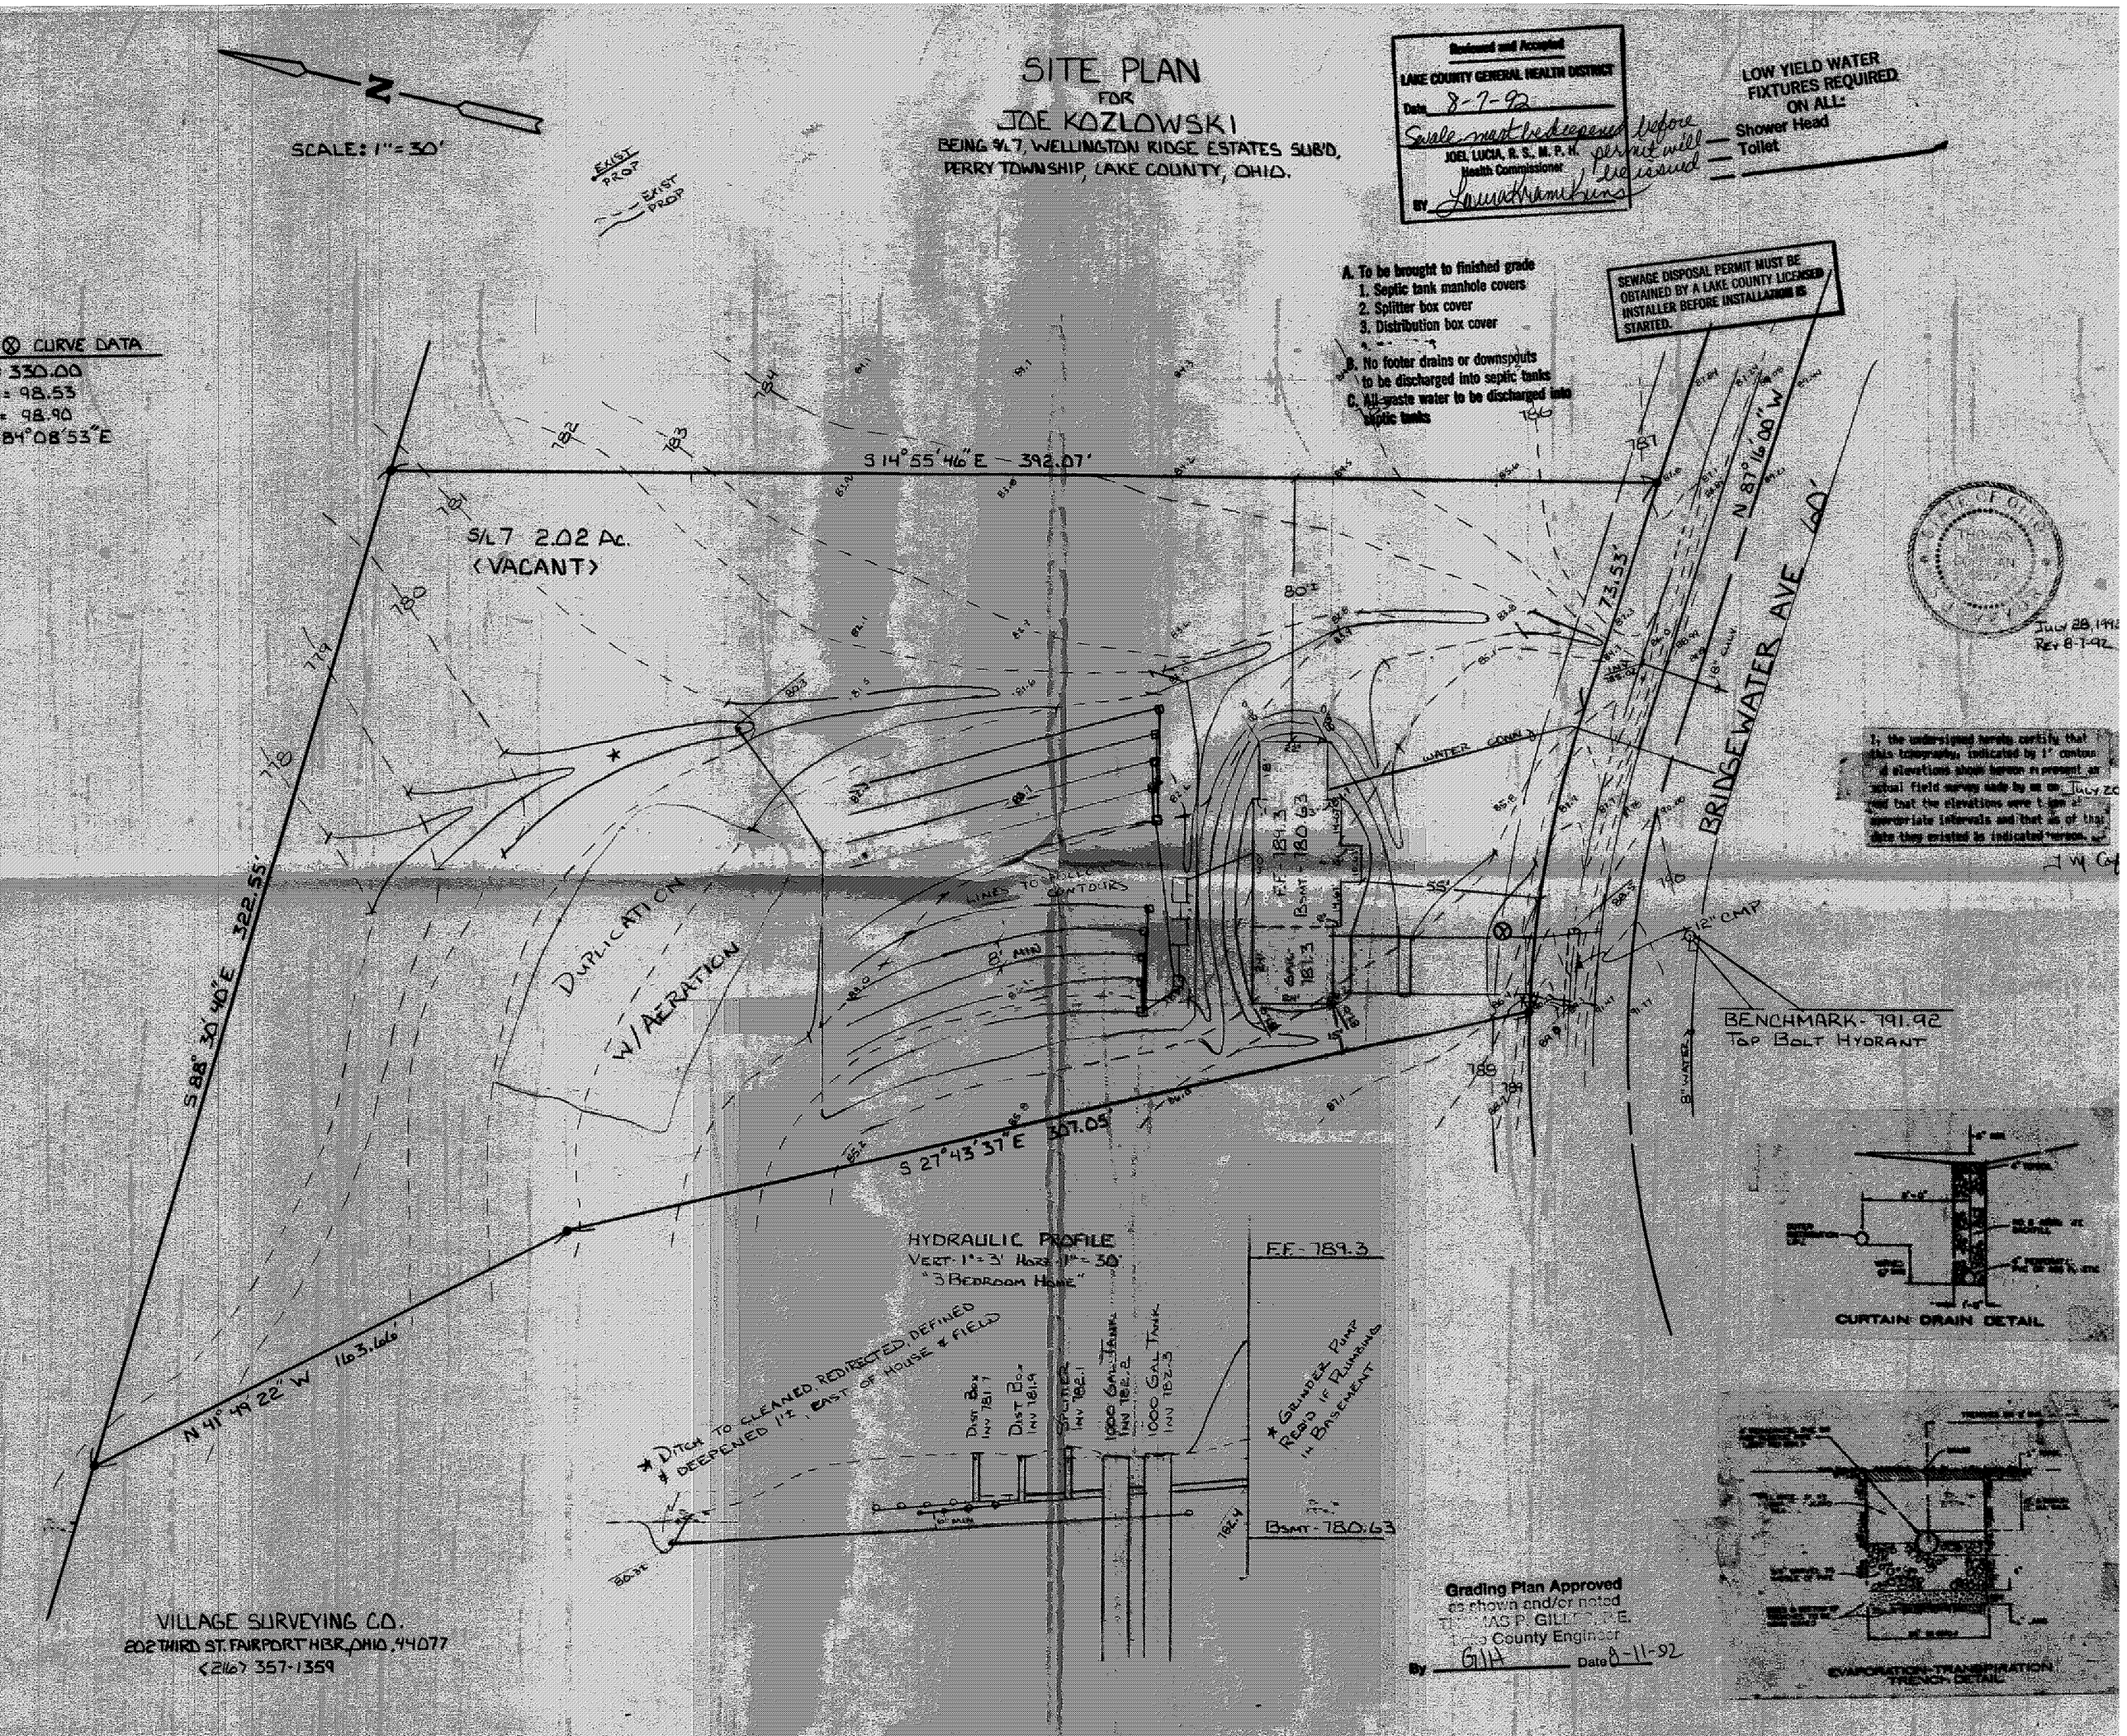
SITE PLAN
FOR
JOE KOZLOWSKI
BEING S/L 7, WELLINGTON RIDGE ESTATES SUB'D,
PERRY TOWNSHIP, LAKE COUNTY, OHIO.
Reviewed and Accepted
LAKE COUNTY GENERAL HEALTH DISTRICT
Date 8-7-92
Swale must be deepened before permit will be issued
JOEL LUCIA, R. S., M. P. H.
Health Commissioner
BY Laura Kramikuns
LOW YIELD WATER FIXTURES REQUIRED ON ALL:
Shower Head
Toilet
SEWAGE DISPOSAL PERMIT MUST BE OBTAINED BY A LAKE COUNTY LICENSED INSTALLER BEFORE INSTALLATION IS STARTED.
A. To be brought to finished grade
1. Septic tank manhole covers
2. Splitter box cover
3. Distribution box cover
B. No footer drains or downspouts to be discharged into septic tanks
C. All waste water to be discharged into septic tanks
SCALE: 1" = 30'
EXIST PROP
CURVE DATA
330.00
= 98.53
= 98.90
84°08'53"E
S 14°55'46"E 392.07'
S/L 7 2.02 Ac.
(VACANT)
N 87°16'00"W
73.53'
BRIDGEWATER AVE 60'
WATER CONN
LINES TO FOLLOW CONTOURS
DUPLICATION W/AERATION
S 88°30'40"E 322.55'
S 27°43'37"E 307.05'
N 41°49'22"W 163.66'
12" CMP
BENCHMARK - 791.92
TOP BOLT HYDRANT
HYDRAULIC PROFILE
VERT 1" = 3' HORZ 1" = 30'
"3 BEDROOM HOME"
F.F. - 789.3
BSMT - 780.63
* DITCH TO CLEANED, REDIRECTED, DEFINED & DEEPENED 1'± EAST OF HOUSE & FIELD
DIST BOX INV 781.7
DIST BOX INV 781.9
SPLITTER INV 782.1
1000 GAL TANK INV 782.2
1000 GAL TANK INV 782.3
* GRINDER PUMP REQ'D IF PLUMBING IN BASEMENT
CURTAIN DRAIN DETAIL
EVAPORATION-TRANSPIRATION TRENCH DETAIL
JULY 28, 1992
REV 8-7-92
I, the undersigned hereby certify that this topography, indicated by 1' contour elevations shown hereon represent an actual field survey made by me on July 20 and that the elevations were taken at appropriate intervals and that as of that date they existed as indicated hereon.
Grading Plan Approved
as shown and/or noted
THOMAS P. GILLES, P.E.
Lake County Engineer
By GJH Date 8-11-92
VILLAGE SURVEYING CO.
202 THIRD ST. FAIRPORT HBR, OHIO 44077
(216) 357-1359