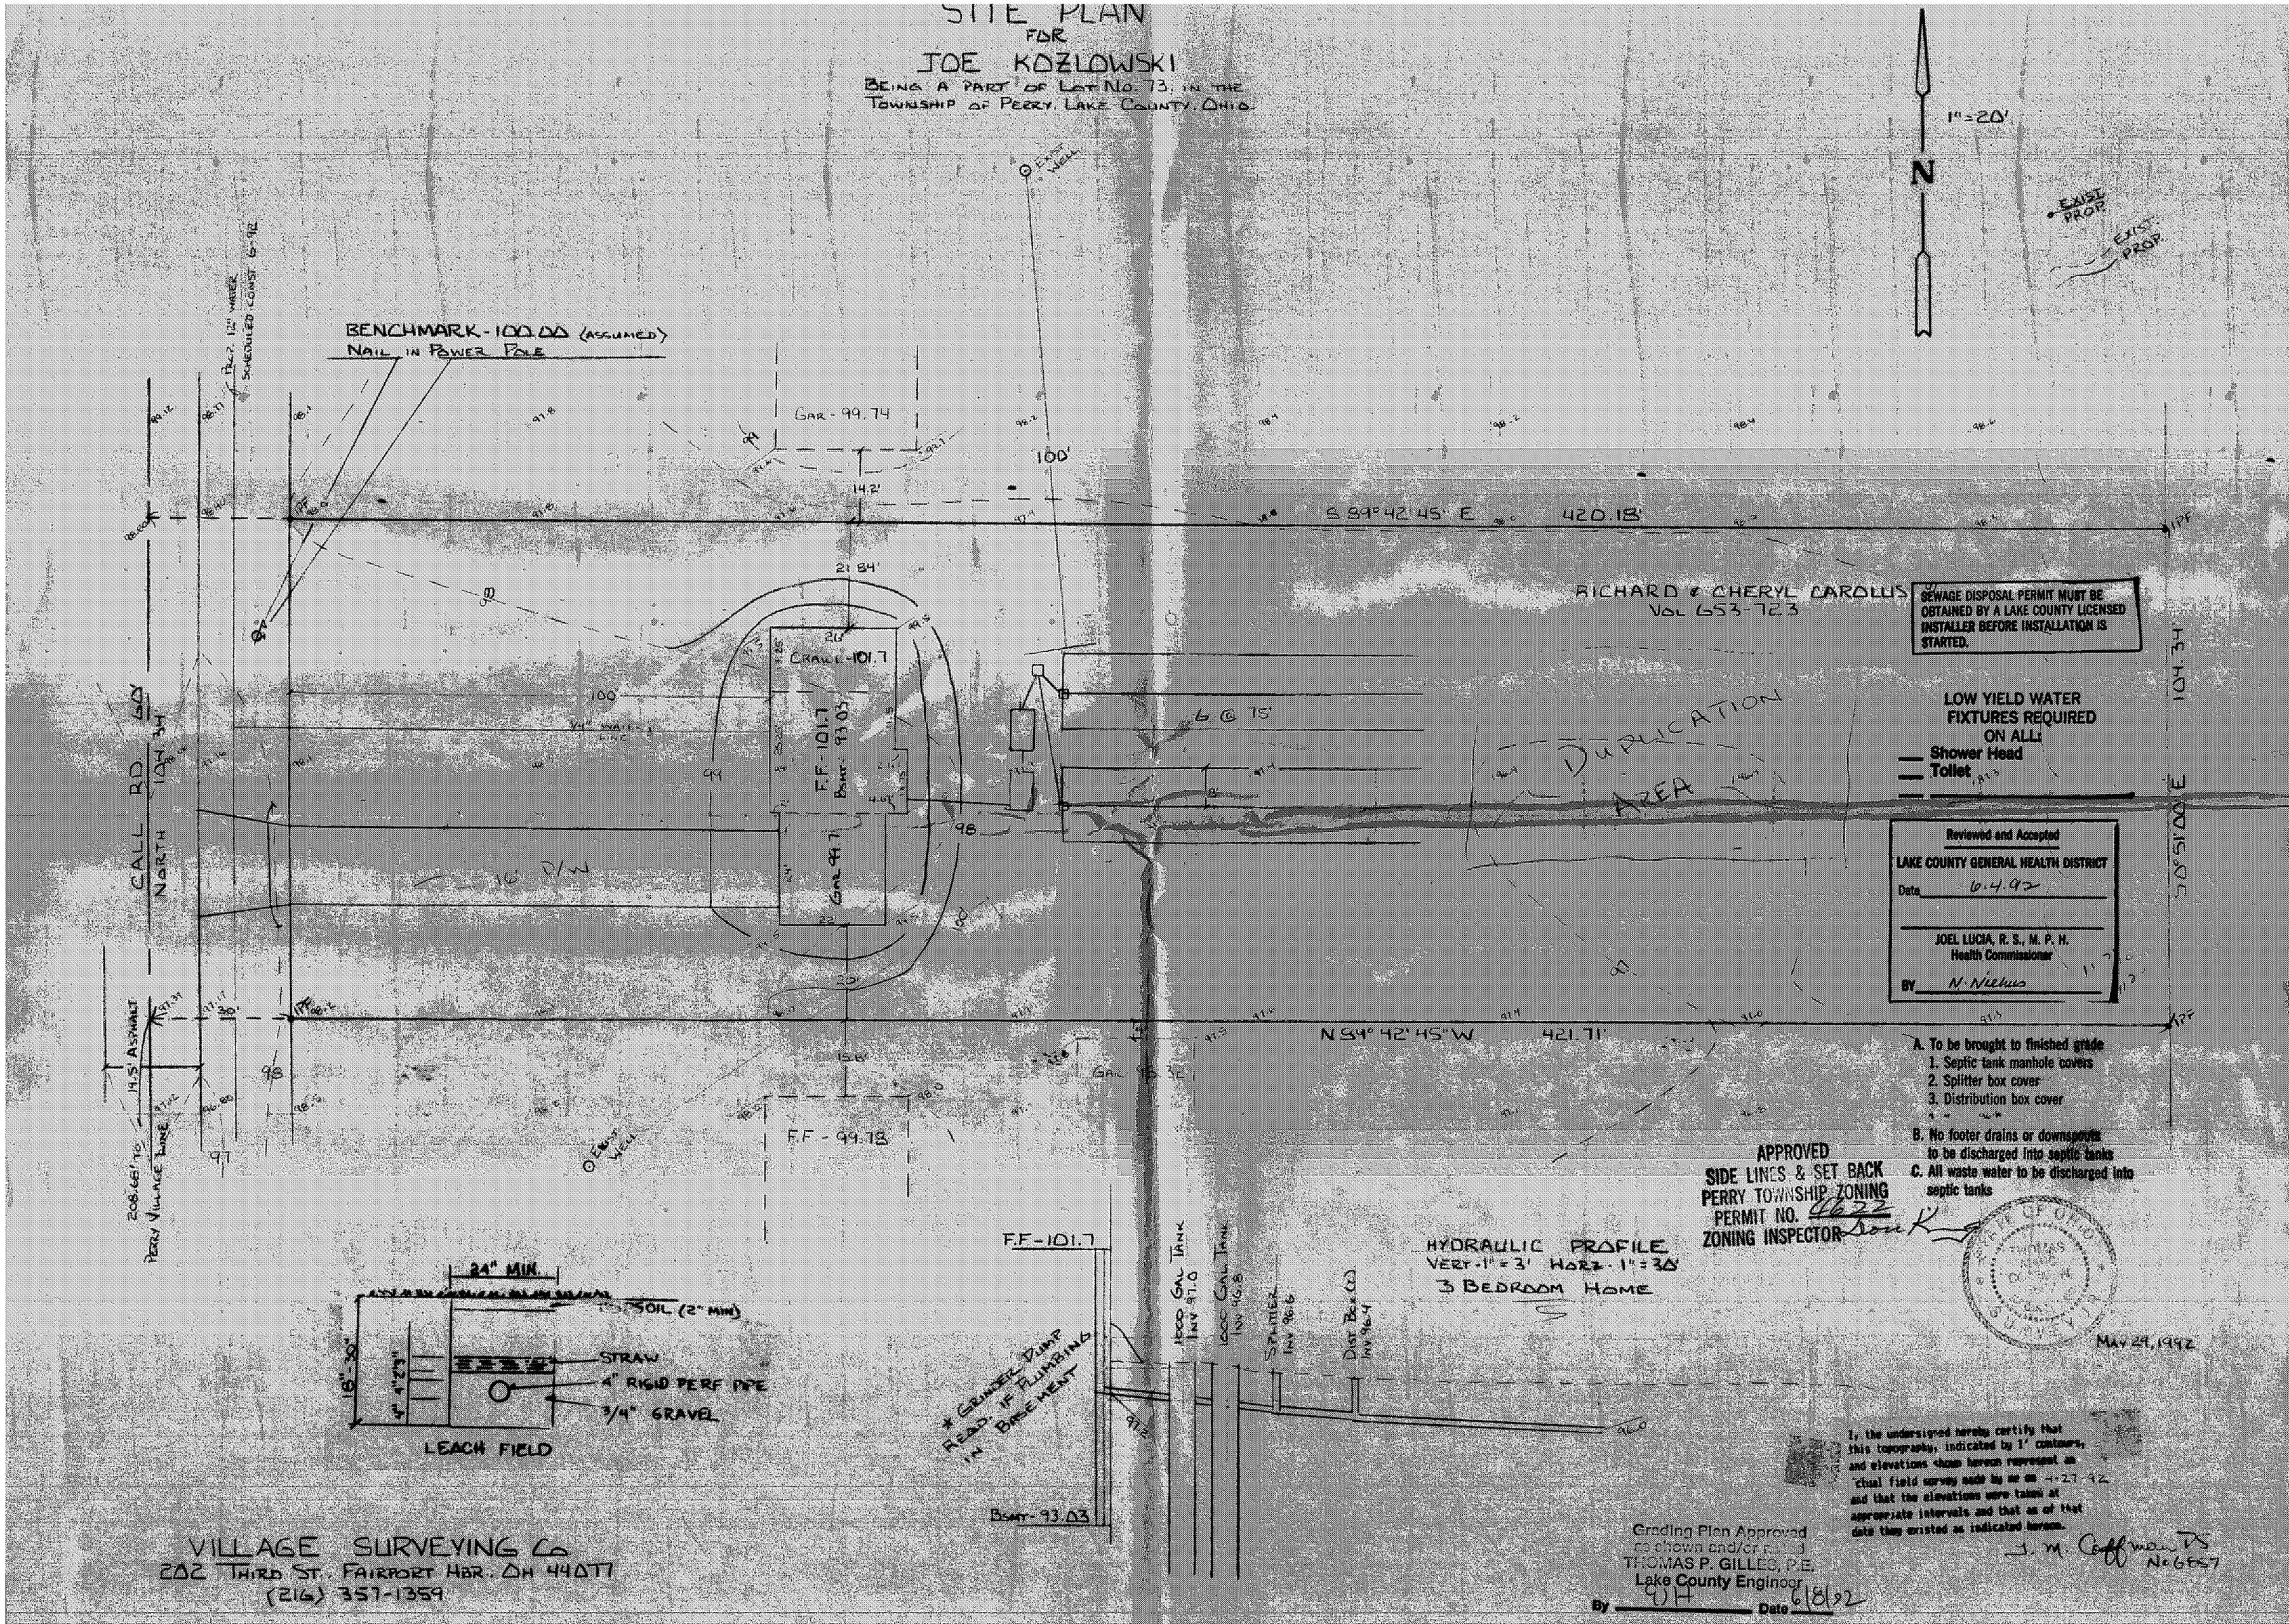
SITE PLAN
FOR
JOE KOZLOWSKI
BEING A PART OF LOT NO. 73, IN THE TOWNSHIP OF PERRY, LAKE COUNTY, OHIO.
1" = 20'
N
EXIST. PROP.
EXIST. PROP.
BENCHMARK - 100.00 (ASSUMED)
NAIL IN POWER POLE
PROP. 12" WATER SCHEDULED CONST. 6-92
GAR - 99.74
100'
14.2'
S 89° 42' 45" E 420.18'
21.84'
CRAWL - 101.7
F.F. - 101.7
BSMT - 93.03
GAR 99.7
6 @ 75'
DUPLICATION AREA
RICHARD & CHERYL CAROLUS
VOL 653-723
SEWAGE DISPOSAL PERMIT MUST BE OBTAINED BY A LAKE COUNTY LICENSED INSTALLER BEFORE INSTALLATION IS STARTED.
LOW YIELD WATER FIXTURES REQUIRED ON ALL:
Shower Head
Toilet
Reviewed and Accepted
LAKE COUNTY GENERAL HEALTH DISTRICT
Date 6.4.92
JOEL LUCIA, R. S., M. P. H.
Health Commissioner
BY N. Niehus
CALL RD. 60'
NORTH 104.34'
14.5' ASPHALT
208.68' TO PERRY VILLAGE LINE
16' D/W
N 89° 42' 45" W 421.71'
F.F. - 99.78
EXIST. WELL
A. To be brought to finished grade
1. Septic tank manhole covers
2. Splitter box cover
3. Distribution box cover
B. No footer drains or downspouts to be discharged into septic tanks
C. All waste water to be discharged into septic tanks
APPROVED
SIDE LINES & SET BACK
PERRY TOWNSHIP ZONING
PERMIT NO. 4622
ZONING INSPECTOR
MAY 29, 1992
24" MIN.
SOIL (2" MIN)
STRAW
4" RIGID PERF PIPE
3/4" GRAVEL
18"-30"
LEACH FIELD
F.F. - 101.7
BSMT - 93.03
* GRINDER PUMP REQD. IF PLUMBING IN BASEMENT
1000 GAL TANK INV 97.0
1000 GAL TANK INV 96.8
SPLITTER INV 96.6
DIST BOX (2) INV 96.4
HYDRAULIC PROFILE
VERT - 1" = 3' HORZ - 1" = 30'
3 BEDROOM HOME
I, the undersigned hereby certify that this topography, indicated by 1' contours, and elevations shown hereon represent an actual field survey made by me on 4-27-92 and that the elevations were taken at appropriate intervals and that as of that date they existed as indicated hereon.
J. M. Coffman PS No 6857
Grading Plan Approved as shown and/or noted
THOMAS P. GILLES, P.E.
Lake County Engineer
By GH Date 6/8/92
VILLAGE SURVEYING Co
202 THIRD ST. FAIRPORT HBR. OH 44077
(216) 357-1359