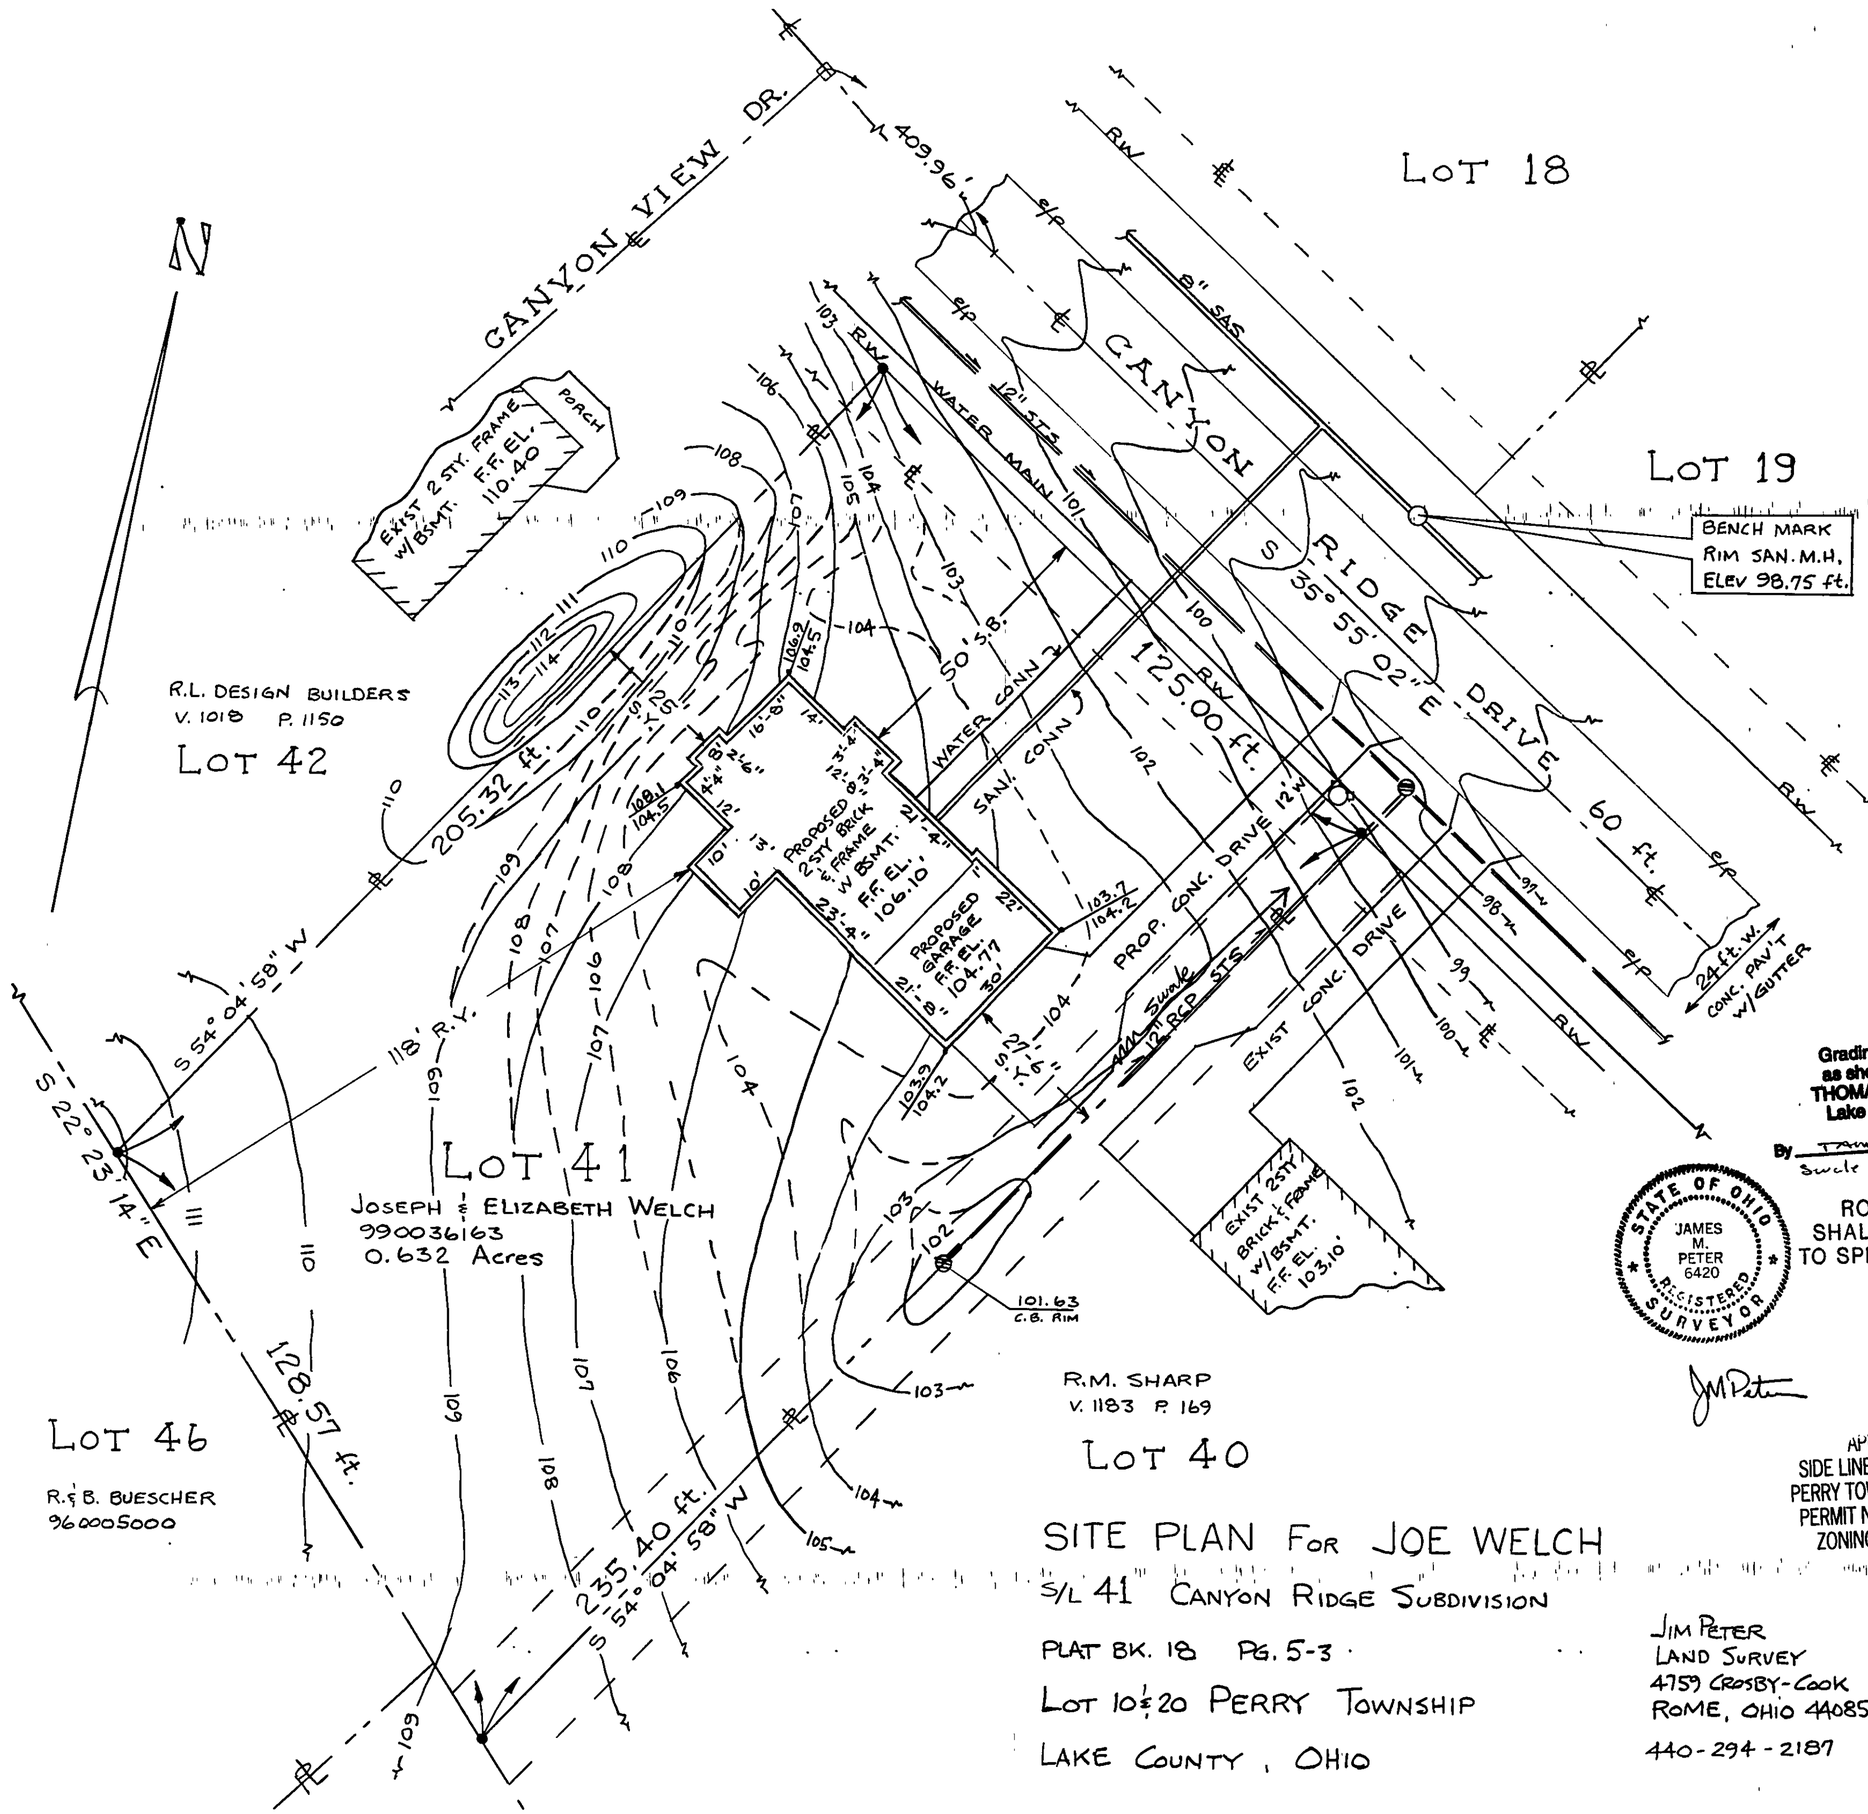

Grading Plan Approved as shown and/or noted
THOMAS P. GILLES, P.E.
Lake County Engineer
By TGM Date 11/5/99
Swale as Shown

STATE OF OHIO
JAMES M. PETER
6420
REGISTERED SURVEYOR

JM Peter

ROOF DRAINS SHALL DISCHARGE TO SPLASH BLOCKS.

APPROVED
SIDE LINES & SET BACK
PERRY TOWNSHIP ZONING
PERMIT NO. 6917
ZONING INSPECTOR

SITE PLAN FOR JOE WELCH

S/L 41 CANYON RIDGE SUBDIVISION

PLAT BK. 18 PG. 5-3

LOT 10 & 20 PERRY TOWNSHIP

LAKE COUNTY, OHIO

JIM PETER
LAND SURVEY
4759 CROSBY-COOK
ROME, OHIO 44085
440-294-2187