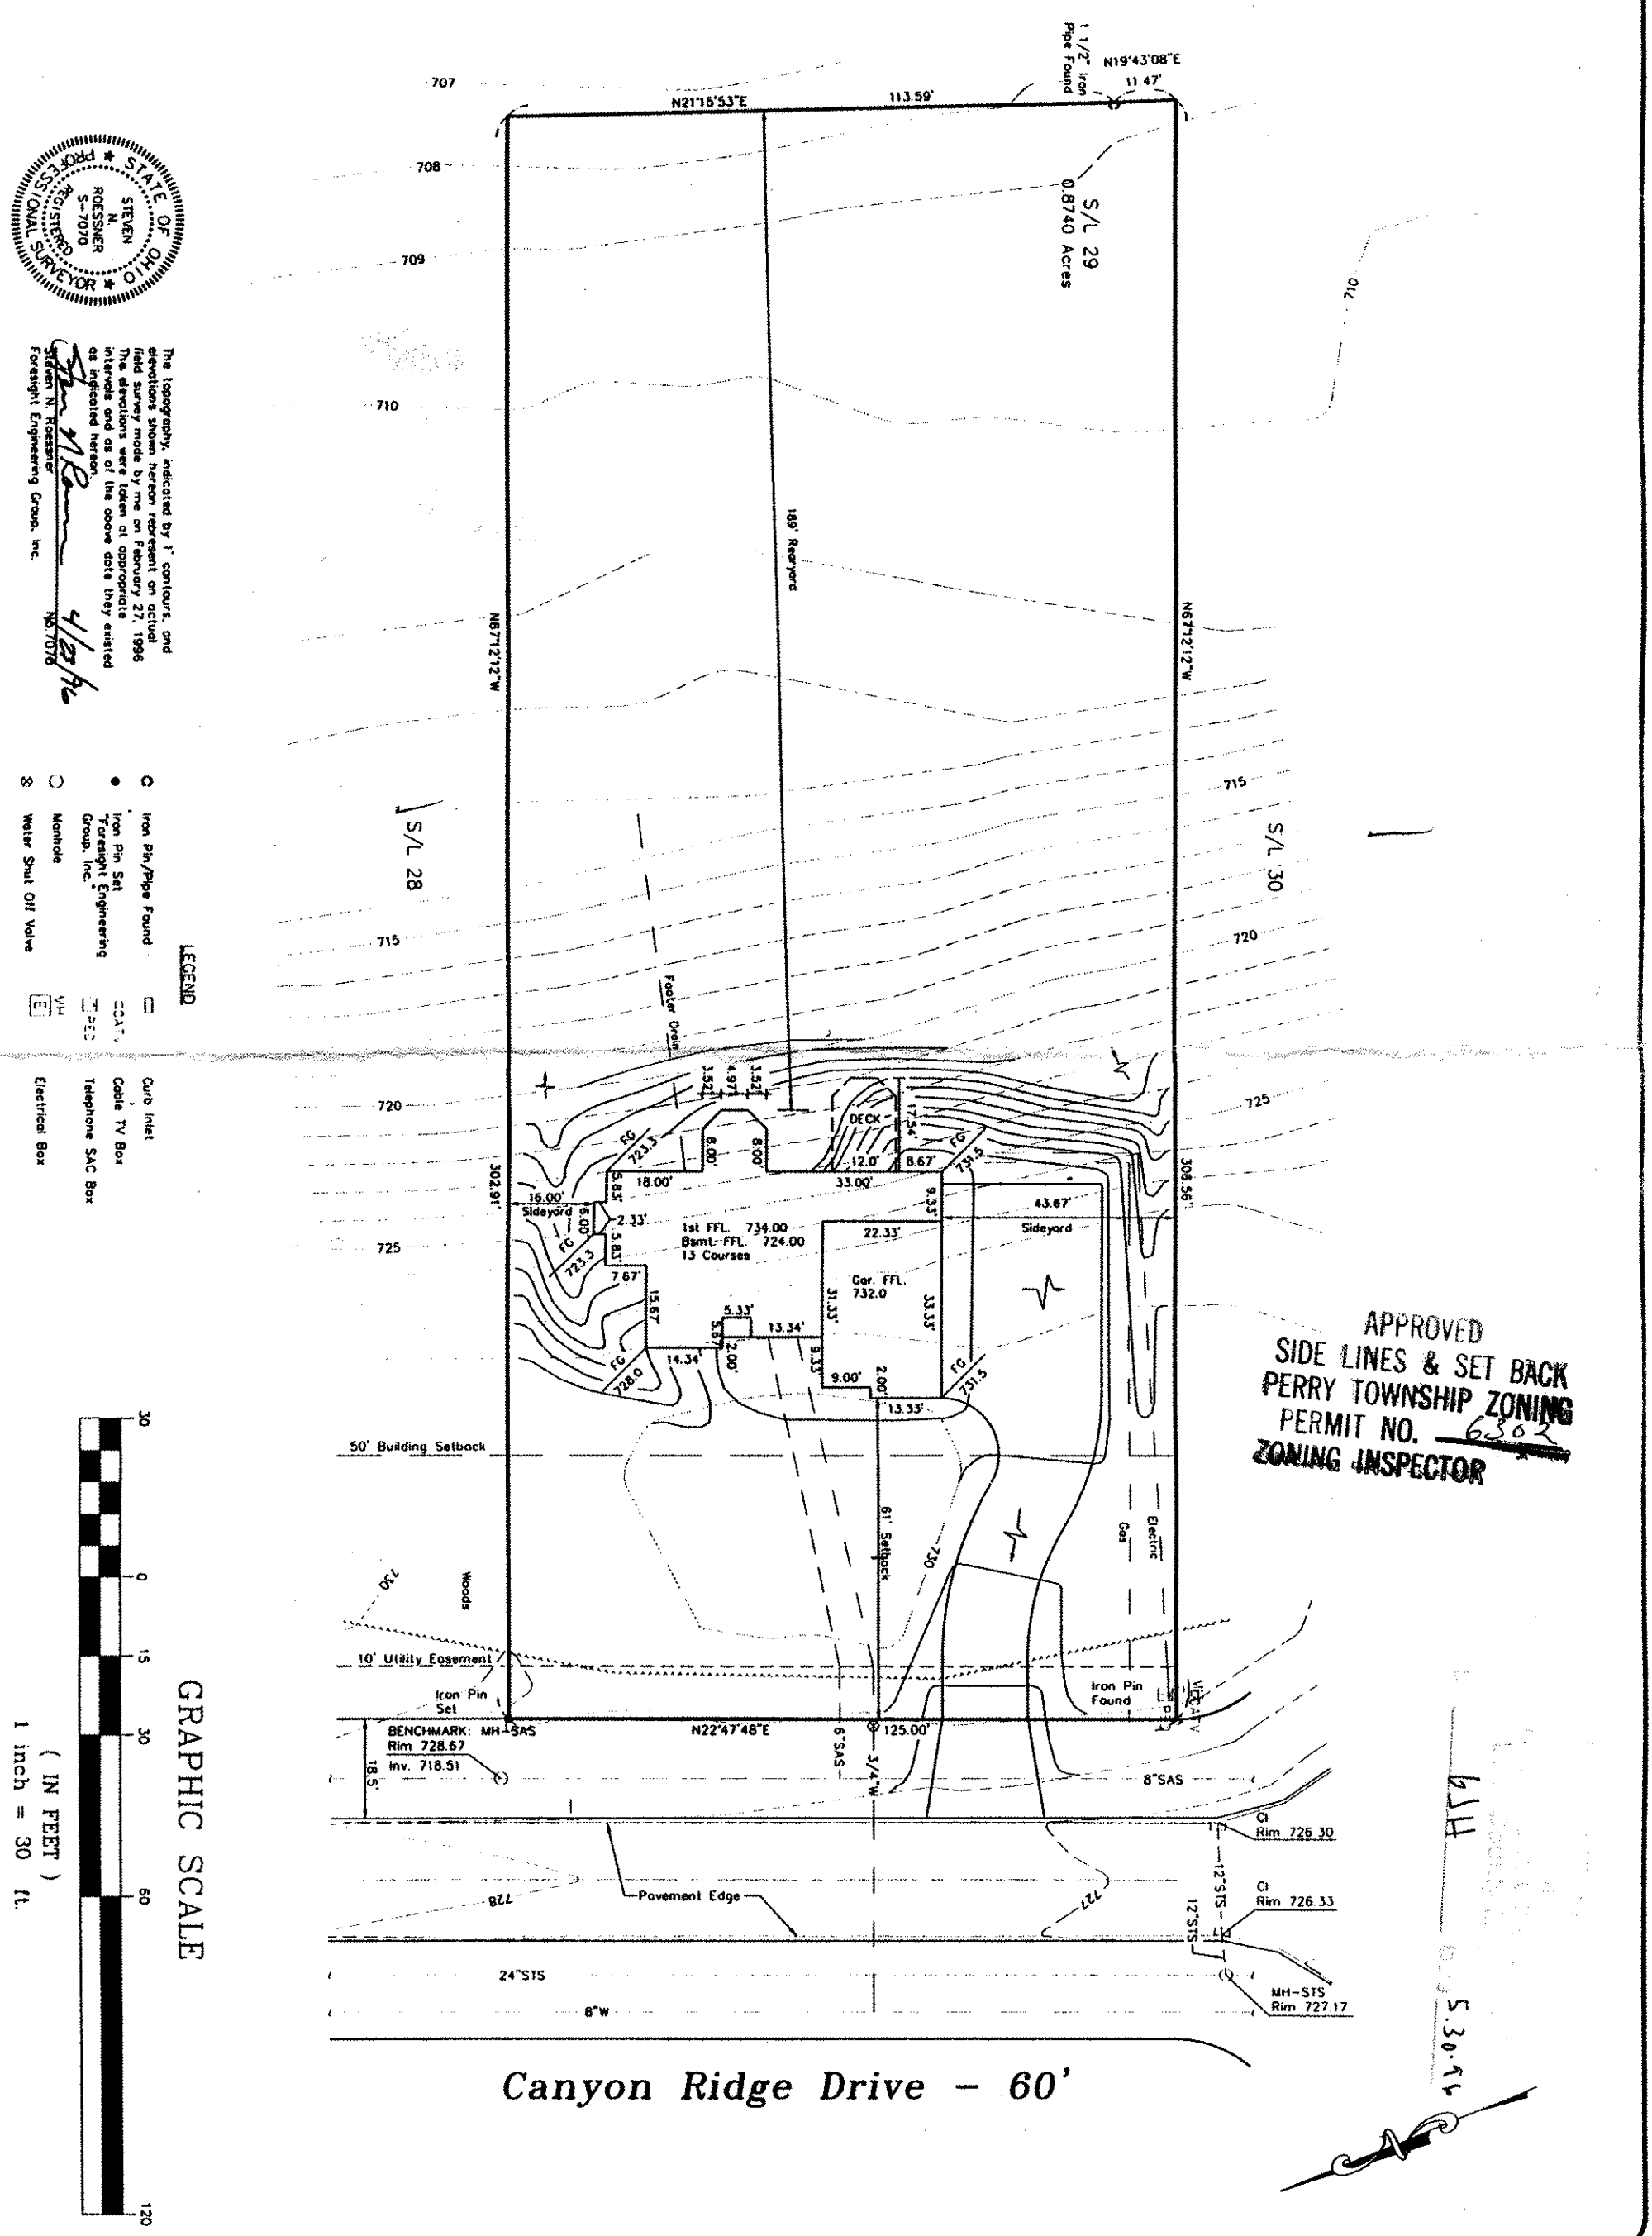

BETTER BUILDERS, INC
Canyon Ridge Subdivision - S/L 29
Perry - Lake County - Ohio
Site Plan

REVISIONS: Raise house elevation & move house back 11'. (61') setback, per Better Builders 4 23 96

SCALE : Horz. 1"=30' Vert. NONE

FILE NAME: E:\BLT2960B\10PO

DATE April 10, 1996

Foresight Engineering Group
Engineers & Surveyors