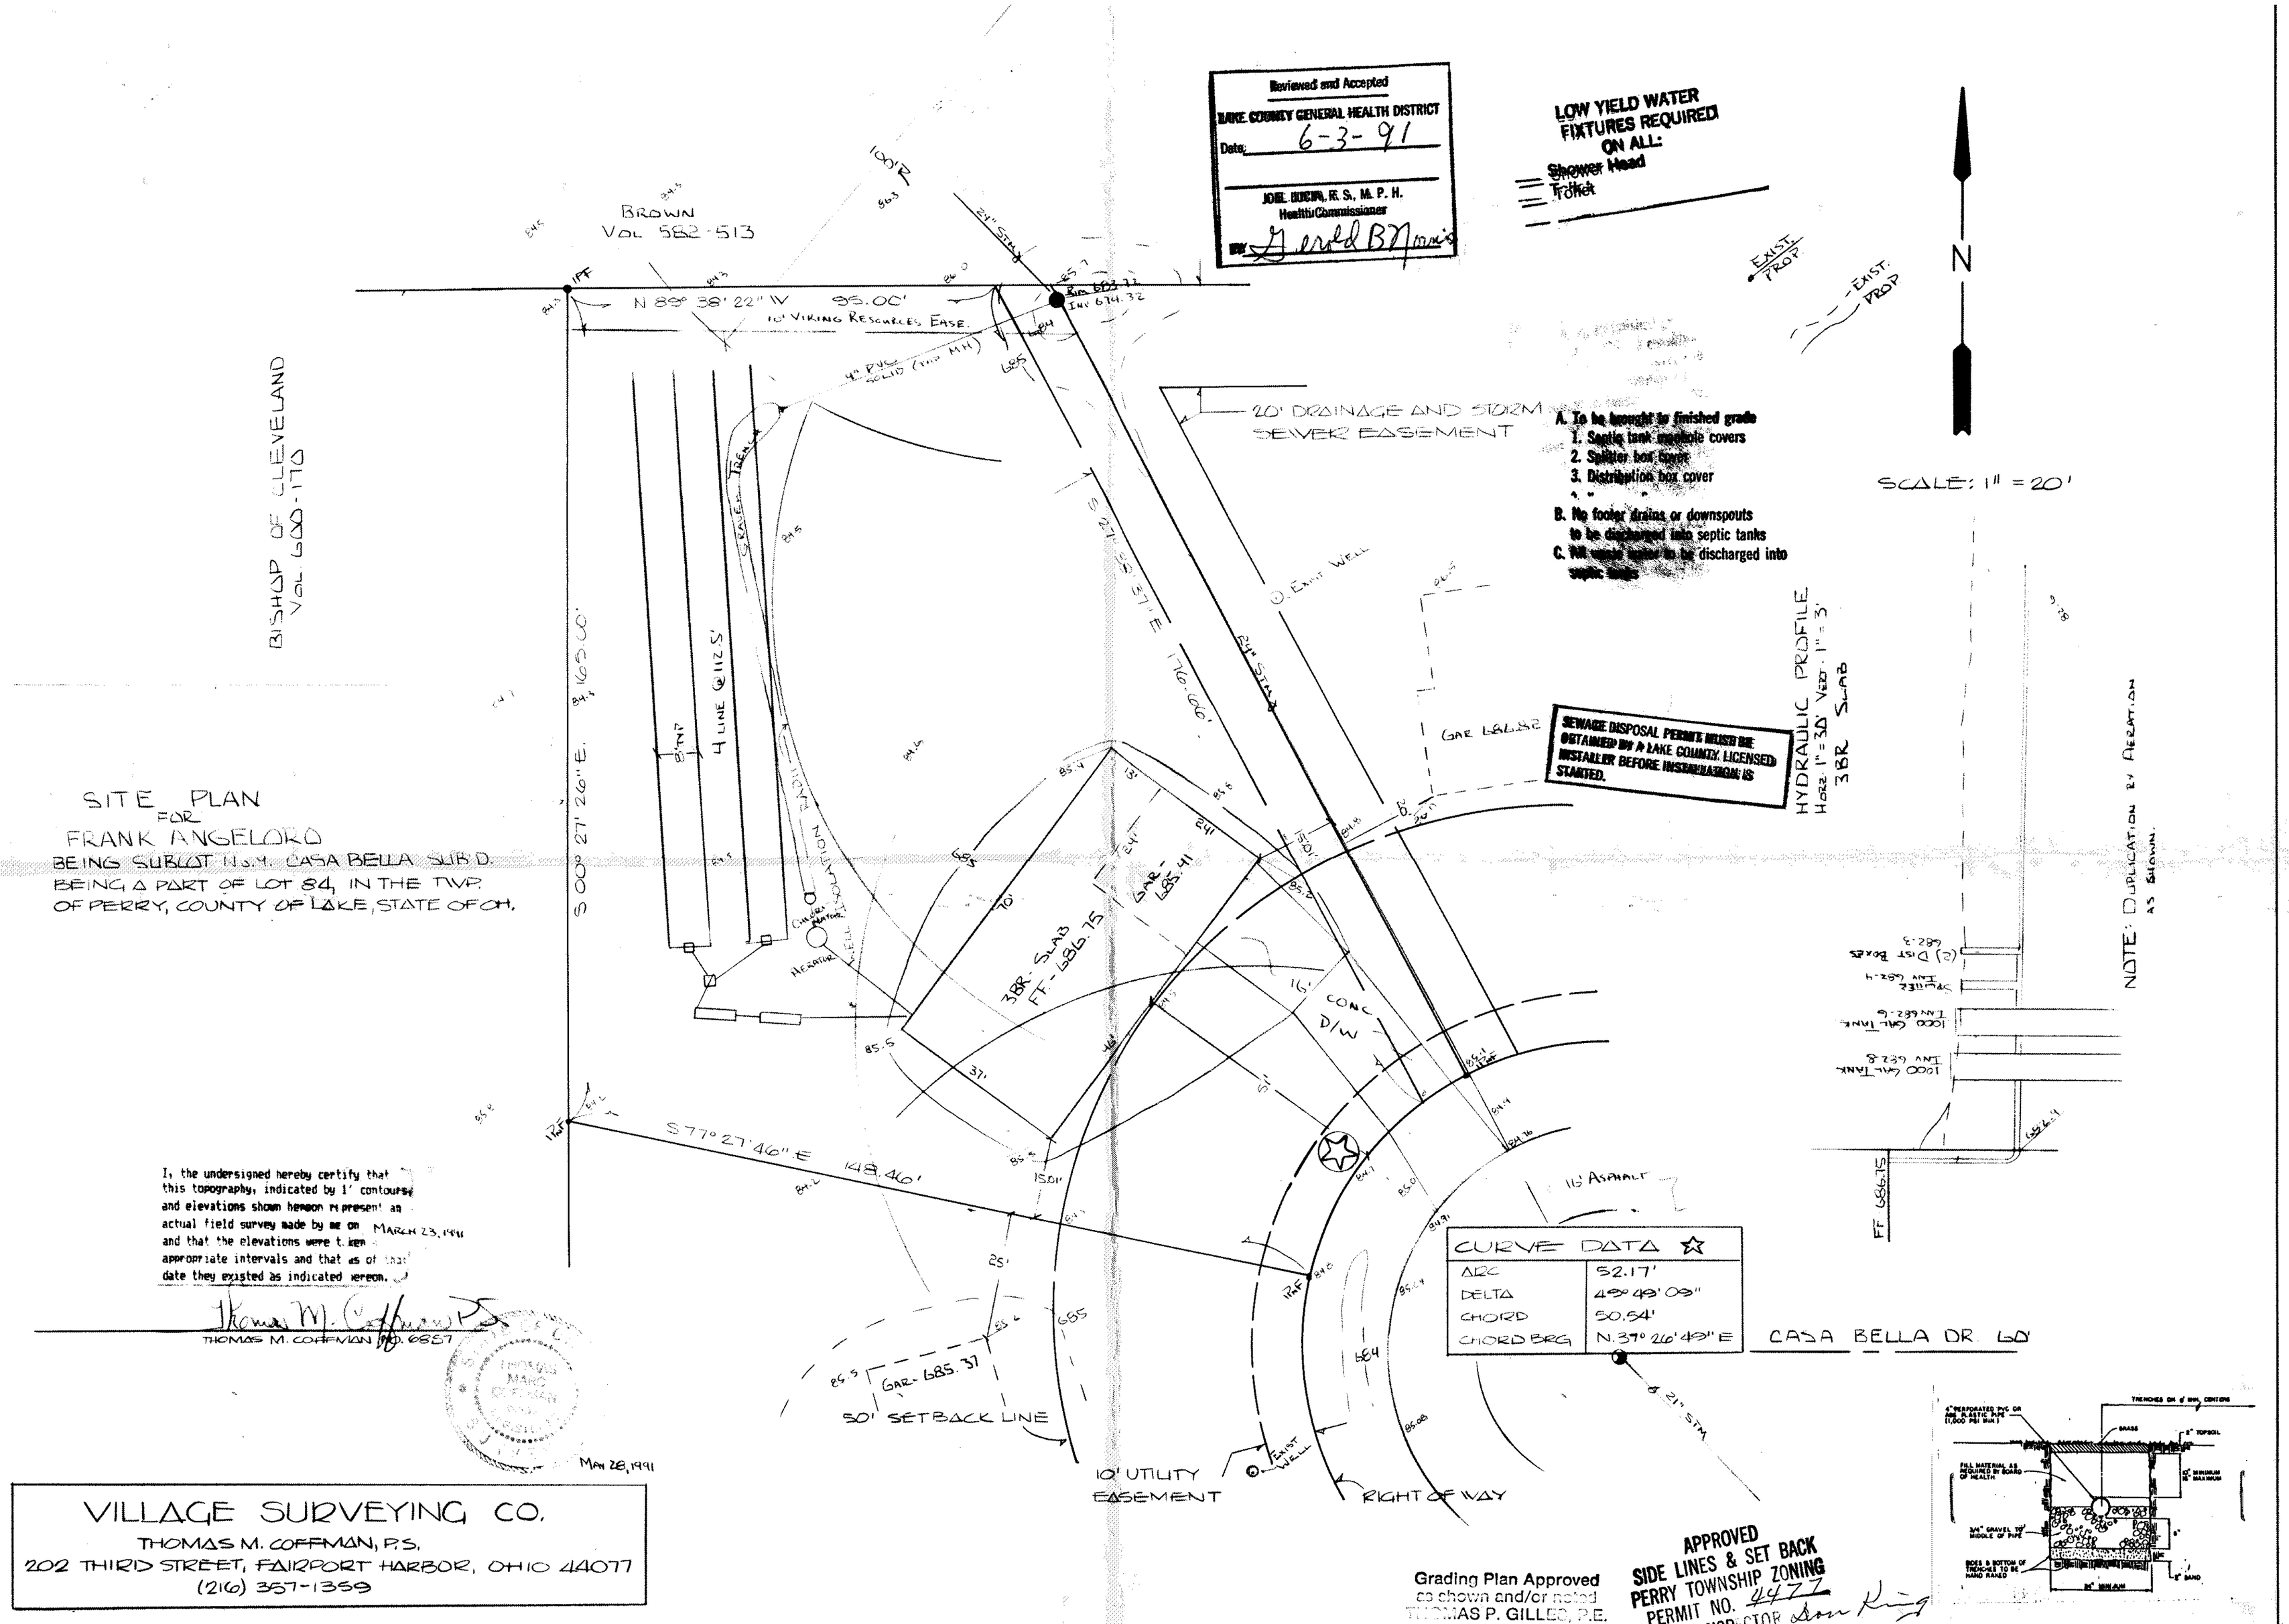

SITE PLAN
FOR
FRANK ANGELORO
BEING SUBLOT No. 4. CASA BELLA SUB'D.
BEING A PART OF LOT 84, IN THE TWP.
OF PERRY, COUNTY OF LAKE, STATE OF OH.

I, the undersigned hereby certify that this topography, indicated by 1' contours and elevations shown hereon represent an actual field survey made by me on MARCH 23, 1991 and that the elevations were taken appropriate intervals and that as of that date they existed as indicated hereon.

Thomas M. Coffman P.S.
THOMAS M. COFFMAN NO. 6857

MAY 28, 1991

CURVE DATA ☆	
ARC	52.17'
DELTA	49° 49' 09"
CHORD	50.54'
CHORD BRG	N. 37° 26' 49" E

VILLAGE SURVEYING CO.
THOMAS M. COFFMAN, P.S.
202 THIRD STREET, FAIRPORT HARBOR, OHIO 44077
(216) 357-1359

Grading Plan Approved as shown and/or noted
THOMAS P. GILLES, P.E.
Lake County Engineer
By GJH Date 6/5/91

APPROVED
SIDE LINES & SET BACK
PERRY TOWNSHIP ZONING
PERMIT NO. 4477
ZONING INSPECTOR Don King

MINIMUM 12" DRIVE CULVERT

BRUNING 44-232 71376