Grading Plan Approved
as shown and/or noted
THOMAS P. GILLES, P.E.
Lake County Engineer
By GJH Date 4/5/91
12" DRIVE CULVERT

SITE PLAN
FOR
ANGELORO CONST.

BEING S/L 5, CASA BELLA SUBDIVISION IN THE TOWNSHIP OF PERRY, COUNTY OF LAKE, STATE OF OHIO.

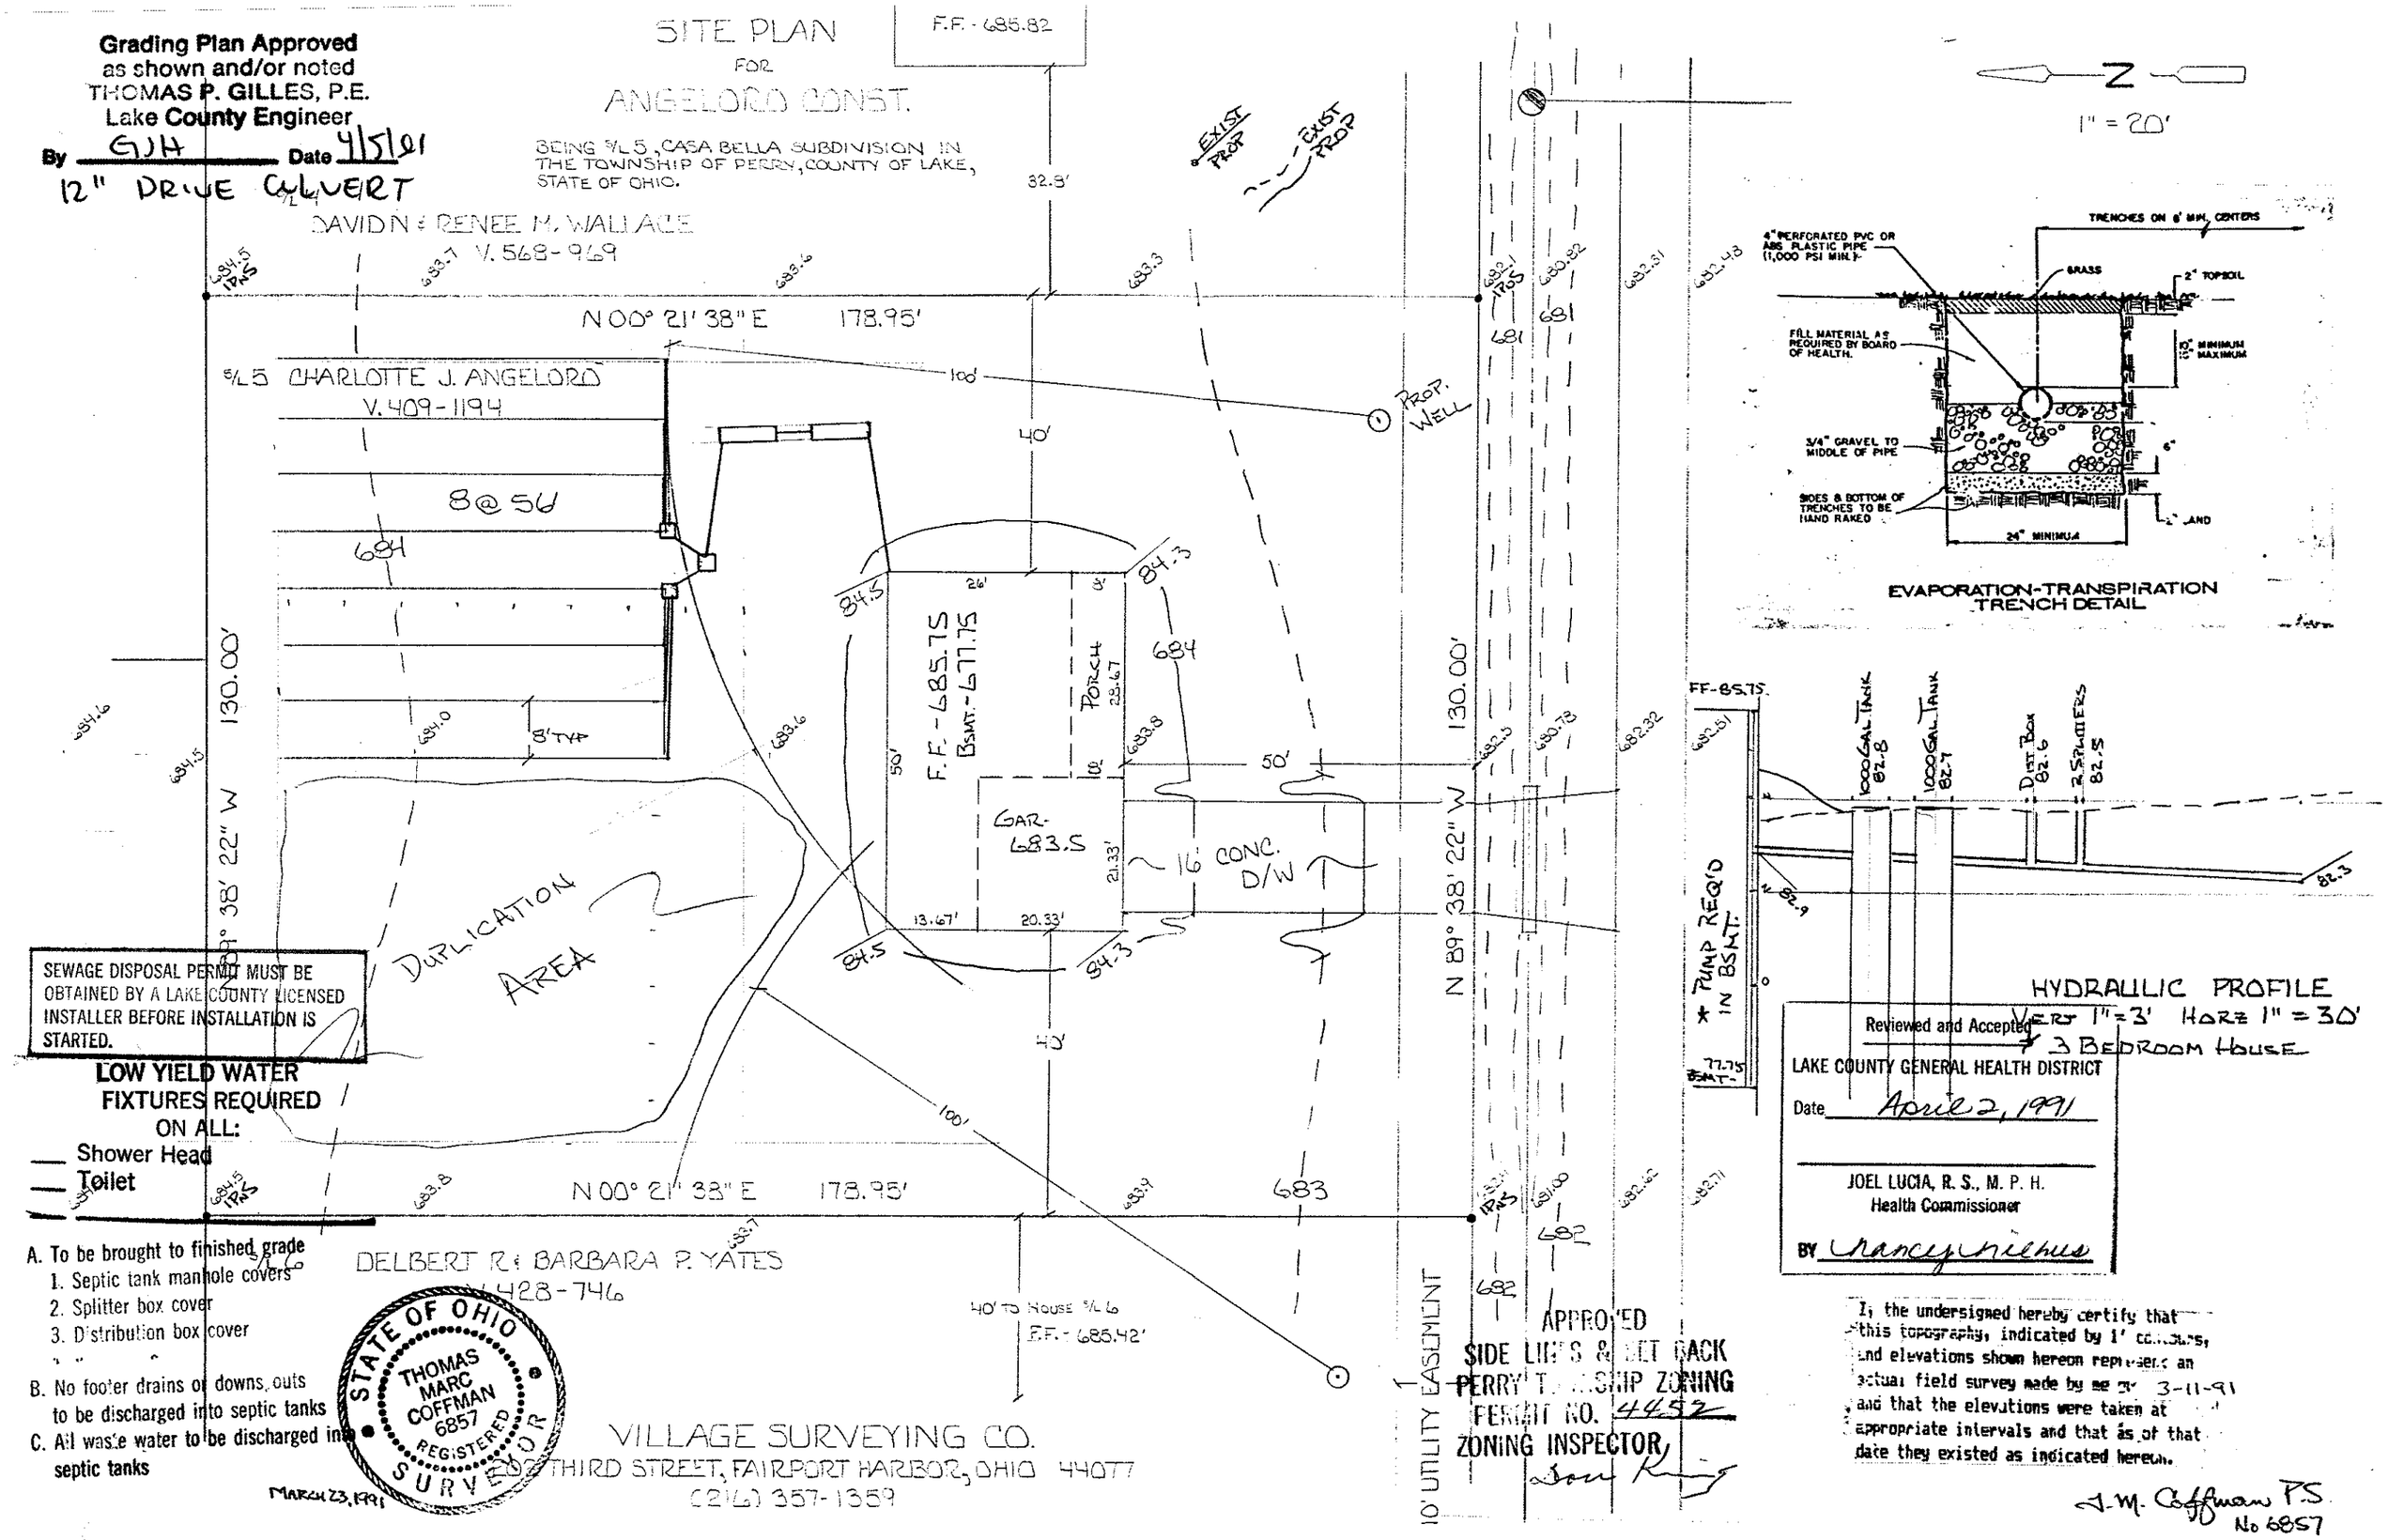

SEWAGE DISPOSAL PERMIT MUST BE OBTAINED BY A LAKE COUNTY LICENSED INSTALLER BEFORE INSTALLATION IS STARTED.

LOW YIELD WATER FIXTURES REQUIRED ON ALL:
___ Shower Head
___ Toilet

A. To be brought to finished grade
1. Septic tank manhole covers
2. Splitter box cover
3. Distribution box cover

B. No footer drains or downspouts to be discharged into septic tanks
C. All waste water to be discharged into septic tanks

STATE OF OHIO
THOMAS MARC COFFMAN 6857
REGISTERED SURVEYOR
MARCH 23, 1991

VILLAGE SURVEYING CO.
203 THIRD STREET, FAIRPORT HARBOR, OHIO 44077
(216) 357-1359

APPROVED
SIDE LINES & SET BACK
PERRY TOWNSHIP ZONING
PERMIT NO. 4452
ZONING INSPECTOR

Reviewed and Accepted
LAKE COUNTY GENERAL HEALTH DISTRICT
Date April 2, 1991
JOEL LUCIA, R. S., M. P. H.
Health Commissioner
BY Nancy Nichols

I, the undersigned hereby certify that this topography, indicated by 1' contours, and elevations shown hereon represents an actual field survey made by me on 3-11-91 and that the elevations were taken at appropriate intervals and that as of that date they existed as indicated hereon.

T. M. Coffman P.S.
No 6857