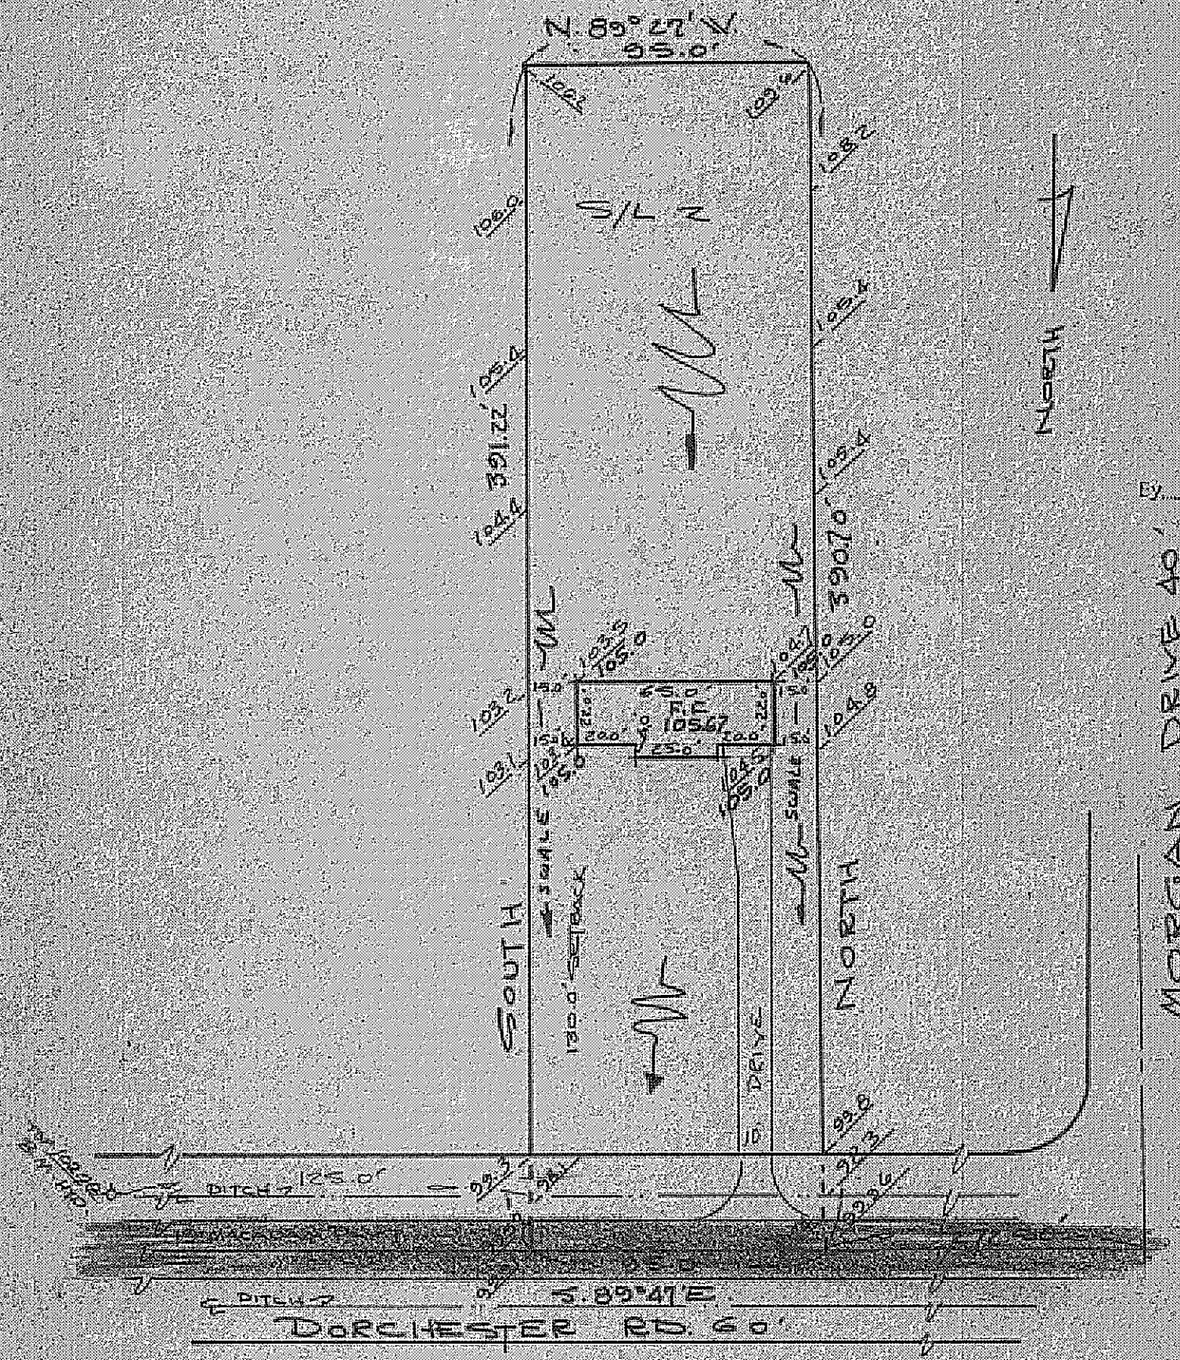

APPROVED
SIDE LINES & SET BACK
PERRY TOWNSHIP ZONING
PERMIT NO. 1379
ZONING INSPECTOR NWS

Grading Plan Approved
as shown and/or noted
THOMAS P. GILLES, P.E.
Lake County Engineer

By JWK Date 2 July 73

"AS BUILT" CERTIFICATION

I, HEREBY CERTIFY THAT THE CIRCLED GRADES ARE EXISTING FINISH GRADES CHECKED IN FIELD ON _____ 19__ BY SURVEYING AND ARE CORRECT TO THE BEST OF MY KNOWLEDGE AND BELIEF

REG. NO.

SITE PLAN

PERRY TOWNSHIP LAKE COUNTY, OHIO

for INTERLINE HOMES
CLIENT OWNER

ADDRESS STREET CITY ZIP

KLANN SUBD
SUBDIVISION NAME
K 97
VOL. & PG.
2 DORCHESTER Rd
SUBLOT NO STREET

LOT TRACT
VOLUME PAGE
PERM PARCEL # STREET

LEGEND

SANITARY MANHOLE
STORM MANHOLE
INLET OR CATCH BASIN
HYDRANT
EXISTING CONTOURS
PROPOSED CONTOURS
EXIST ELEV 100.0 / 100.0 PROP ELEV

WATER VALVE (GAS)
WATER METER (GAS)
AS BUILT ELEVATION
INDICATES DIRECTION OF SURFACE DRAINAGE

REMARKS

ALL BOUNDARY DATA SHOWN WAS OBTAINED FROM (DEEDS RECORDED SUBDIVISION PLAT OR OTHER PUBLIC RECORDS)

DESIGN CERTIFICATION

THIS PLAT WAS PREPARED BY ME, AND IS CORRECT TO THE BEST OF MY KNOWLEDGE AND BELIEF

[signature] PS #5244
NAME SURVEYOR REGISTRATION NO

CHECK LIST

DIMENSIONS
BEARINGS
TIE TO NEAREST STREET
SUBLOT NO PARCEL NO
SURROUNDING OWNERS
BLDG DIMENSIONS FIN GR
BLDG TIES FLR GRADES
APROH TYPE WIDTH THICKNESS
SIDEWALK TYPE WIDTH THICKNESS
CULVERT TYPE DIA LENGTH

WATER MAIN SIZE LOCATION
SAN SEWER SIZE % GR LOC
SAN MH CAST ELEV INV ELEV
SAN CONN SIZE LOC DEPTH
STORM SEWER SIZE % GR LOC
STORM MH CAST ELEV INV ELEV
PAVI TYPE GRADE CURBS
GAS LINE LOC SIZE PRESSURE
SEPTIC TANK SIZE LOC
WELL LOCATION

REVISIONS		
NO	DATE	BY
1		
2		
3		
4		
5		

PLAN PREPARED BY
DEBEVEC SALO & ASSOC, INC
NAME
130 EAST JACKSON ST, PAINESVILLE
ADDRESS

DRAWN BY	SCALE	PHONE NO
JWCB	1"=50'	
CHK	DATE	DRAWING NO
[signature]	6/28/73	3902-2