SITE PLAN

Perry TOWNSHIP LAKE COUNTY, OHIO

for Inge Linehomes CLIENT OWNER

ADDRESS STREET CITY ZIP

Klann Subd NAME

Lot 97 PLAT NO

14 SUBLOT NO Dorchester Rd STREET

LOT TRACT

VOLUME PAGE

PERM PARCEL # STREET

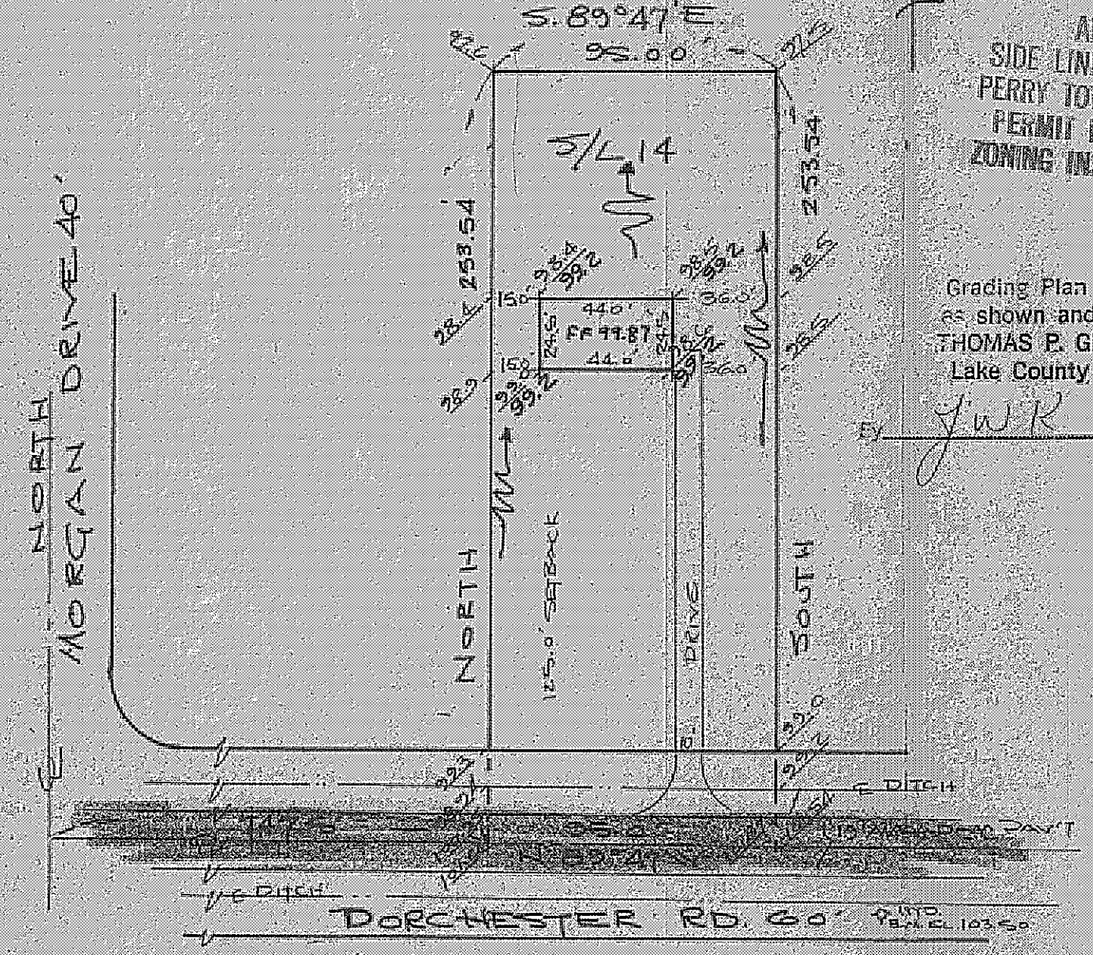

APPROVED
SIDE LINES & SET BACK
PERRY TOWNSHIP ZONING
PERMIT NO. 1383
ZONING INSPECTOR [illegible]

Grading Plan Approved
as shown and/or noted
THOMAS P. GILLES, P.E.
Lake County Engineer

By JWR Date 2 July 73

LEGEND

SANITARY MANHOLE
STORM MANHOLE
INLET OR CATCH BASIN
HYDRANT
EXISTING CONTOURS
PROPOSED CONTOURS
EXIST ELEV 100.0 PROP ELEV
WATER VALVE (GAS)
WATER METER (GAS)
AS BUILT ELEVATION

REMARKS

ALL BOUNDARY DATA SHOWN WAS OBTAINED FROM DEEDS RECORDED SUBDIVISION PLAT OR OTHER PUBLIC RECORDS.)

DESIGN CERTIFICATION

THIS PLAT WAS PREPARED BY ME AND IS CORRECT TO THE BEST OF MY KNOWLEDGE AND BELIEF

Richard J. Bibler PS#5244
NAME SURVEYOR REGISTRATION NO

CHECK LIST

DIMENSIONS
BEARINGS
TIE TO NEAREST STREET
SUBLOT NO PARCEL NO
SURROUNDING OWNERS
BLDG DIMENSIONS FIN GR
BLDG TIES FLR GRADES
APRON TYPE WIDTH THICKNESS
SIDEWALK TYPE WIDTH THICKNESS
CULVERT TYPE DIA LENGTH

WATER MAIN SIZE LOCATION
SAN SEWER SIZE % GR LOC
SAN MH CAST ELEV INV ELEV
SAN CONN SIZE LOC DEPTH
STORM SEWER SIZE % GR LOC
STORM MH CAST ELEV INV ELEV
PAVT TYPE GRADE CURBS
GAS LINE LOC SIZE PRESSURE
SEPTIC TANK SIZE LOC
WELL LOCATION

"AS BUILT" CERTIFICATION

I, HEREBY CERTIFY THAT THE CIRCLED GRADES ARE EXISTING FINISH GRADES CHECKED IN FIELD ON _____ 19__ BY SURVEYING AND ARE CORRECT TO THE BEST OF MY KNOWLEDGE AND BELIEF

REG NO.

REVISIONS		
NO	DATE	BY
1		
2		
3		
4		
5		

PLAN PREPARED BY
DE BEVEC-SALOY ASSOC., INC.
NAME
130 EAST JACKSON ST, PAINESVILLE
ADDRESS

DRAWN BY JWB	SCALE 1"=50'	PHONE NO
CHK'D JWB	DATE 6/20/73	DRAWING NO 3902-14