
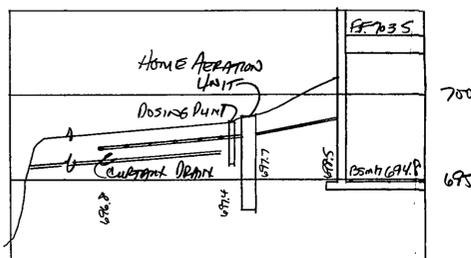
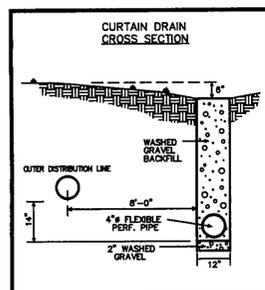



I, the undersigned hereby certify that this topography indicated by 6", 1", or 2" contours, and elevations shown hereon represent an actual field survey made by me on the 10th day of MAY, 2005 and that the elevations were taken at appropriate intervals and that as of that date they existed as indicated hereon.

James R. Gills, P.E. Reg. No. 46313

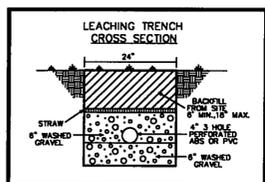

Temporary Seeding Species Selection			
Seeding Dates	Species	Lb./1,000 ft. <sup>2</sup>	Per Ac.
March 1 to August 15	Oats	3	4 bushel
	Tall Fescue	1	40 lb.
	Annual Ryegrass	1	40 lb.
August 16 to November 1	Perennial Ryegrass	1	40 lb.
	Tall Fescue	1	40 lb.
	Annual Ryegrass	1	40 lb.
November 1 to Spring Seeding	Rye	3	2 bushel
	Tall Fescue	1	40 lb.
	Annual Ryegrass	1	40 lb.
November 1 to Spring Seeding	Wheat	3	2 bushel
	Tall Fescue	1	40 lb.
	Annual Ryegrass	1	40 lb.
November 1 to Spring Seeding	Perennial Ryegrass	1	40 lb.
	Tall Fescue	1	40 lb.
	Annual Ryegrass	1	40 lb.

Note: Other approved seed species may be substituted.

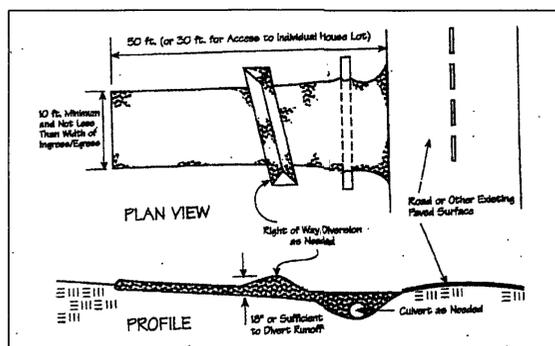

Erosion and Sediment Control Schedule

Ingress-Egress: A stone access drive complete with under lying geo-textile fabric (20 feet wide and 50 feet long) for ingress and egress at the site shall be installed.


Silt Fence: A silt fence shall be installed prior to any earthwork activities at the site in the locations shown on the site plan as well as along the front of any lot that slopes towards the street.

Temporary Seeding: Disturbed areas of the site that are to remain idle for more than thirty(30) days shall be properly seeded and straw mulched within seven(7) days of completion of initial grading.

Stabilization of critical areas within fifty(50) feet of any stream or wetland shall be complete within two(2) days of the disturbance if the site is to remain inactive for longer than fourteen(14) days.

Mulching: Straw-mulch shall be applied at a rate of 1 bale per every ten (10) feet of curb, at a width of thirty(30) feet to the entire length of the lot.

Maintenance: Erosion and sediment controls shall be inspected every seven(7) days or within 24 hours of a 0.5" or greater rainfall event.

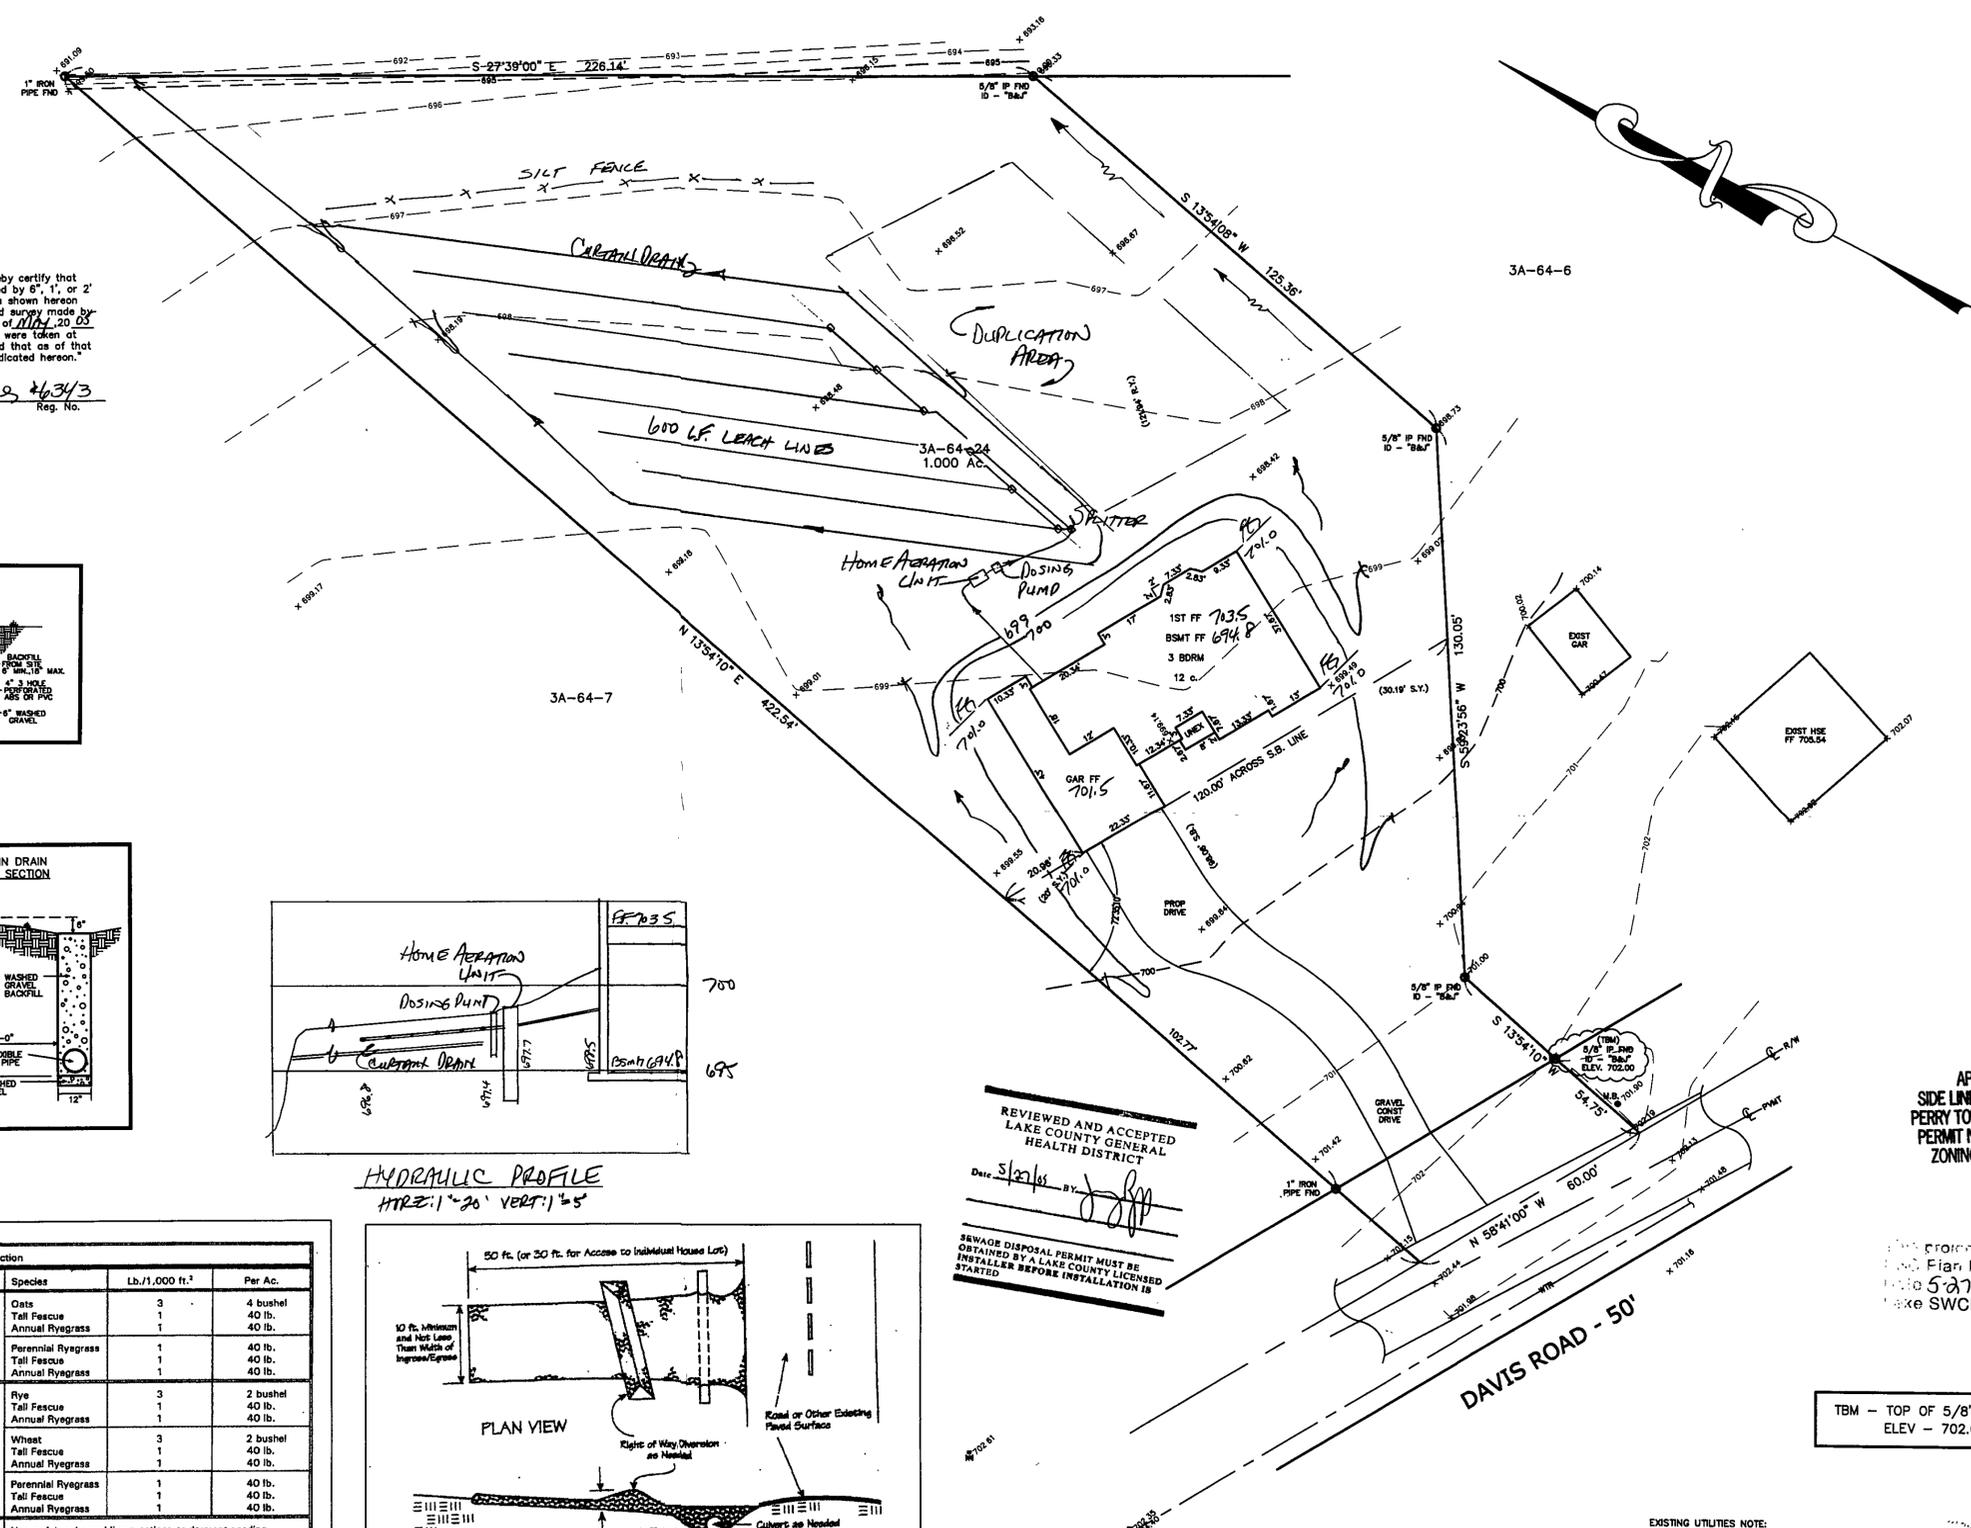


APPROVED SIDE LINES & SET BACK PERRY TOWNSHIP ZONING PERMIT NO. 7641 ZONING INSPECTOR

This project is exempt from Final Review Date 5-27-05 Lake SWCD pgg

TBM - TOP OF 5/8" IRON PIN ELEV - 702.00

Grading Plan Approved as shown and/or noted JAMES R. GILLS, P.E. Lake County Engineer

EXISTING UTILITIES NOTE: THE SIZE AND LOCATION, BOTH HORIZONTAL AND VERTICAL OF THE UNDERGROUND UTILITIES SHOWN HEREON, HAVE BEEN OBTAINED BY A SEARCH OF AVAILABLE RECORDS.



REV NO.	DESCRIPTION	DATE	BY	CHK'D
1	REVISIONS PER LC HEALTH DEPT	5-19-05	HT	HT

bj BABCOCK, JONES AND ASSOCIATES, INC CIVIL ENGINEERS - SURVEYORS - LAND PLANNERS PAINESVILLE OHIO 44077

DATE	5/11/05
DESIGN BY	H.J.
DRAWN BY	B.P.
APPROVED BY	H.J.
CREW CHIEF	W.B.

SITE PLAN FOR RICK HERZOG (LOT No. 63) DAVIS ROAD (P.P.# 3A-64-24) PERRY TOWNSHIP LAKE COUNTY STATE OF OHIO

SCALE	1"=20'
JOB NO	04-288-T
SHEET	1 OF 1