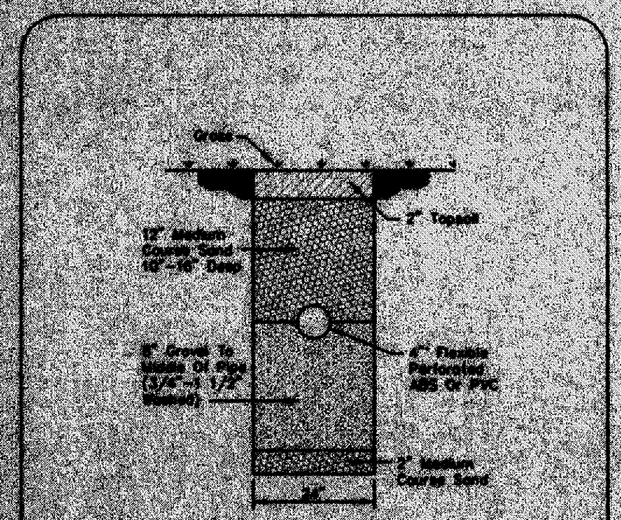

EVAPORATION-TRANSPIRATION TRENCH CROSS-SECTION
NO SCALE

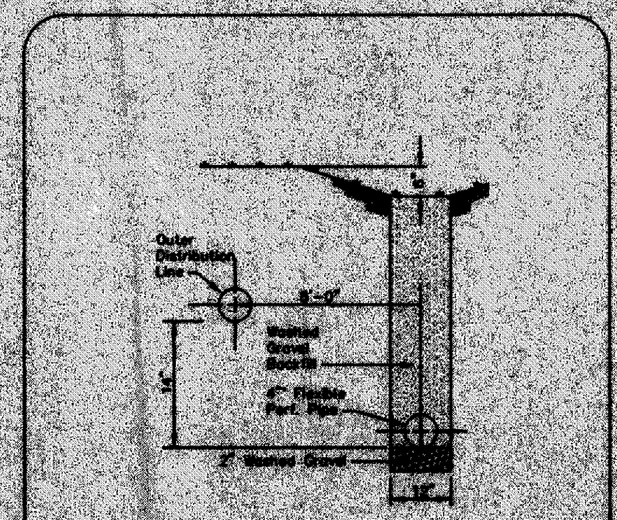

CURTAIN DRAIN CROSS SECTION
NO SCALE

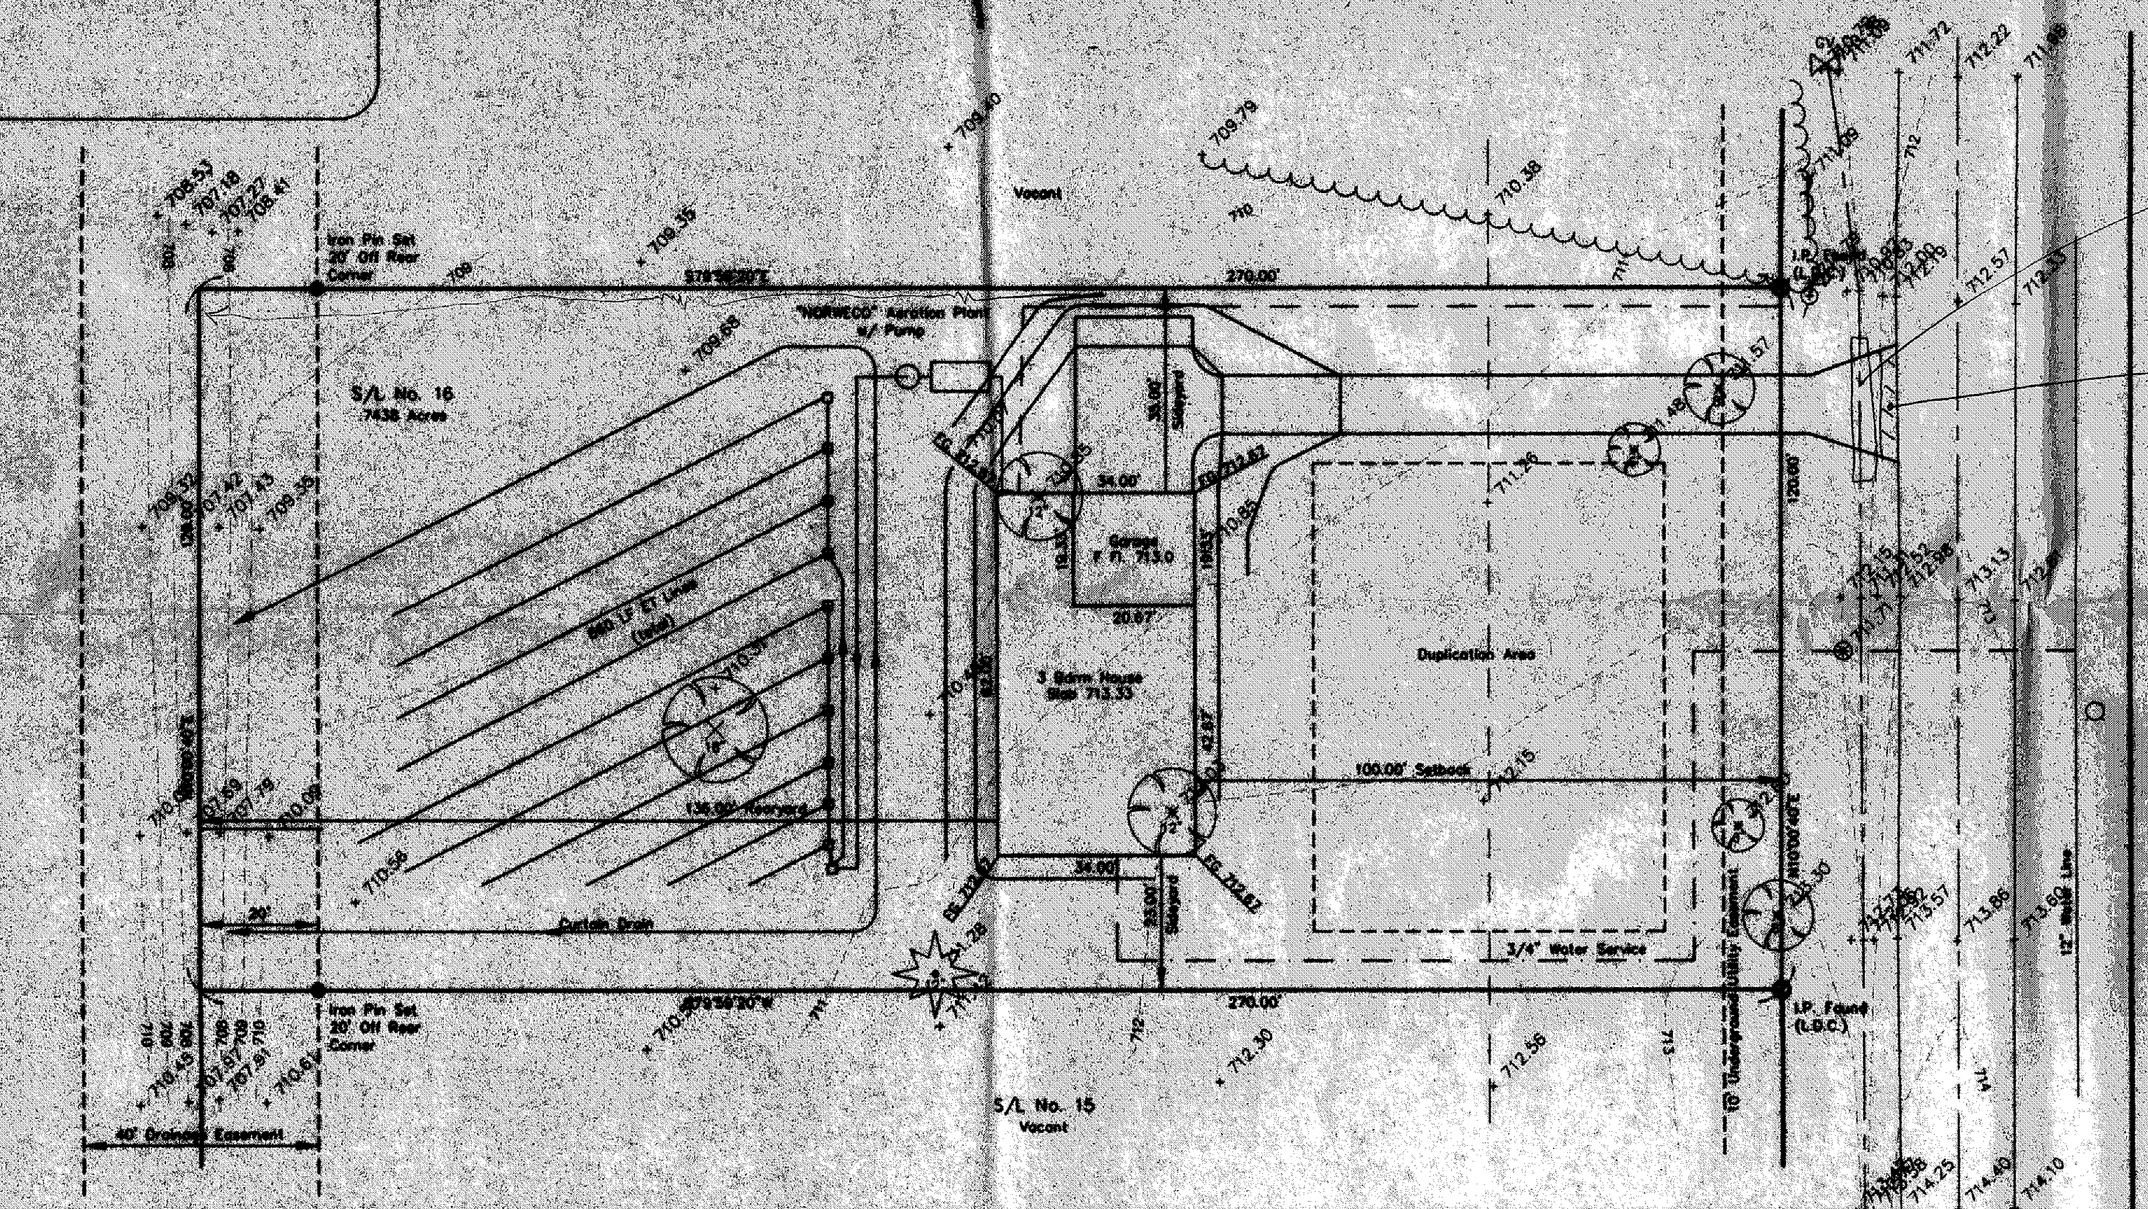

SEWAGE DISPOSAL PERMIT MUST BE OBTAINED BY A LAKE COUNTY LICENSED INSTALLER BEFORE INSTALLATION IS STARTED.

LOW YIELD WATER FIXTURES REQUIRED ON ALL:
— Shower Head
— Toilet

A. To be brought to finished grade
1. Septic tank manhole covers
2. Splitter box cover
3. Distribution box cover

B. No footer drains or downspouts to be discharged into septic tanks
C. All waste water to be discharged into septic tanks

ROOF DRAINS SHALL DISCHARGE TO SPLASH BLOCKS.

Reviewed and Accepted
LAKE COUNTY GENERAL HEALTH DISTRICT
Date 7-1-96
JOEL LUCIA, R. S., M. P. H.
Health Commissioner
BY J. Lucia

Grading Plan Approved as shown and/or noted
THOMAS P. GILLES, P.E.
Lake County Engineer.
By GLH Date 7.15.96
APPROVED AS MARKED

SYMBOL LEGEND

○	Iron Pin Found
	Power Pole
	Gas Valve
	Guy Wire
	Water Shut Off Valve
	Fire Hydrant
	Tree
	Pine
●	Iron Pin Set

HYDRAULIC PROFILE
Horizontal 1" = 20'
Vertical 1" = 2'

GRAPHIC SCALE
(20 FEET)
1 inch = 20 ft.

RECOMMENDED FOR APPROVAL
7/15/96

STATE OF OHIO
STEVEN K. ROESSNER
S-7076
REGISTERED PROFESSIONAL SURVEYOR

The topography, indicated by 1' contours, and elevations shown hereon represent an actual field survey made by Foresight Engineering Group, Inc. on June 4, 1996. The elevations were taken at appropriate intervals and as of the above date this survey was prepared hereon.
Foresight Engineering Group, Inc.

Foresight Engineering Group
Engineers
Surveyors
Planners
Consultants
REEZ

SCALE: Horz. 1" = 20'
Vert. None
FILE NAME: McCULLOUGH/13-16.dwg
DATE: May 4, 1996

REVISIONS:
REVISIONS PER HEALTH DEPARTMENT 7-1-96

McCULLOUGH BUILDERS
SOUTH PERRY PINES SUBDIVISION
Perry Township - Lake County - Ohio
Site Plan - S/L No. 16

SHEET NO.
1 / 1