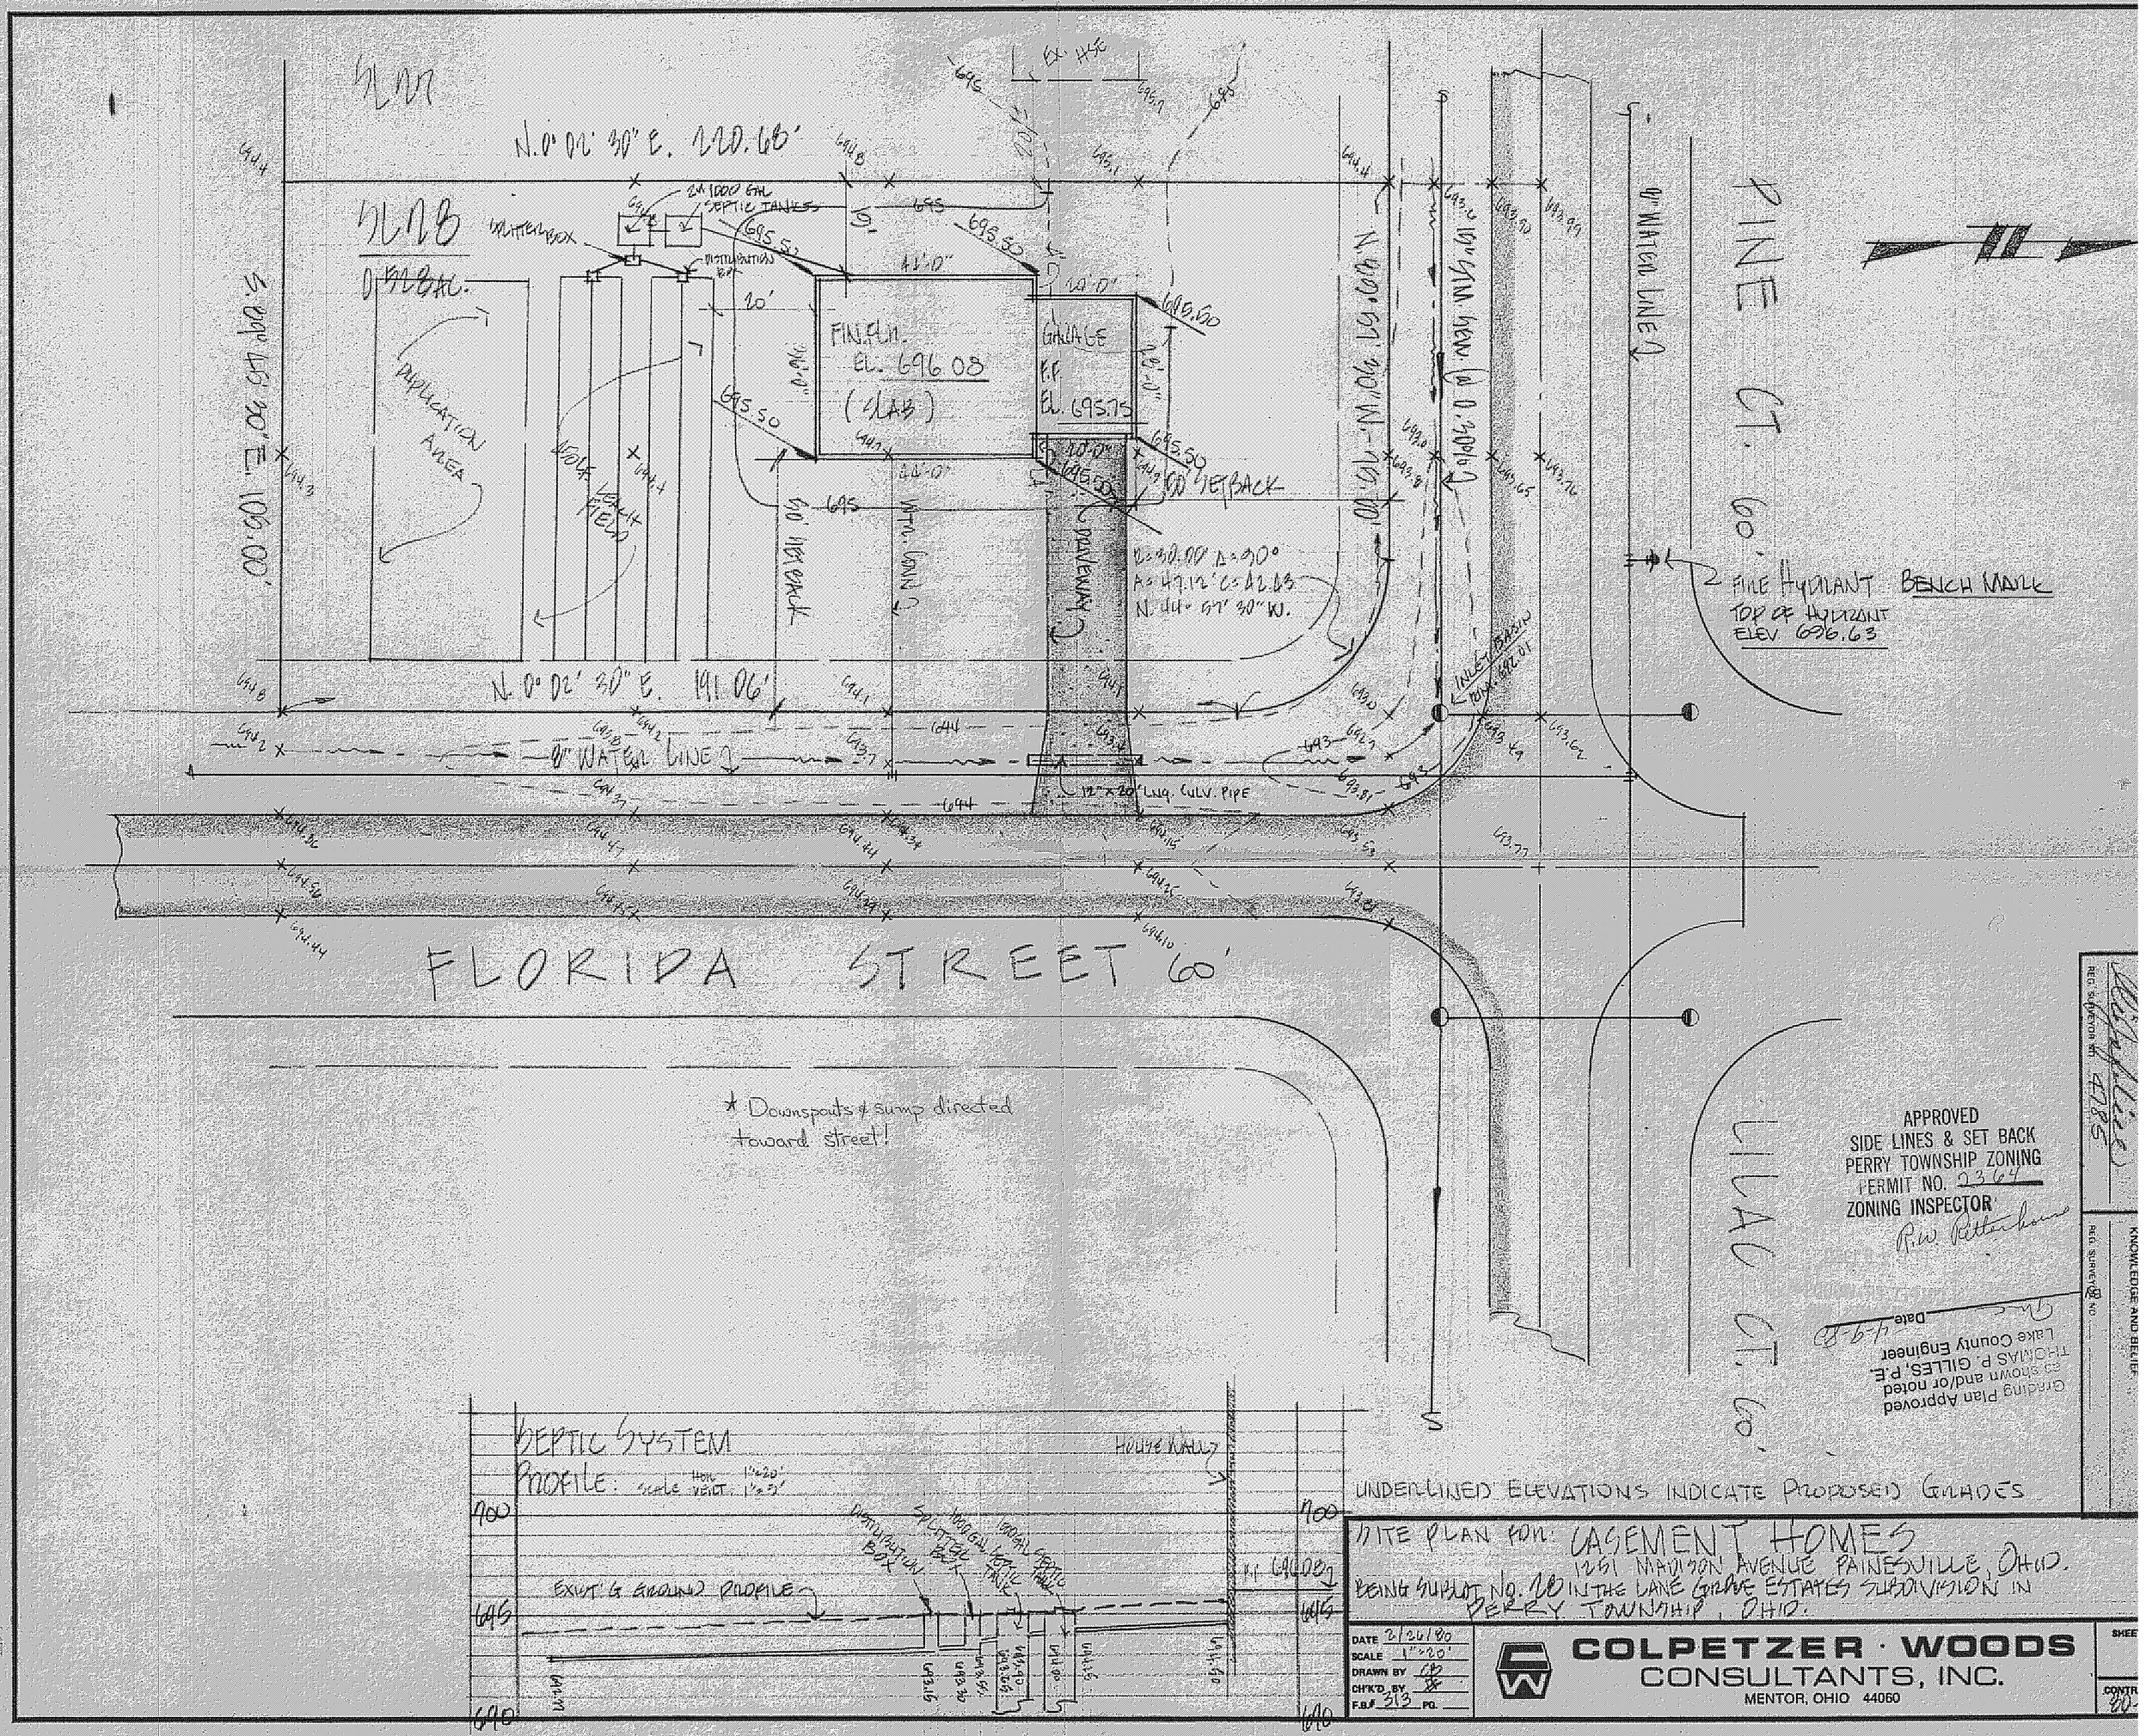

APPROVED
SIDE LINES & SET BACK
PERRY TOWNSHIP ZONING
PERMIT NO. 2364
ZONING INSPECTOR
R.W. Ritterhouse

Grading Plan Approved as shown and/or noted
THOMAS P. GILLES, P.E.
Lake County Engineer
Date 4-9-80

REG. SURVEYOR NO. 4785

KNOWLEDGE AND BELIEF

REG. SURVEYOR NO.

UNDERLINED ELEVATIONS INDICATE PROPOSED GRADES

SITE PLAN FOR: CASEMENT HOMES
1251 MADISON AVENUE PAINESVILLE, OHIO.
BEING SUBLOT NO. 28 IN THE LANE GROVE ESTATES SUBDIVISION IN PERRY TOWNSHIP, OHIO.

DATE 2/26/80
SCALE 1"=20'
DRAWN BY CB
CH'K'D BY
F.B.# 313 PG.

COLPETZER · WOODS
CONSULTANTS, INC.
MENTOR, OHIO 44060

SHEET

CONTR