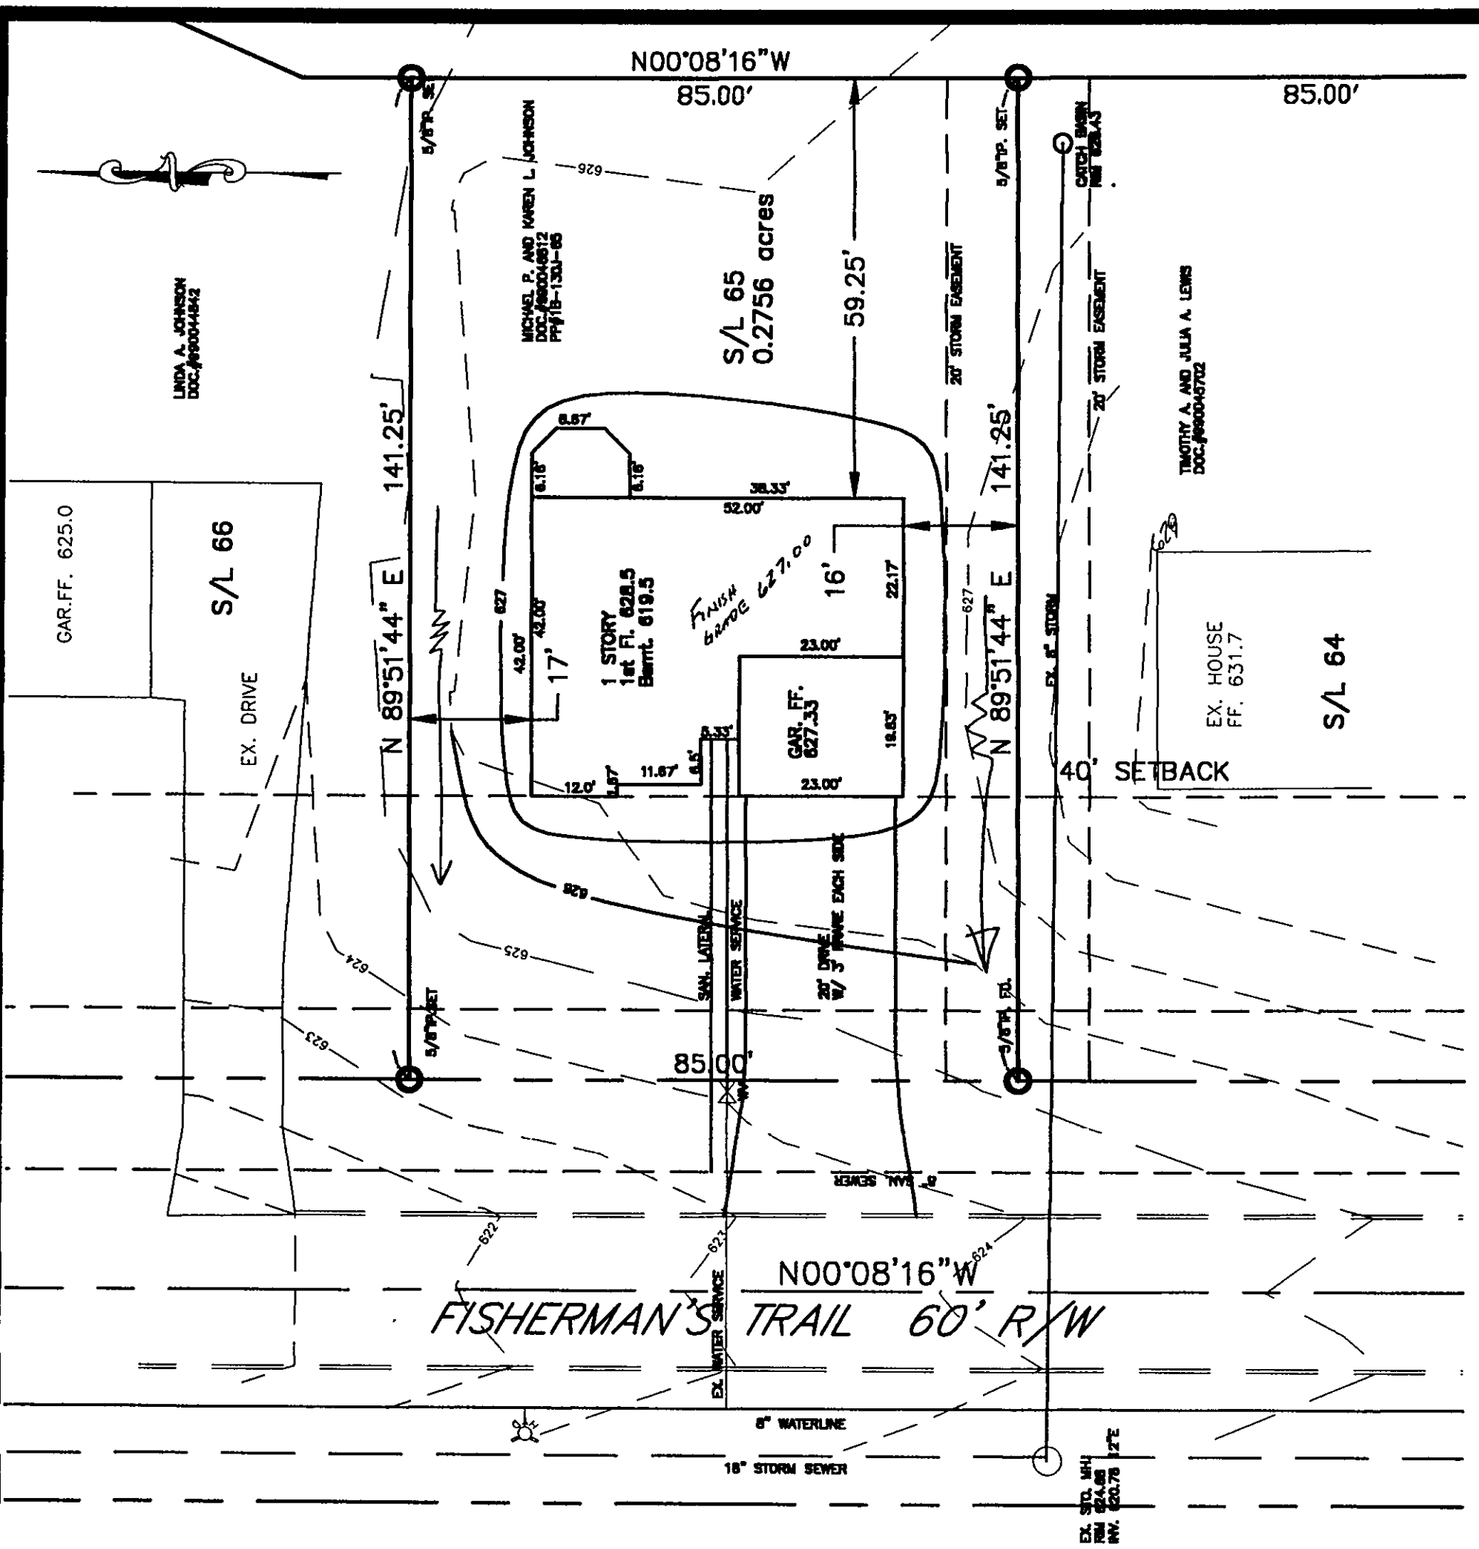

GRAPHIC SCALE

20 0 10 20 40 80

(IN FEET)
1 inch = 20 ft.

Grading Plan Approved
THOMAS P. GILLES, P.E.
Lake County Engineer

By TAM Date 10/15/99

SWALE AS SHOWN
FINISH GRADE TO BE 627.00

ROOF DRAINS SHALL DISCHARGE TO SPLASH BLOCKS.

APPROVED
MADISON TOWNSHIP ZONING
DATE 10/14/99
BY UM 16458

NOTES : 1. The Contractor Shall Verify the Following Before Starting: Finish Floor Elevations and House Size. Location and elevation of existing utility connections.

2. Contractor Shall Contact OUPS at least 2 Working Days prior to construction, 1-800-362-2764

"I, the undersigned hereby certify that this topography, indicated by 1' contours and elevations shown hereon represents an actual field survey made by me in Oct., 1999 and that the elevations were taken at appropriate intervals and that as of that date they existed as indicated hereon."

STATE OF OHIO
DAVID A. RAPP 7597
REGISTERED PROFESSIONAL SURVEYOR

David A. Rapp 10-14-99
David A. Rapp Reg No.

990216

COR Consultants, Inc.

23 S. Forest Street Geneva, Ohio 44041
440-466-8085

DATE: Oct., 1999
DRAWN BY: DAR
CHECKED BY: RMO
APPROVED BY: DAR
P.S. No. 7597

HSM BUILDERS
Windjammer Bay Sub. Phase 2
Site Plan For Sublot 65