APPROVED
MADISON TOWNSHIP ZONING
DATE 1/7/99
BY 16053

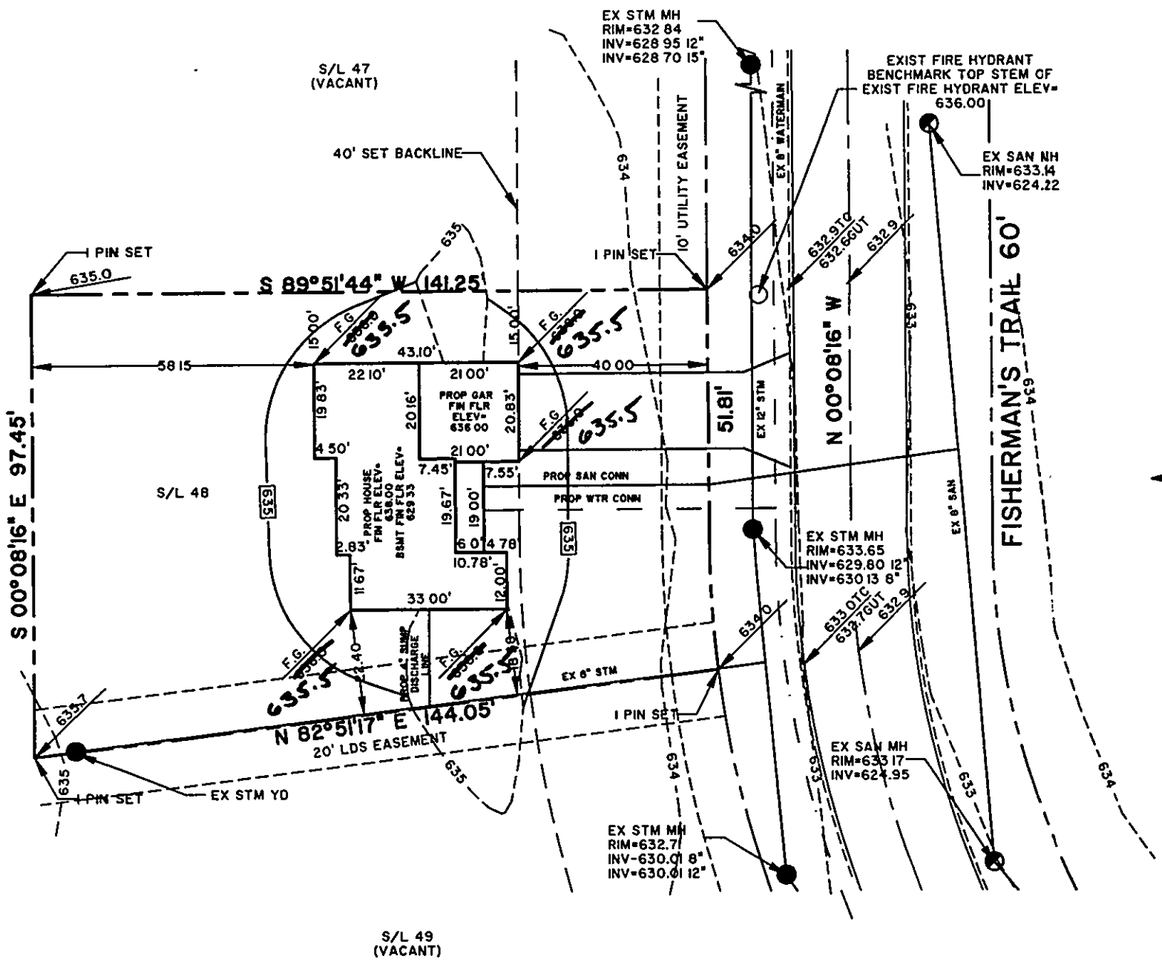


## GENERAL NOTES:

1. DRIVEWAY APRON TO BE 6" THICK
2. BENCHMARK - TOP STEM OF FIRE HYDRANT LOCATED IN FRONT OF SUBLOT No. 48, ELEV. = 636.00

## LEGEND

EXISTING CONTOUR
PROPOSED CONTOUR

100.00 / 100.00 — EXISTING ELEVATION / PROPOSED ELEVATION

## CERTIFICATION

"I THE UNDERSIGNED HEREBY CERTIFY THAT THIS TOPOGRAPHY INDICATED BY 1' CONTOURS AND ELEVATIONS SHOWN HEREON REPRESENTS AN ACTUAL SURVEY MADE BY ME ON THE 21st. DAY OF DEC. , 1998 AND THE ELEVATIONS WERE TAKEN AT APPROPRIATE INTERVALS AND AS OF THAT DAY THEY EXISTED AS INDICATED HEREON.

"I HEREBY CERTIFY THAT THIS PLAN WAS PREPARED BY ME AND IS CORRECT TO THE BEST OF MY KNOWLEDGE"

DAVID W. NOVAK, P.S. No. 7507

GRAPHIC SCALE

30 0 15 30 60 120

( IN FEET )
1 inch = 30 ft.

Grading Plan Approved as shown and/or noted
THOMAS P. GILLES, P.E.
Lake County Engineer.

By TAM Date 1/11/99

**ROOF DRAINS SHALL DISCHARGE TO SPLASH BLOCKS.**

| REV No. | DESCRIPTION | DATE | BY | CHK'D |
|---|---|---|---|---|
| | | | | |

FORM No. A3-2 (06/29/98)

STATE OF OHIO — DAVID W NOVAK 8-7507 REGISTERED SURVEYOR


*Himebaugh and Novak*
*Surveyors and Site Consultants*
*38342 Western Parkway, Unit 10*
*Willoughby, Ohio 44094*
*(440) 946-1761, (440) 918-0486 Fax.*


GENTRY HOMES, INC.
6358 CONLEY ROAD, CONCORD, OH 44077

DATE: DEC. 28, 1998
DRAWN BY: C.R. KRAFT
CHECKED BY: DWN
APPROVED BY:
F.B. No. -- PG. --

SITE PLAN
SUBLOT 48, WINDJAMMER BAY SUBDIVISION, MADISON TWP., OH

SCALES: HORZ.: 1" = 30' VERT.: NONE
CONTRACT No. 98121-48
SHEET No. 1 OF 1