Grading Plan Approved
as shown and/or noted
THOMAS P. GILLES, P.E.
Lake County Engineer
By TAM Date 8/27/99

SCALE: 1" = 20'

EXIST. / PROP.

EXIST. / PROP.

N

SITE PLAN
FOR
GLENN GNAGY

BEING KNOWN AS SPLIT '1' OF THE IRMA & LESLIE GNAGY LOT SPLIT, PART OF LOT, No. 1 TRACT No. 3, IN MADISON TOWNSHIP, LAKE COUNTY, OHIO.

NOTE: BEARINGS PER RECORD DEED AND MONUMENTATION FOUND.

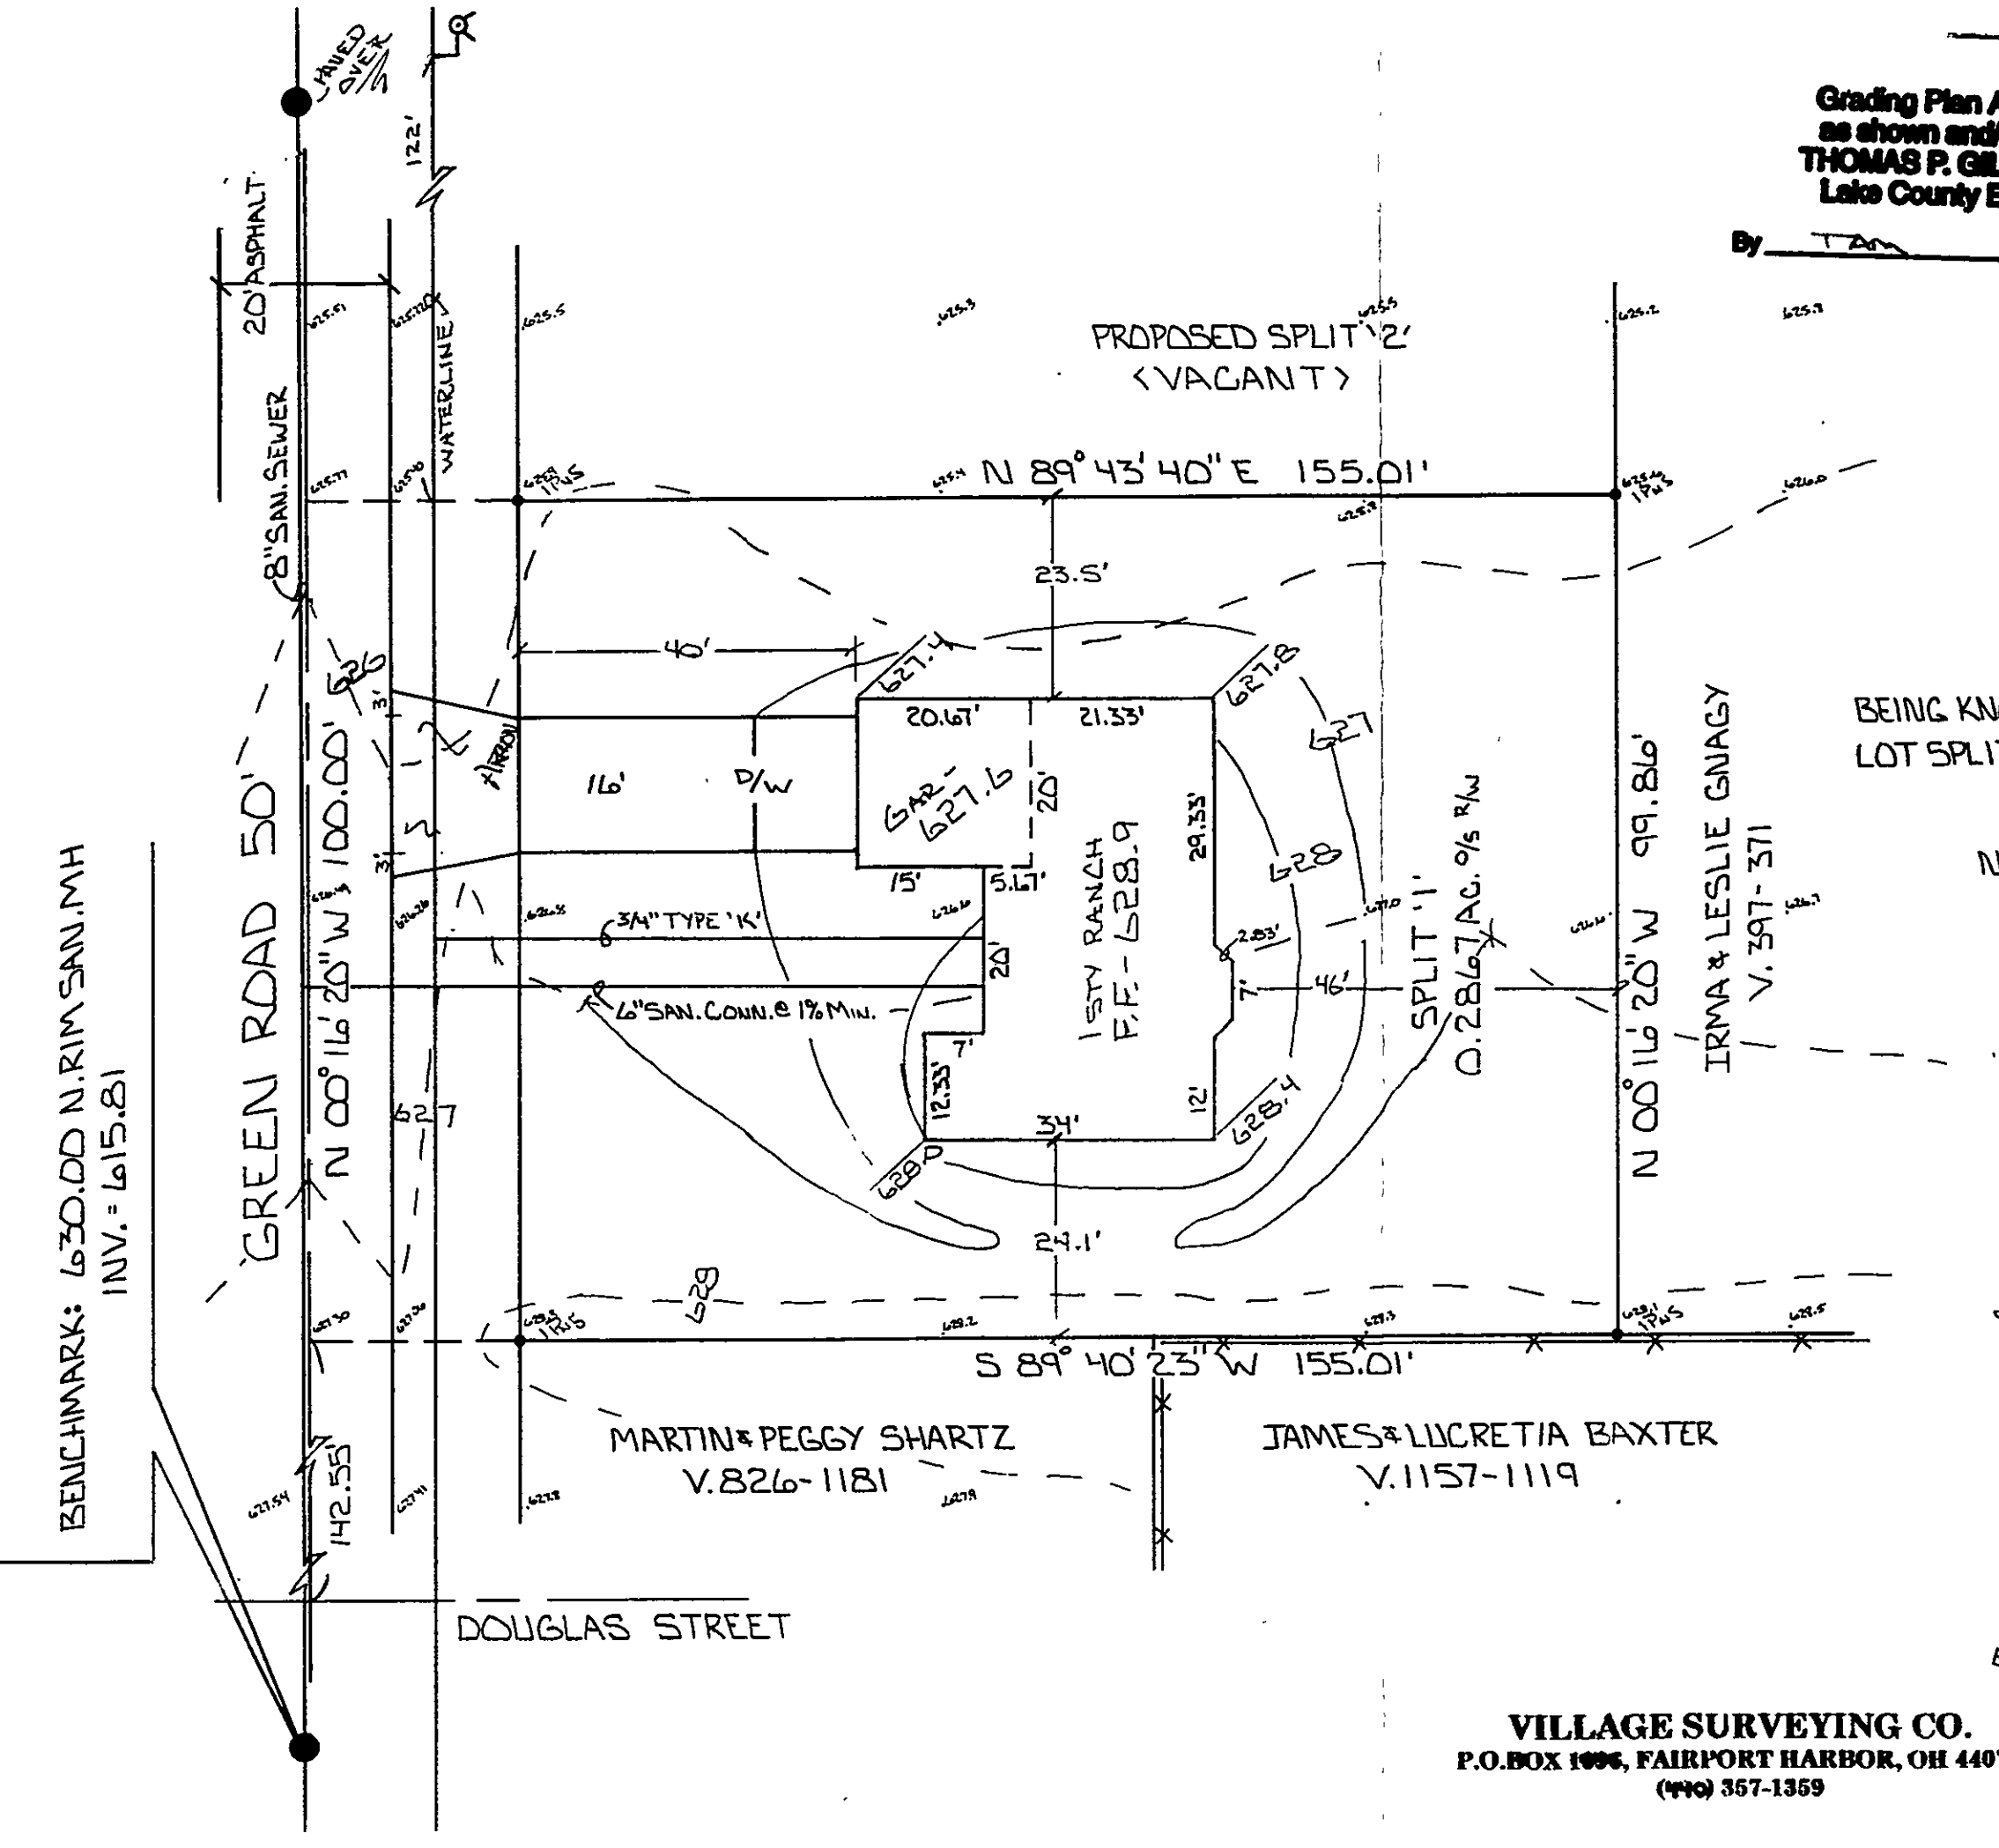

I, the undersigned hereby certify that this topograghy, indicated by 1' contours and elevations shown hereon represent an actual field survey made by me on AUG. 18, 1999 and that the elevations were taken at appropriate intervals and that as of that date they existed as indicated hereon.

T. M. Coffman P.S.
THOMAS M. COFFMAN P.S. No. 6857

STATE OF OHIO
THOMAS MARC COFFMAN 6857
REGISTERED PROFESSIONAL SURVEYOR

AUG. 23, 1999

APPROVED
MADISON TOWNSHIP ZONING
DATE 8/25/99
BY UM - 16380

VILLAGE SURVEYING CO.
P.O. BOX 1096, FAIRPORT HARBOR, OH 44077
(440) 357-1359