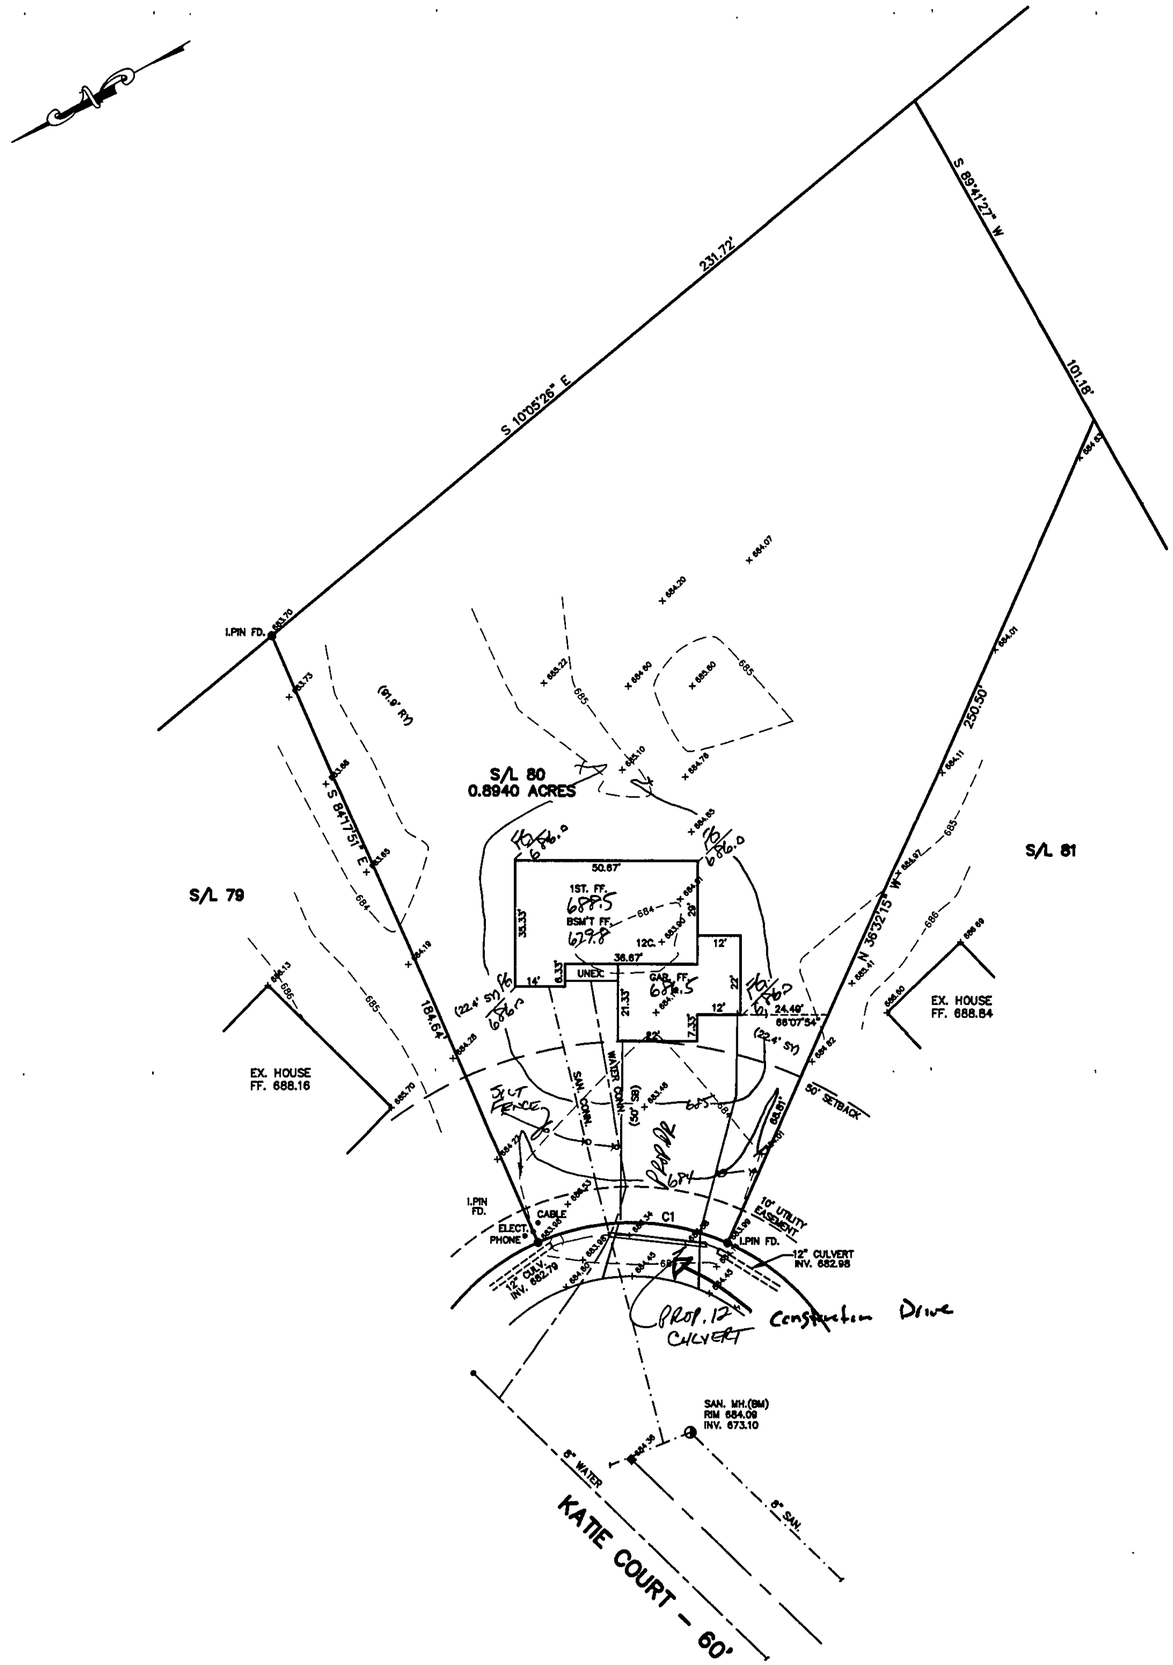

SITE PLAN

PERRY TOWNSHIP, LAKE COUNTY, OHIO

for: NAUGHTON BUILDING COMPANY, INC.

CLIENT OWNER

ADDRESS STREET CITY ZIP

RED MILL RUN — SUBDIVISION
38-34 — VOL.-PG.
NAME
TRACT
STREET
80 — SUBLOT NO.
KATIE COURT — STREET
LOT
VOL.-PG.
PERM. PARCEL NO.

LEGEND

SANITARY MANHOLE
STORM MANHOLE
INLET OR CATCH BASIN
HYDRANT
EXISTING CONTOURS
PROPOSED CONTOURS

EXIST. ELEV. 100.0 / 100.0 PROP. ELEV.

AS BUILT ELEVATION 100.0

INDICATES DIRECTION OF SURFACE DRAINAGE

DESIGN CERTIFICATION

THIS PLAT WAS PREPARED BY ME, AND IS CORRECT TO THE BEST OF MY KNOWLEDGE AND BELIEF.

NAME SURVEYOR REGISTRATION NO.

REVISIONS		
NO.	DATE	BY
1		
2		
3		
4		
5		

PLAN PREPARED BY:
BABCOCK · JONES & ASSOCIATES, INC.
PAINESVILLE, OHIO

DRAWN BY T.R.	SCALE 1"=30'	PHONE NO. 440-357-1811	
CHK'D. H.J.	DATE 11/15/01	DRAWING NO. 93-032-80	
CREW CHIEF R.B.	APP'D H.J.		

"AS BUILT" CERTIFICATION
I, HEREBY CERTIFY THAT THE CIRCLED GRADES ARE EXISTING FINISH GRADES CHECKED IN THE FIELD ON _____, 20___ AND ARE CORRECT TO THE BEST OF MY KNOWLEDGE AND BELIEF.

REGISTERED SURVEYOR REG. NO.

C1: R=65.00'
L=54.18'
T=28.78'
D=47°45'36"
C=52.63'
N29°34'57"E

BM-SANITARY MANHOLE #6
RIM=684.09

NOTE: TEMPORARY SEEDING REQUIRED IN DISTURBED AREAS.

Grading Plan Approved
as shown and/or noted
JAMES R. GILLS, P.E.
Lake County Engineer
By CJH Date 11-21-01

ROOF DRAINS SHALL DISCHARGE TO SPLASH BLOCKS.

APPROVED
SIDE LINES & SET BACK
PERRY TOWNSHIP ZONING
PERMIT NO. 7204
ZONING INSPECTOR

Approved
File # PES1012C7
Date 11/20/01
Lake SWCD

STATE OF OHIO
HARRY S. JONES, JR.
S-6343
REGISTERED
PROFESSIONAL SURVEYOR