REVIEWED AND ACCEPTED
LAKE COUNTY GENERAL
HEALTH DISTRICT
Date 9-30-99 By Arnold B. Morris R.S.

SEWAGE DISPOSAL PERMIT MUST BE OBTAINED BY A LAKE COUNTY LICENSED INSTALLER BEFORE INSTALLATION IS STARTED.

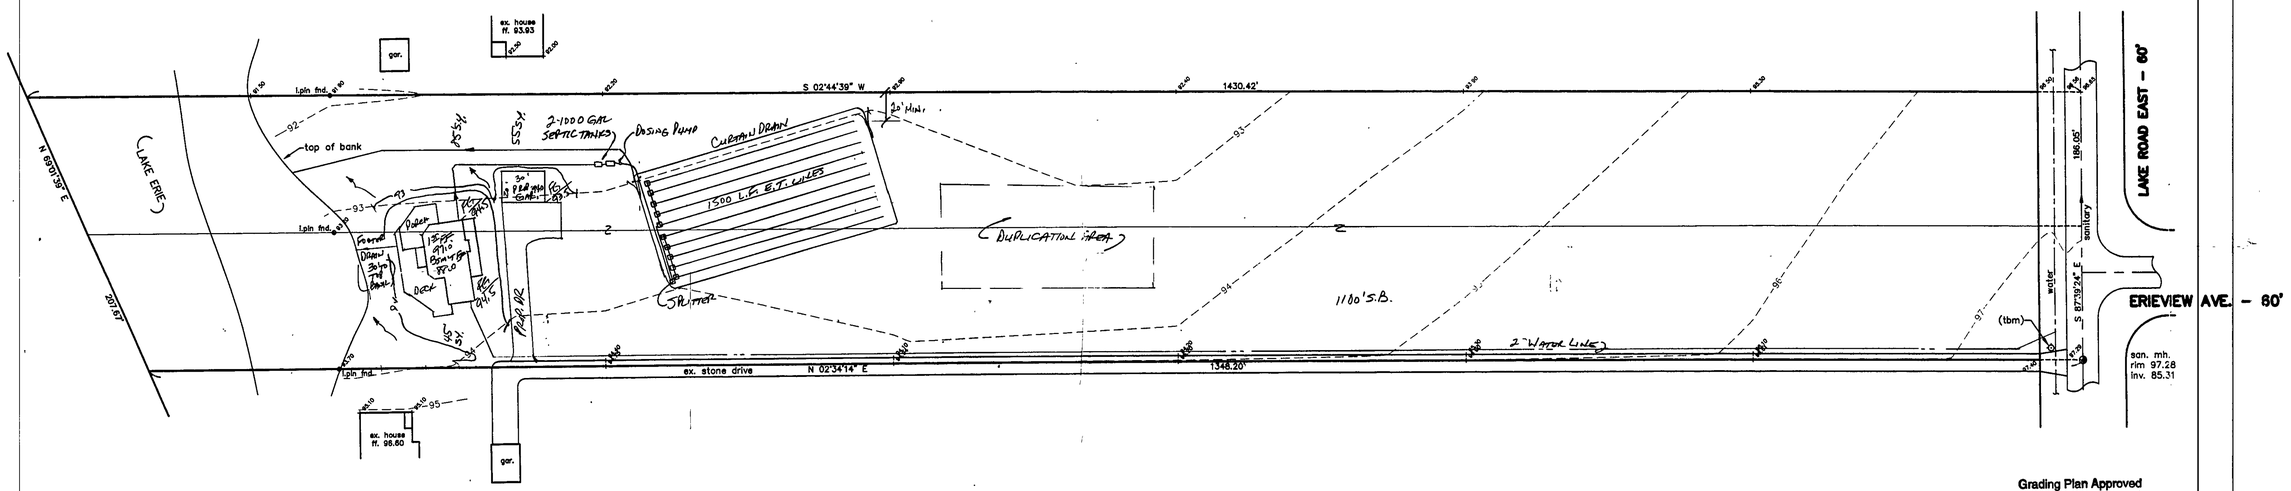

Grading Plan Approved
as shown and/or noted
THOMAS P. GILLES, P.E.
Lake County Engineer
By TPG Date 10/15/99

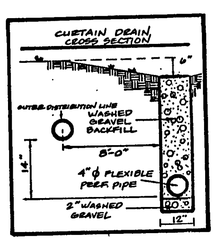

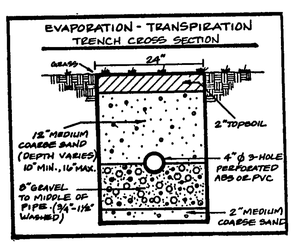

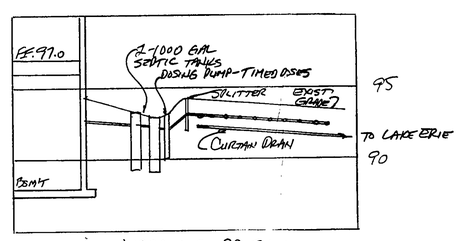

HYDRAULIC PROFILE
HORIZ: 1"=50' VERT: 1"=5'

"I, the undersigned, hereby certify that this topo[illegible] by 0', 1' or 2' contours, and [illegible]ions shown hereon represent an actual field survey made by me on the 21st day of Sept, 1999 and that the elevations were taken at appropriate intervals and that as of that date they existed as indicated hereon."

Name [illegible] Reg. No. 16343

APPROVED
MADISON TOWNSHIP ZONING
DATE 10/1/99
BY [illegible] 16399

TBM—TOP OF HYDRANT
ELEV.=100.00

STATE OF OHIO
HARRY E. JONES, JR.
E-43067
REGISTERED
PROFESSIONAL ENGINEER

REV NO.	DESCRIPTION	DATE	BY	CHK'D

BABCOCK, JONES AND ASSOCIATES, INC
CIVIL ENGINEERS – SURVEYORS – LAND PLANNERS
PAINESVILLE OHIO 44077

DATE	9/22/99
DESIGN BY	H.J.
DRAWN BY	T.R.
APPROVED BY	H.J.

SITE PLAN
FOR
DONALD ZITO

MADISON TOWNSHIP LAKE COUNTY

SCALE:	1"=50'
JOB NO	99-245
SHEET	1 OF 1