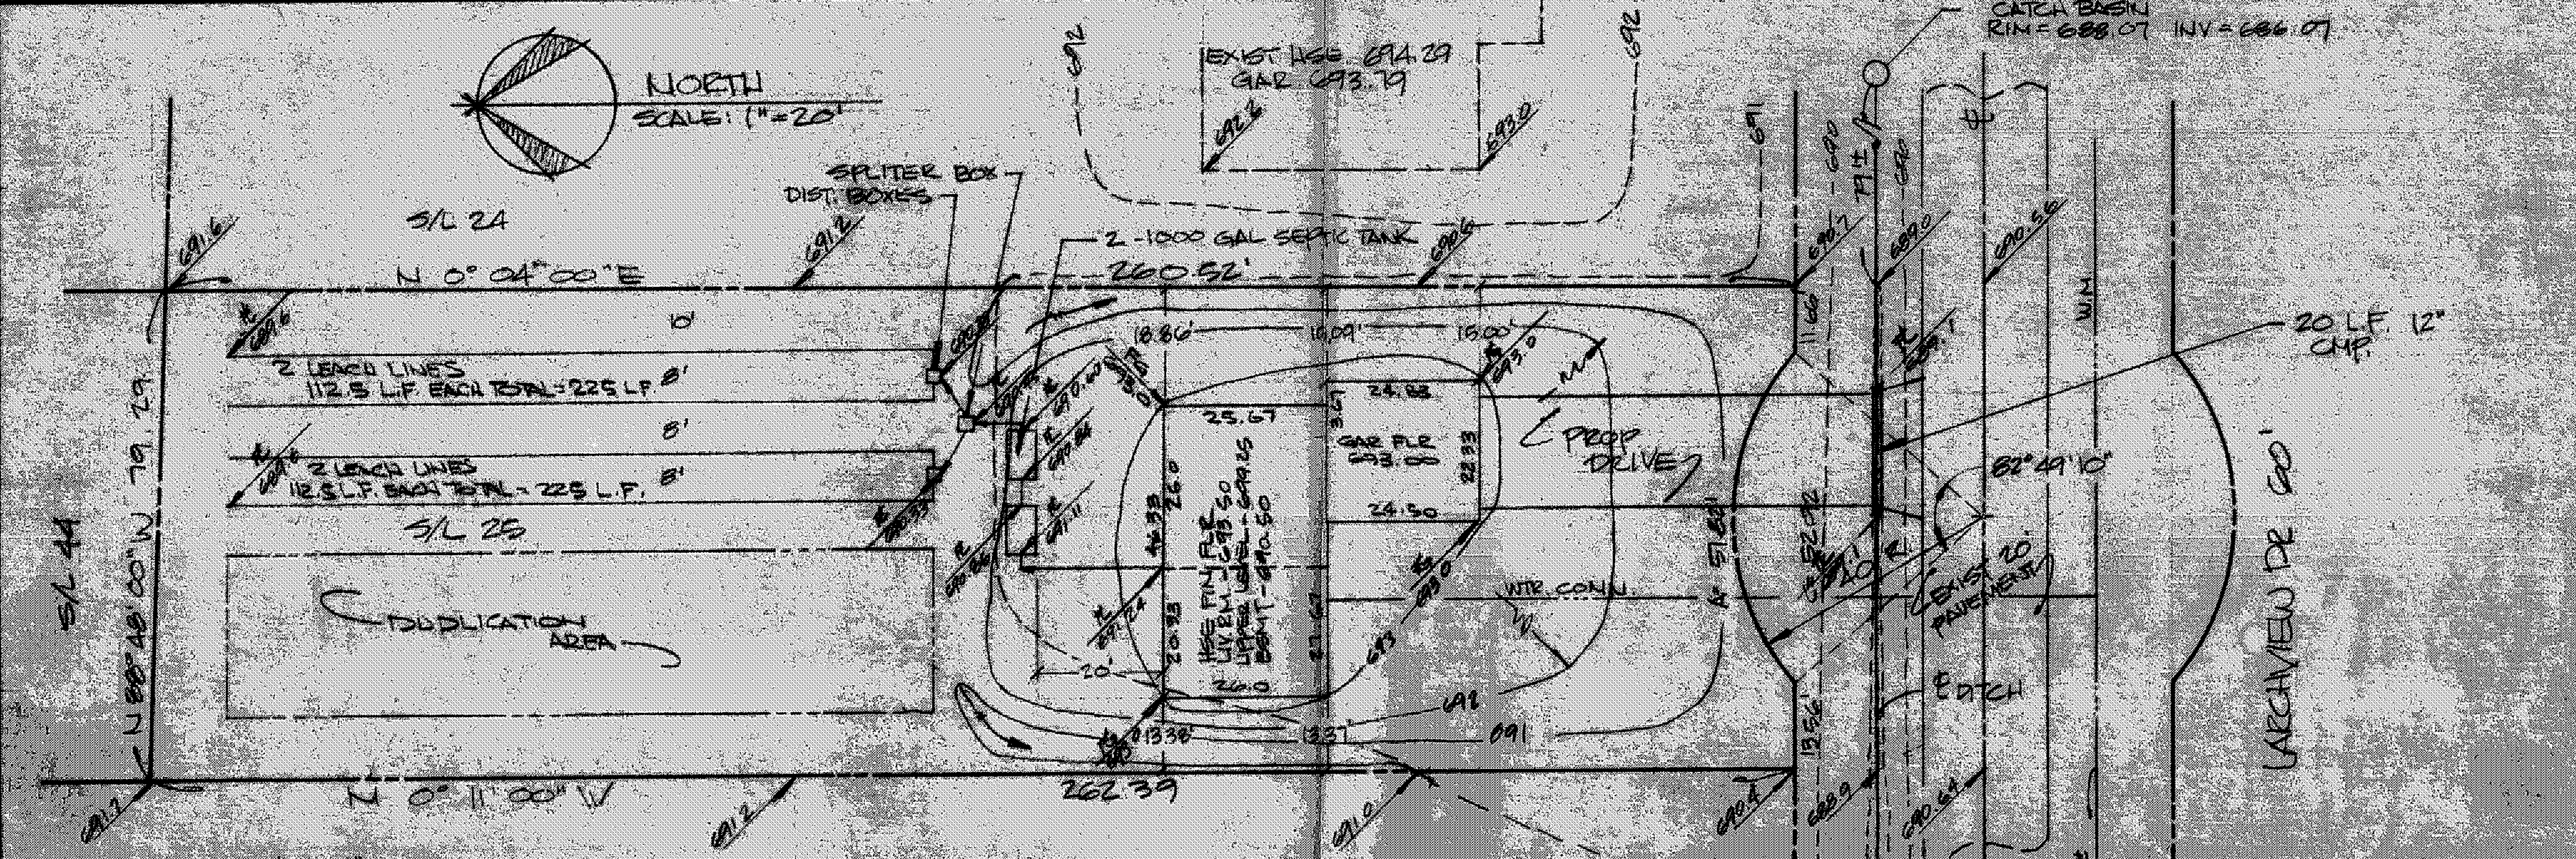

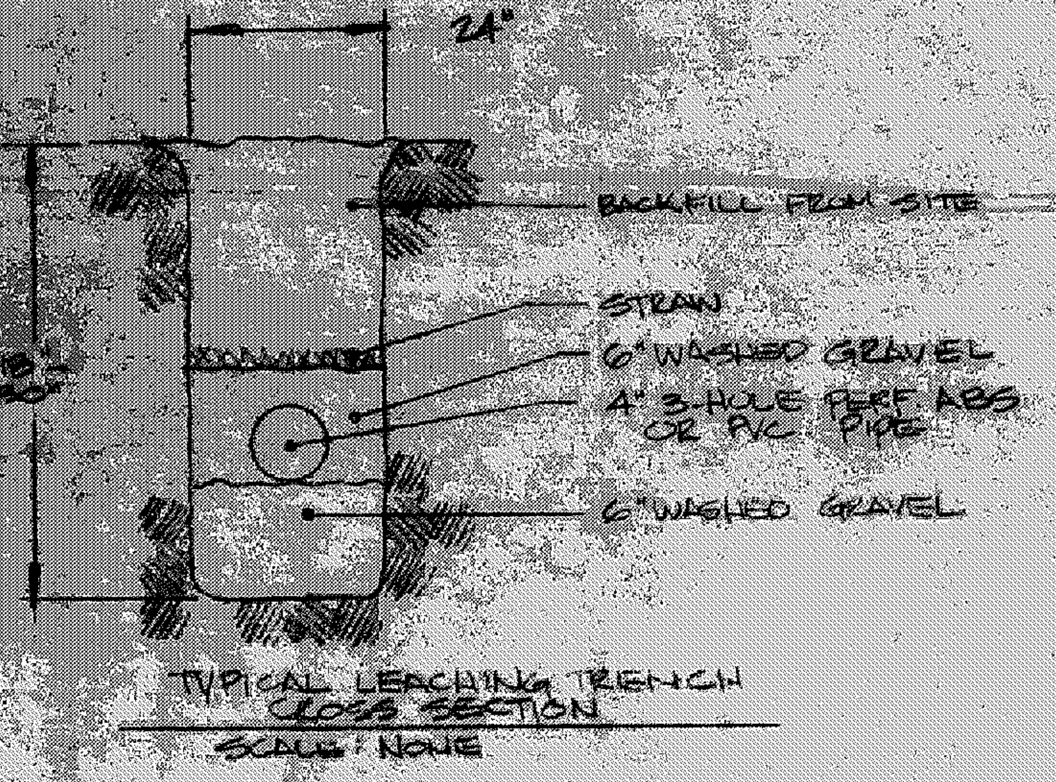

LOW YIELD WATER FIXTURES REQUIRED ON ALL:
- Shower Head
- Toilet

A. To be brought to finished grade
1. Septic tank manhole covers
2. Splitter box cover
3. Distribution box cover

B. No footer drains or downspouts to be discharged into septic tanks

C. All waste water to be discharged into septic tanks

"I, THE UNDERSIGNED HEREBY CERTIFY THAT THE TOPOGRAPHY SHOWN HEREON, INDICATED BY ONE FOOT CONTOURS AND ELEVATIONS REPRESENTS AN ACTUAL FIELD TOPOGRAPHIC SURVEY MADE BY ME ON THE 8TH DAY OF MAY 1990 AND THE ELEVATIONS WERE TAKEN AT APPROPRIATE INTERVALS AND THAT AS OF THAT DATE THEY EXISTED AS INDICATED HEREON"
[signature] P.S. #6820

EXISTING CONTOUR
PROPOSED CONTOUR
100.00 EXISTING ELEV.
100.00 PROPOSED
DIRECTION OF SURFACE DRAINAGE

Reviewed and Accepted
LAKE COUNTY GENERAL HEALTH DISTRICT
Date 5-23-90
JOEL LUCIA, R.S., M.P.H.
Health Commissioner
By [signature]

SEWAGE DISPOSAL PERMIT MUST BE OBTAINED BY A LAKE COUNTY LICENSED INSTALLER BEFORE INSTALLATION IS STARTED.

I HEREBY CERTIFY THAT THIS PLAN WAS PREPARED BY ME AND IS CORRECT TO THE BEST OF KNOWLEDGE
[signature] P.S. #6820

Grading Plan Approved
as shown and/or noted
THOMAS P. GILLES, P.E.
Lake County Engineer
By GJH Date 6/11/90

APPROVED
SIDE LINES & SET BACK
PERRY TOWNSHIP ZONING
PERMIT NO. 4375
ZONING INSPECTOR [signature]

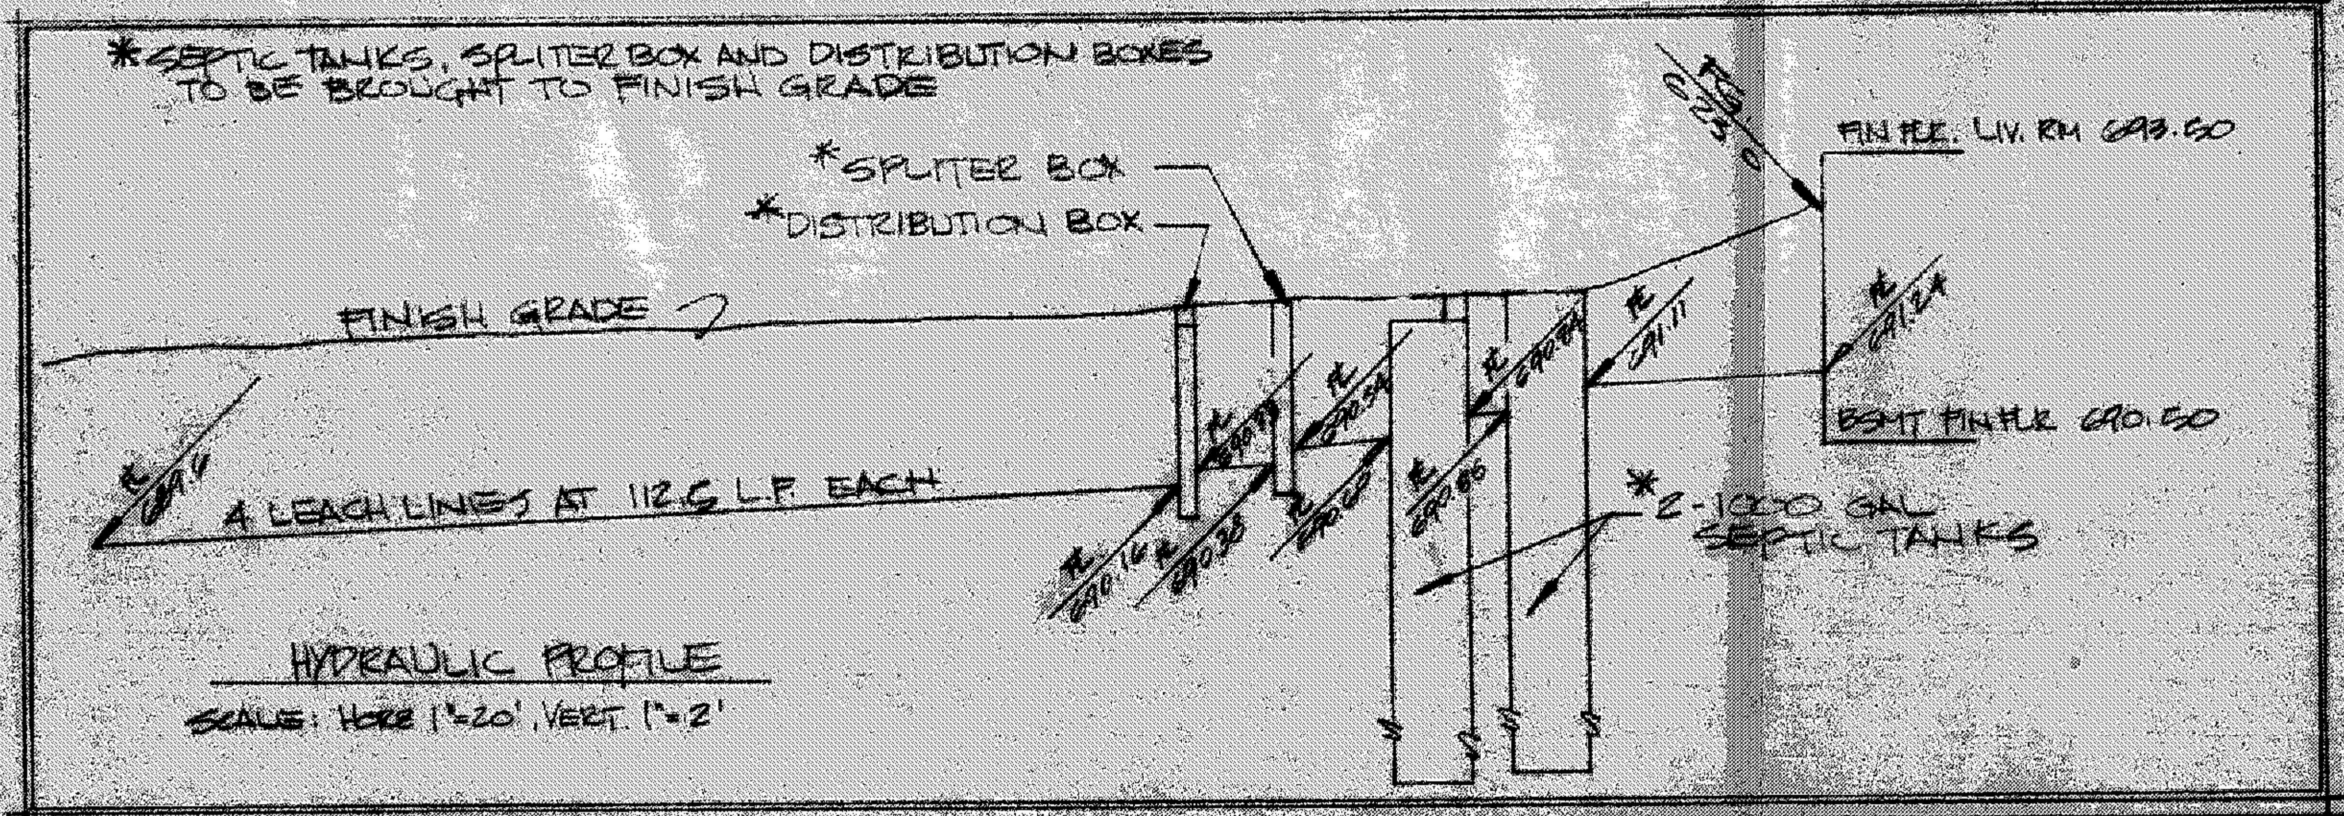

SITE PLAN - SUBLOT 25 LARCHVIEW DRIVE		
W.A. & J.A. BROWN SUB PERRY TOWNSHIP OH		
SCALE 1"=20	APPROVED BY [signature]	DRAWN BY D. NOVAK
DATE MAY 9, 1990		
PREPARED BY HIMEBAUGH AND ASSOCIATES 38083 W. SPAULDING ST. WILLOUGHBY OH 44094		
(216) 946-1761		DRAWING NUMBER 90-038

1.86' Variance