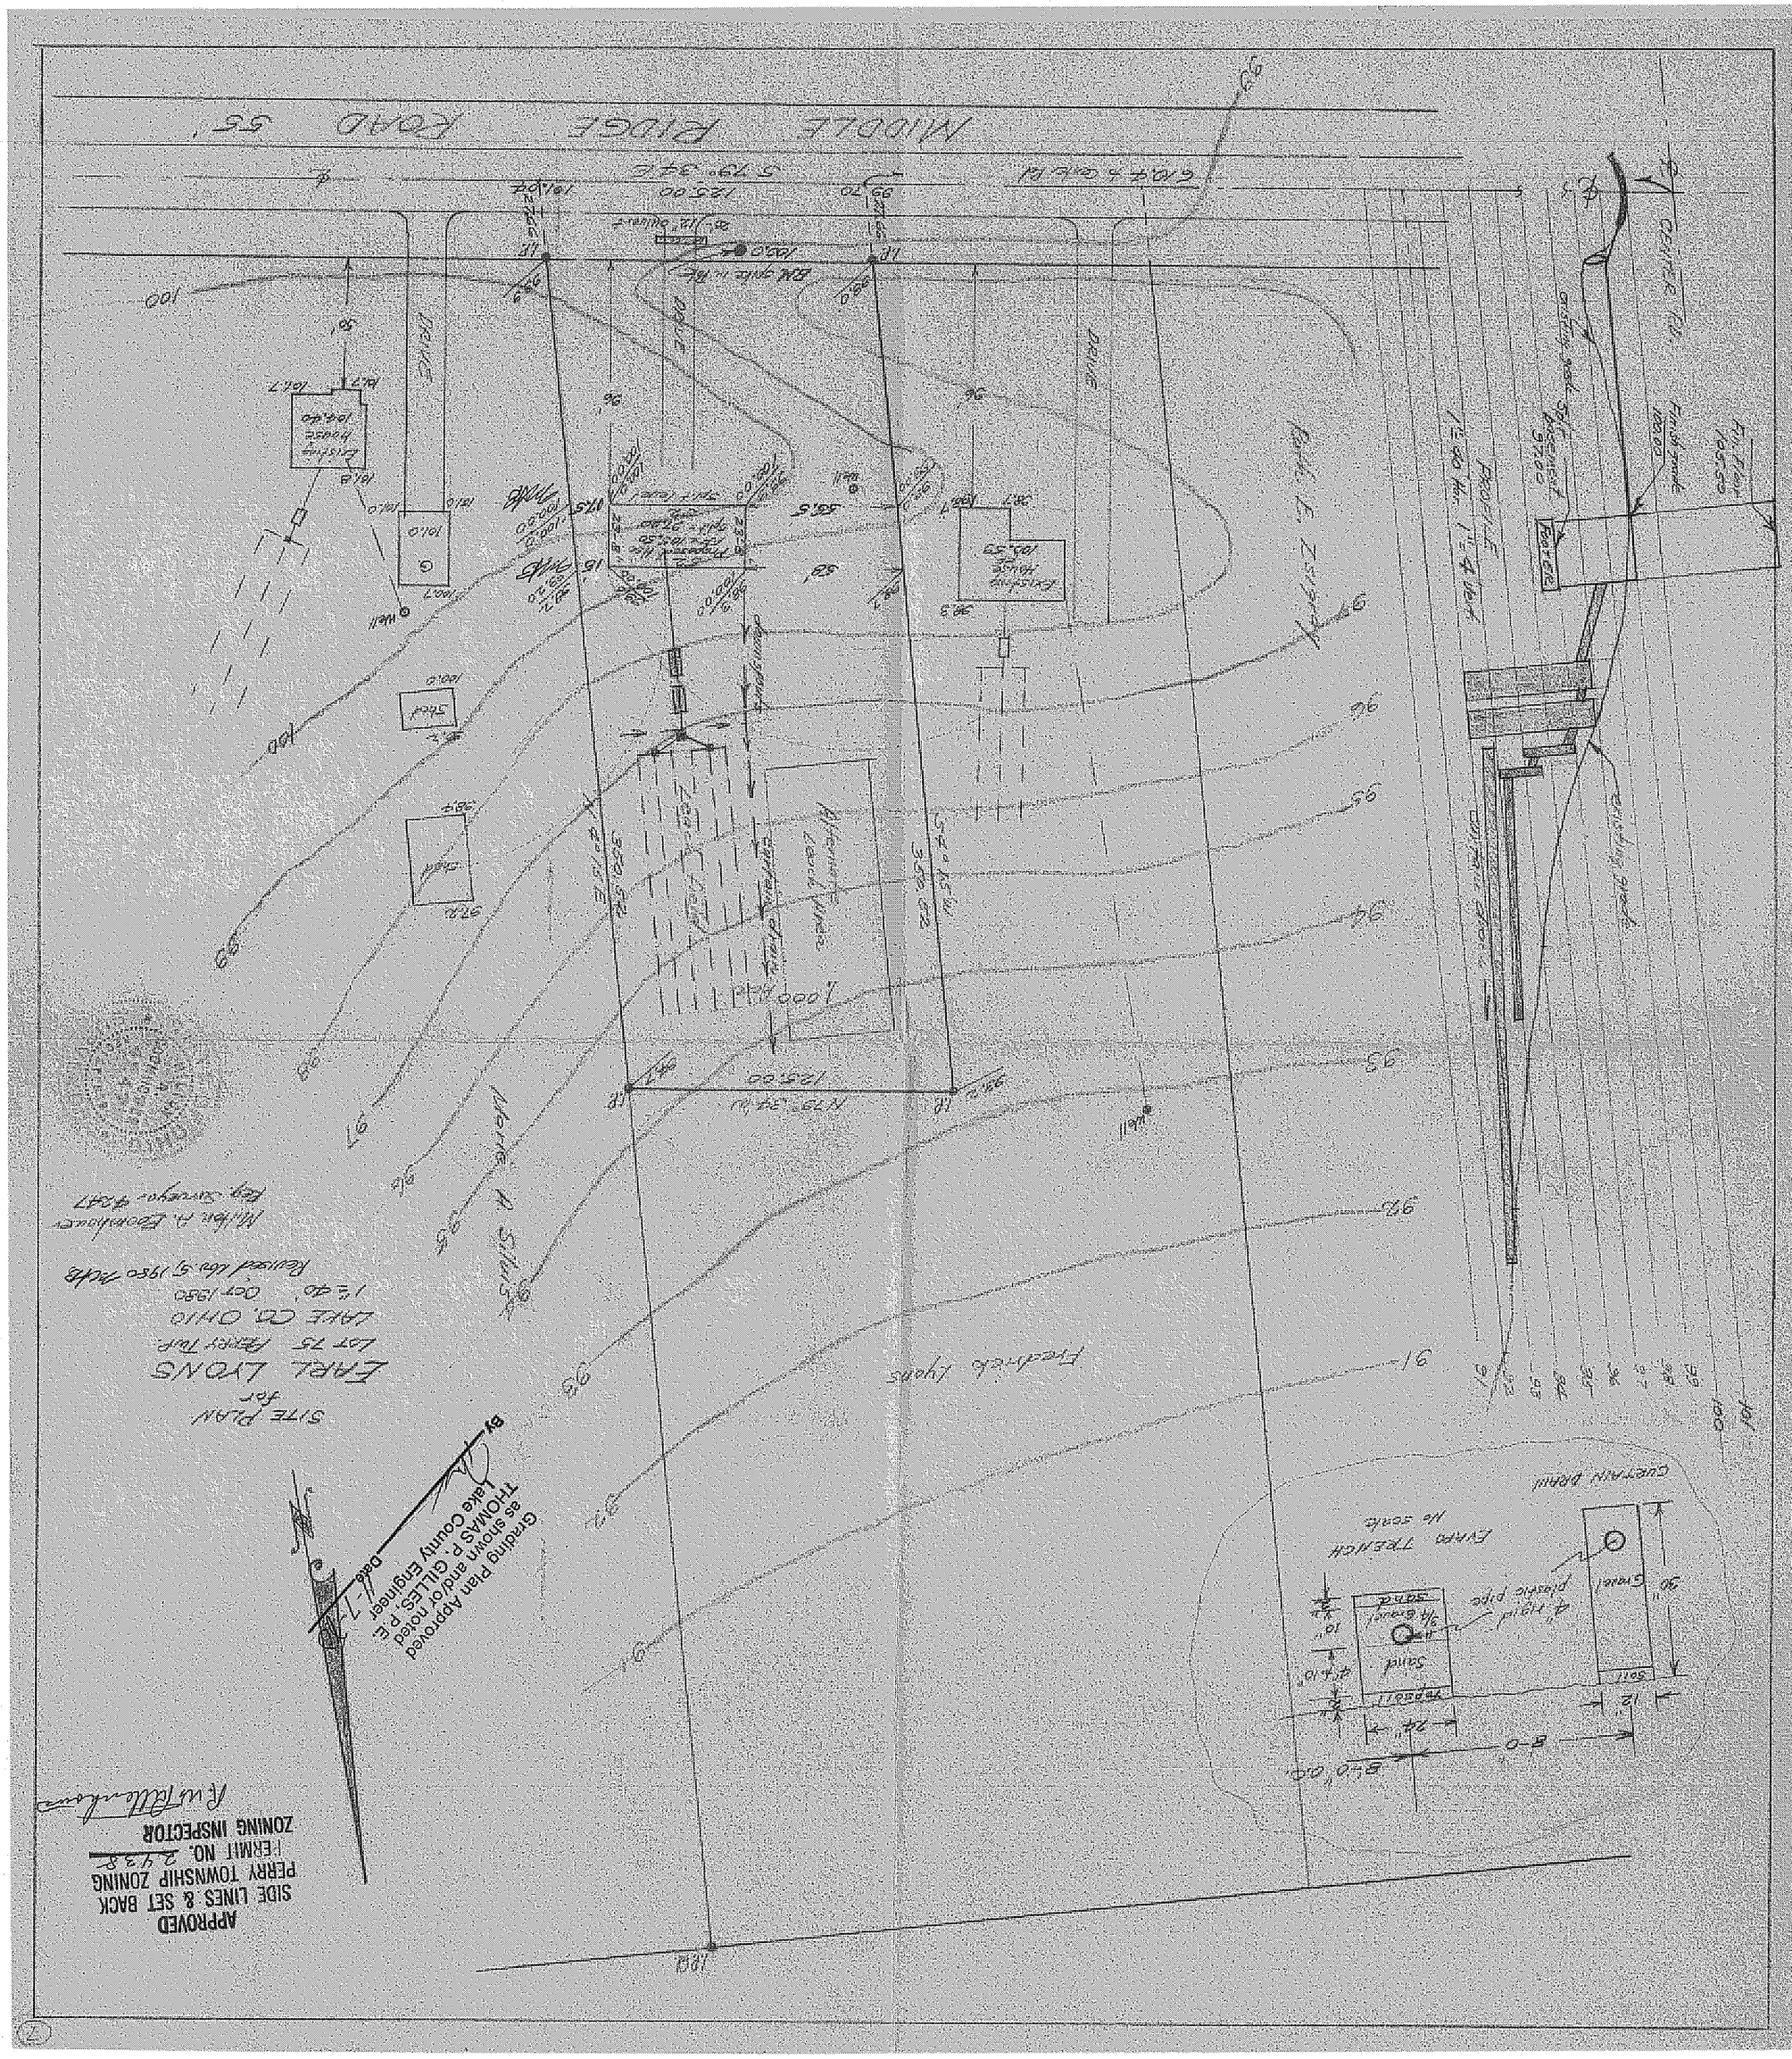
MIDDLE RIDGE ROAD 55'
SITE PLAN
for
EARL LYONS
LOT 75 PERRY TWP.
LAKE CO. OHIO
1"=40' Oct 1980
Revised Nov 5, 1980 MCKB
Milton A. Eisenhauer
Reg. Surveyor 4247
Grading Plan Approved
as shown and/or noted
THOMAS P. GILLES, P.E.
Lake County Engineer
By
Date
APPROVED
SIDE LINES & SET BACK
PERRY TOWNSHIP ZONING
PERMIT NO. 2438
ZONING INSPECTOR
Fredrick Lyons
Morris A. Silvis
Existing House
Existing House
Existing Grade
Center Rd.
Curtain Drain
Evapo Trench
No scale
Gravel
Soil
Sand
Topsoil
4" rigid plastic pipe
8'-0"
8'-0" O.C.