SITE PLAN FOR:
DRAGAN MANDIC
18207 ROSECLIFF DRIVE
CLEVELAND, OHIO

BEING PART OF THE ORIGINAL PERRY TOWNSHIP, LOT NO. 74 IN PERRY, OHIO

PREPARED BY:
WM. R. GRAY ASSOC. INC.
7547 MENTOR AVENUE
MENTOR, OHIO

DATE: NOV 7, 1977
SCALE: 1" = 20'

CERTIFICATION
I HEREBY CERTIFY THAT THIS PLAT IS CORRECT TO THE BEST OF MY KNOWLEDGE.
By: Wm. R. Gray
WM. R. GRAY-REG. SURV. 2752

Grading Plan Approved as shown and/or noted
THOMAS P. GILLES, P.E.
Lake County Engineer
By: TPG 6 Jun 78

STATE OF OHIO
WM. R. GRAY
2752
REGISTERED PROFESSIONAL SURVEYOR

APPROVED
SIDE LINES & SET
PERRY TOWNSHIP Z
PERMIT NO. 20
ZONING INSPECTOR
L. A. H

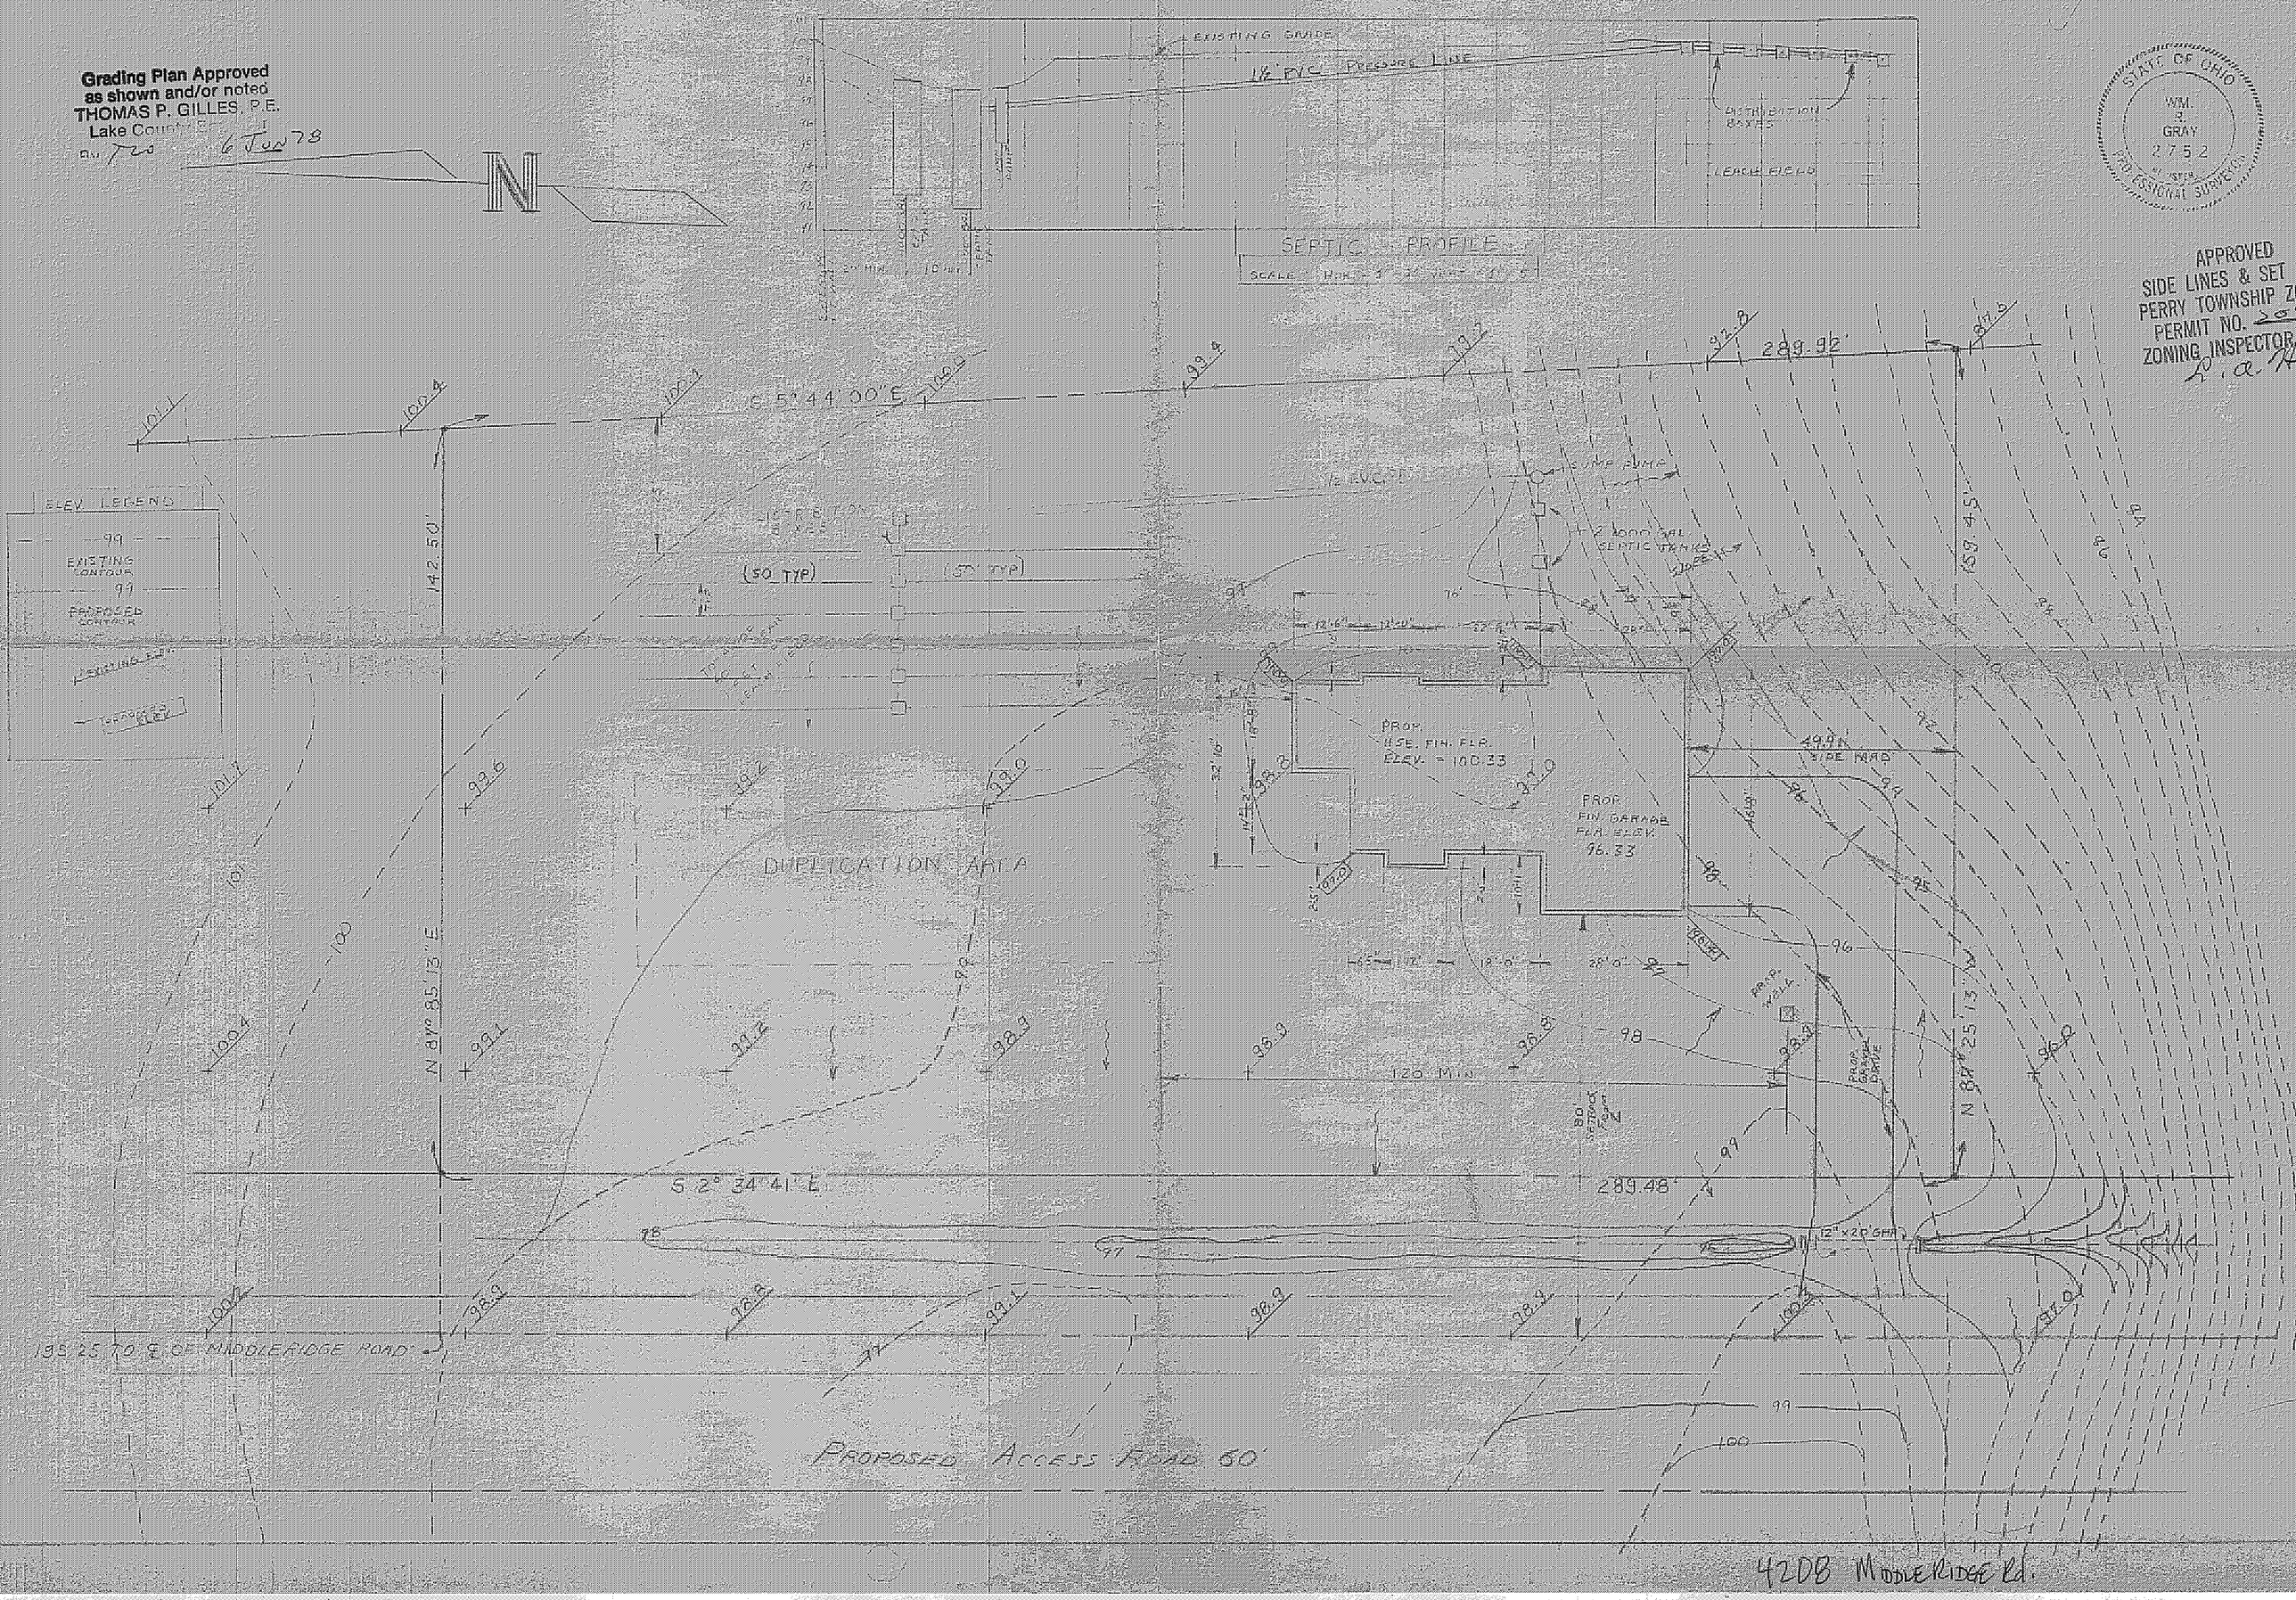

4208 MIDDLERIDGE Rd.