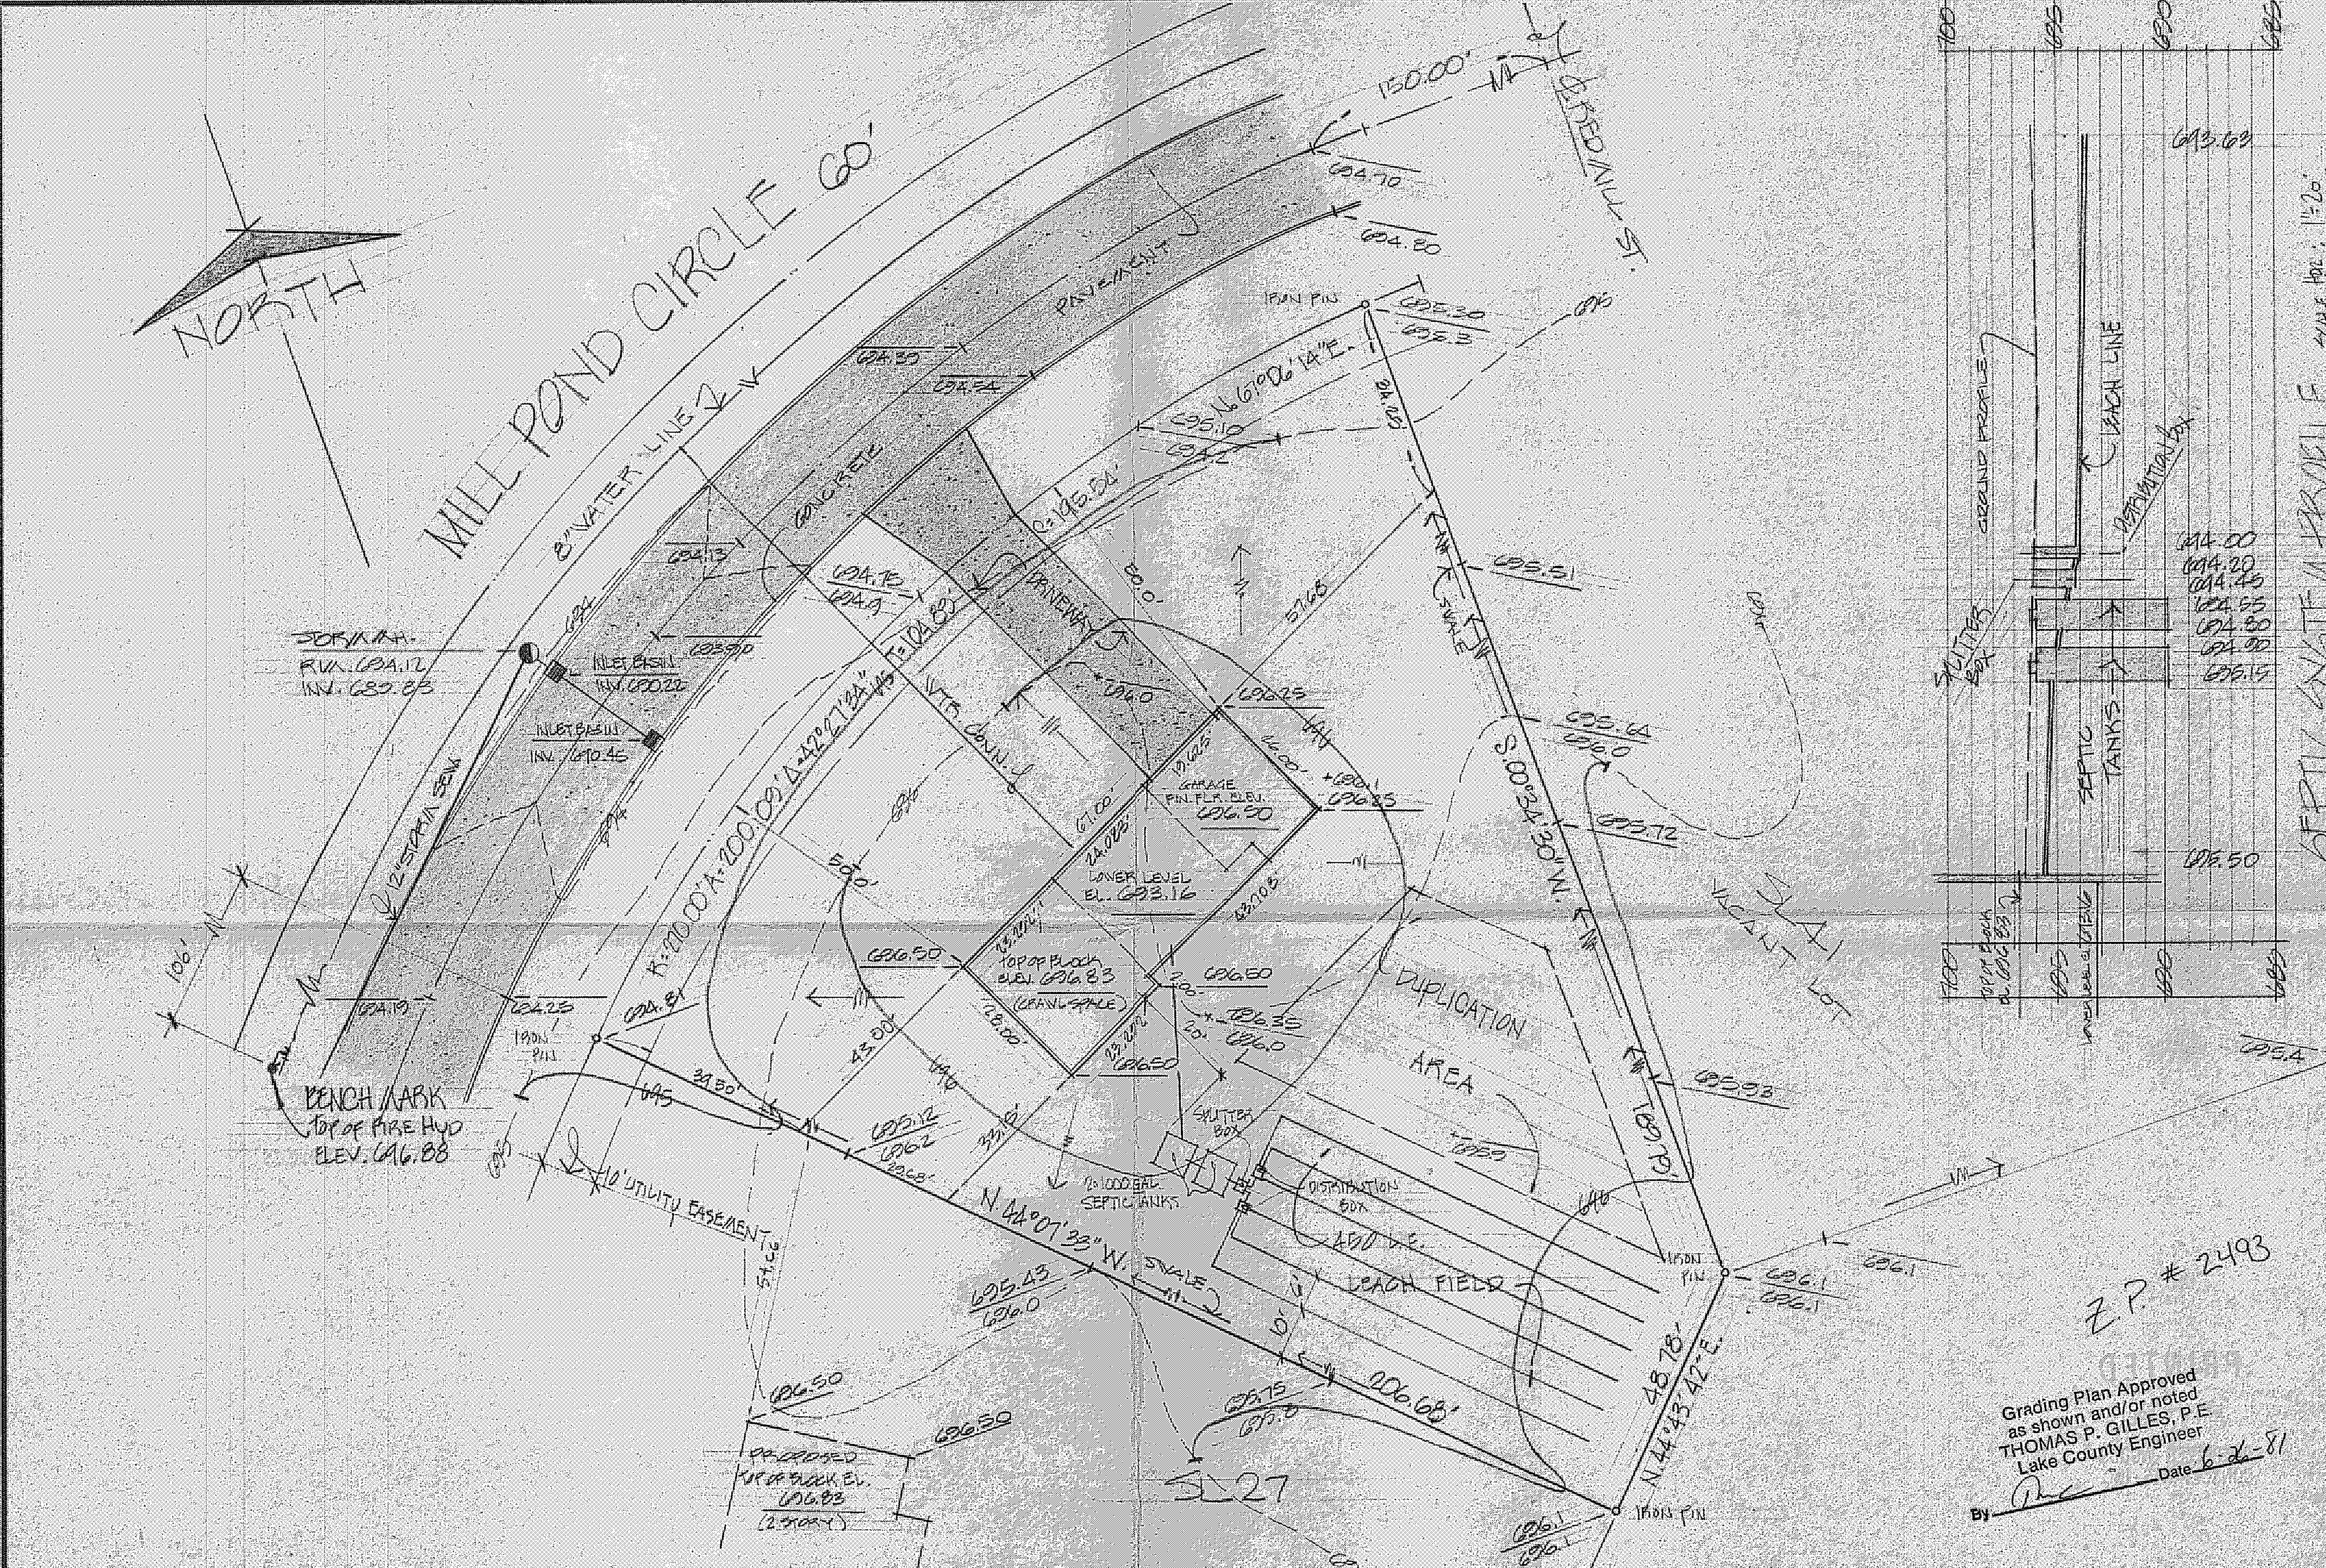

NOTE: DOWNSPOUTS SHALL EMPTY INTO SWALES ALONG PROPERTY LINES - UNDERLINED ELEVATIONS INDICATES PROPOSED GRADES

SITE PLAN FOR:

CASEMENT HOMES

1251 MADISON AVENUE PAINESVILLE, OHIO

BEING SUBLOT NO. 26 IN OAKBROOK VILLAGE SUBDIVISION IN PERRY TOWNSHIP, OHIO

DESIGN CERTIFICATION

THIS PLAT WAS PREPARED BY ME AND IS CORRECT TO THE BEST OF MY KNOWLEDGE AND BELIEF.

REG. SURVEYOR NO. 4785

AS BUILT CERTIFICATION

I HEREBY CERTIFY THAT THE CIRCLED GRADES ARE EXISTING FINISH GRADES CHECKED IN THE FIELD ON AND THAT SURVEY IS CORRECT TO THE BEST OF MY KNOWLEDGE AND BELIEF.

REG. SURVEYOR NO.

DATE JUNE 2, 1981
SCALE 1" = 20'
DRAWN BY
CH'K'D BY
F.B.# PG.

COLPETZER · WOODS CONSULTANTS, INC.
MENTOR, OHIO 44060

SHEET 1

CONTRACT NO. 79-269