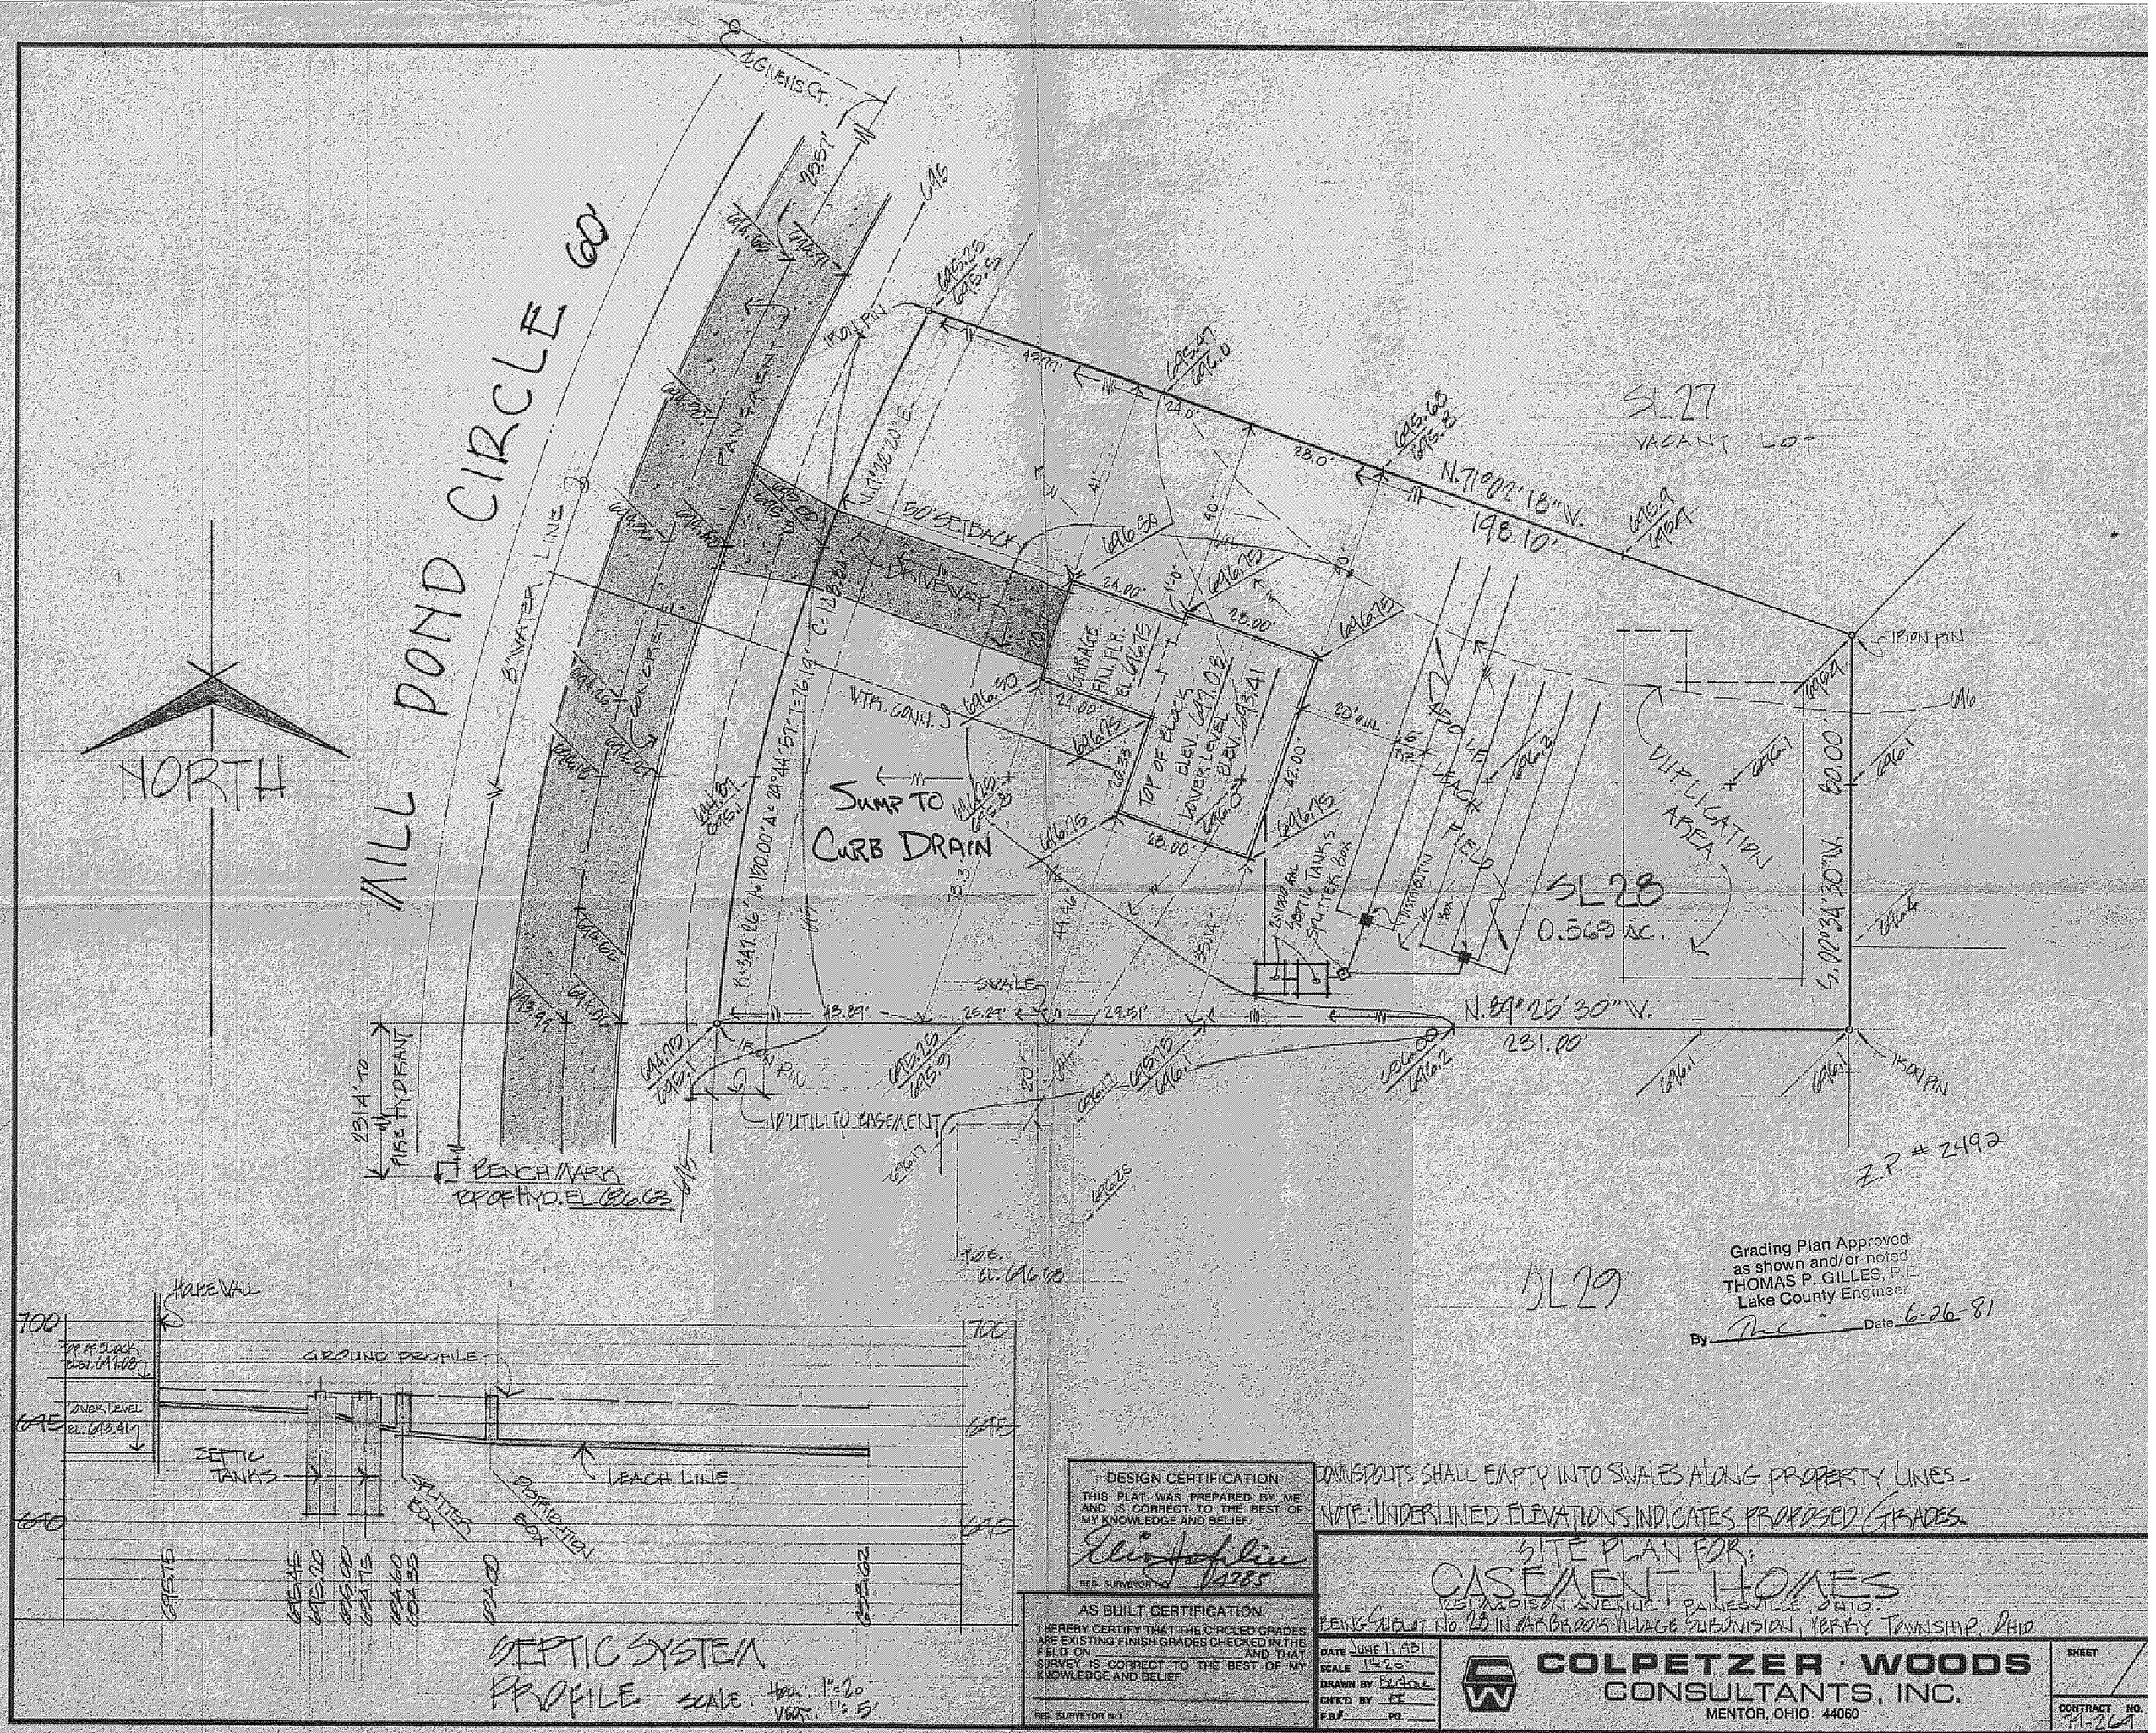

Grading Plan Approved as shown and/or noted
THOMAS P. GILLES, P.E.
Lake County Engineer
By [signature] Date 6-26-81

DOWNSPOUTS SHALL EMPTY INTO SWALES ALONG PROPERTY LINES.
NOTE: UNDERLINED ELEVATIONS INDICATES PROPOSED GRADES.

DESIGN CERTIFICATION
THIS PLAT WAS PREPARED BY ME AND IS CORRECT TO THE BEST OF MY KNOWLEDGE AND BELIEF.
[signature]
REG. SURVEYOR NO. 14285

AS BUILT CERTIFICATION
I HEREBY CERTIFY THAT THE CIRCLED GRADES ARE EXISTING FINISH GRADES CHECKED IN THE FIELD ON _____ AND THAT SURVEY IS CORRECT TO THE BEST OF MY KNOWLEDGE AND BELIEF.
REG. SURVEYOR NO.

SITE PLAN FOR:
CASEMENT HOMES
1251 MADISON AVENUE · PAINESVILLE, OHIO.
BEING SUBLOT NO. 28 IN OAKBROOK VILLAGE SUBDIVISION, PERRY TOWNSHIP, OHIO

DATE JUNE 1, 1981
SCALE 1"=20'
DRAWN BY [illegible]
CH'K'D BY [illegible]
F.B.# ____ PG. ____

COLPETZER · WOODS CONSULTANTS, INC.
MENTOR, OHIO 44060

SHEET 1
CONTRACT NO. 79-269