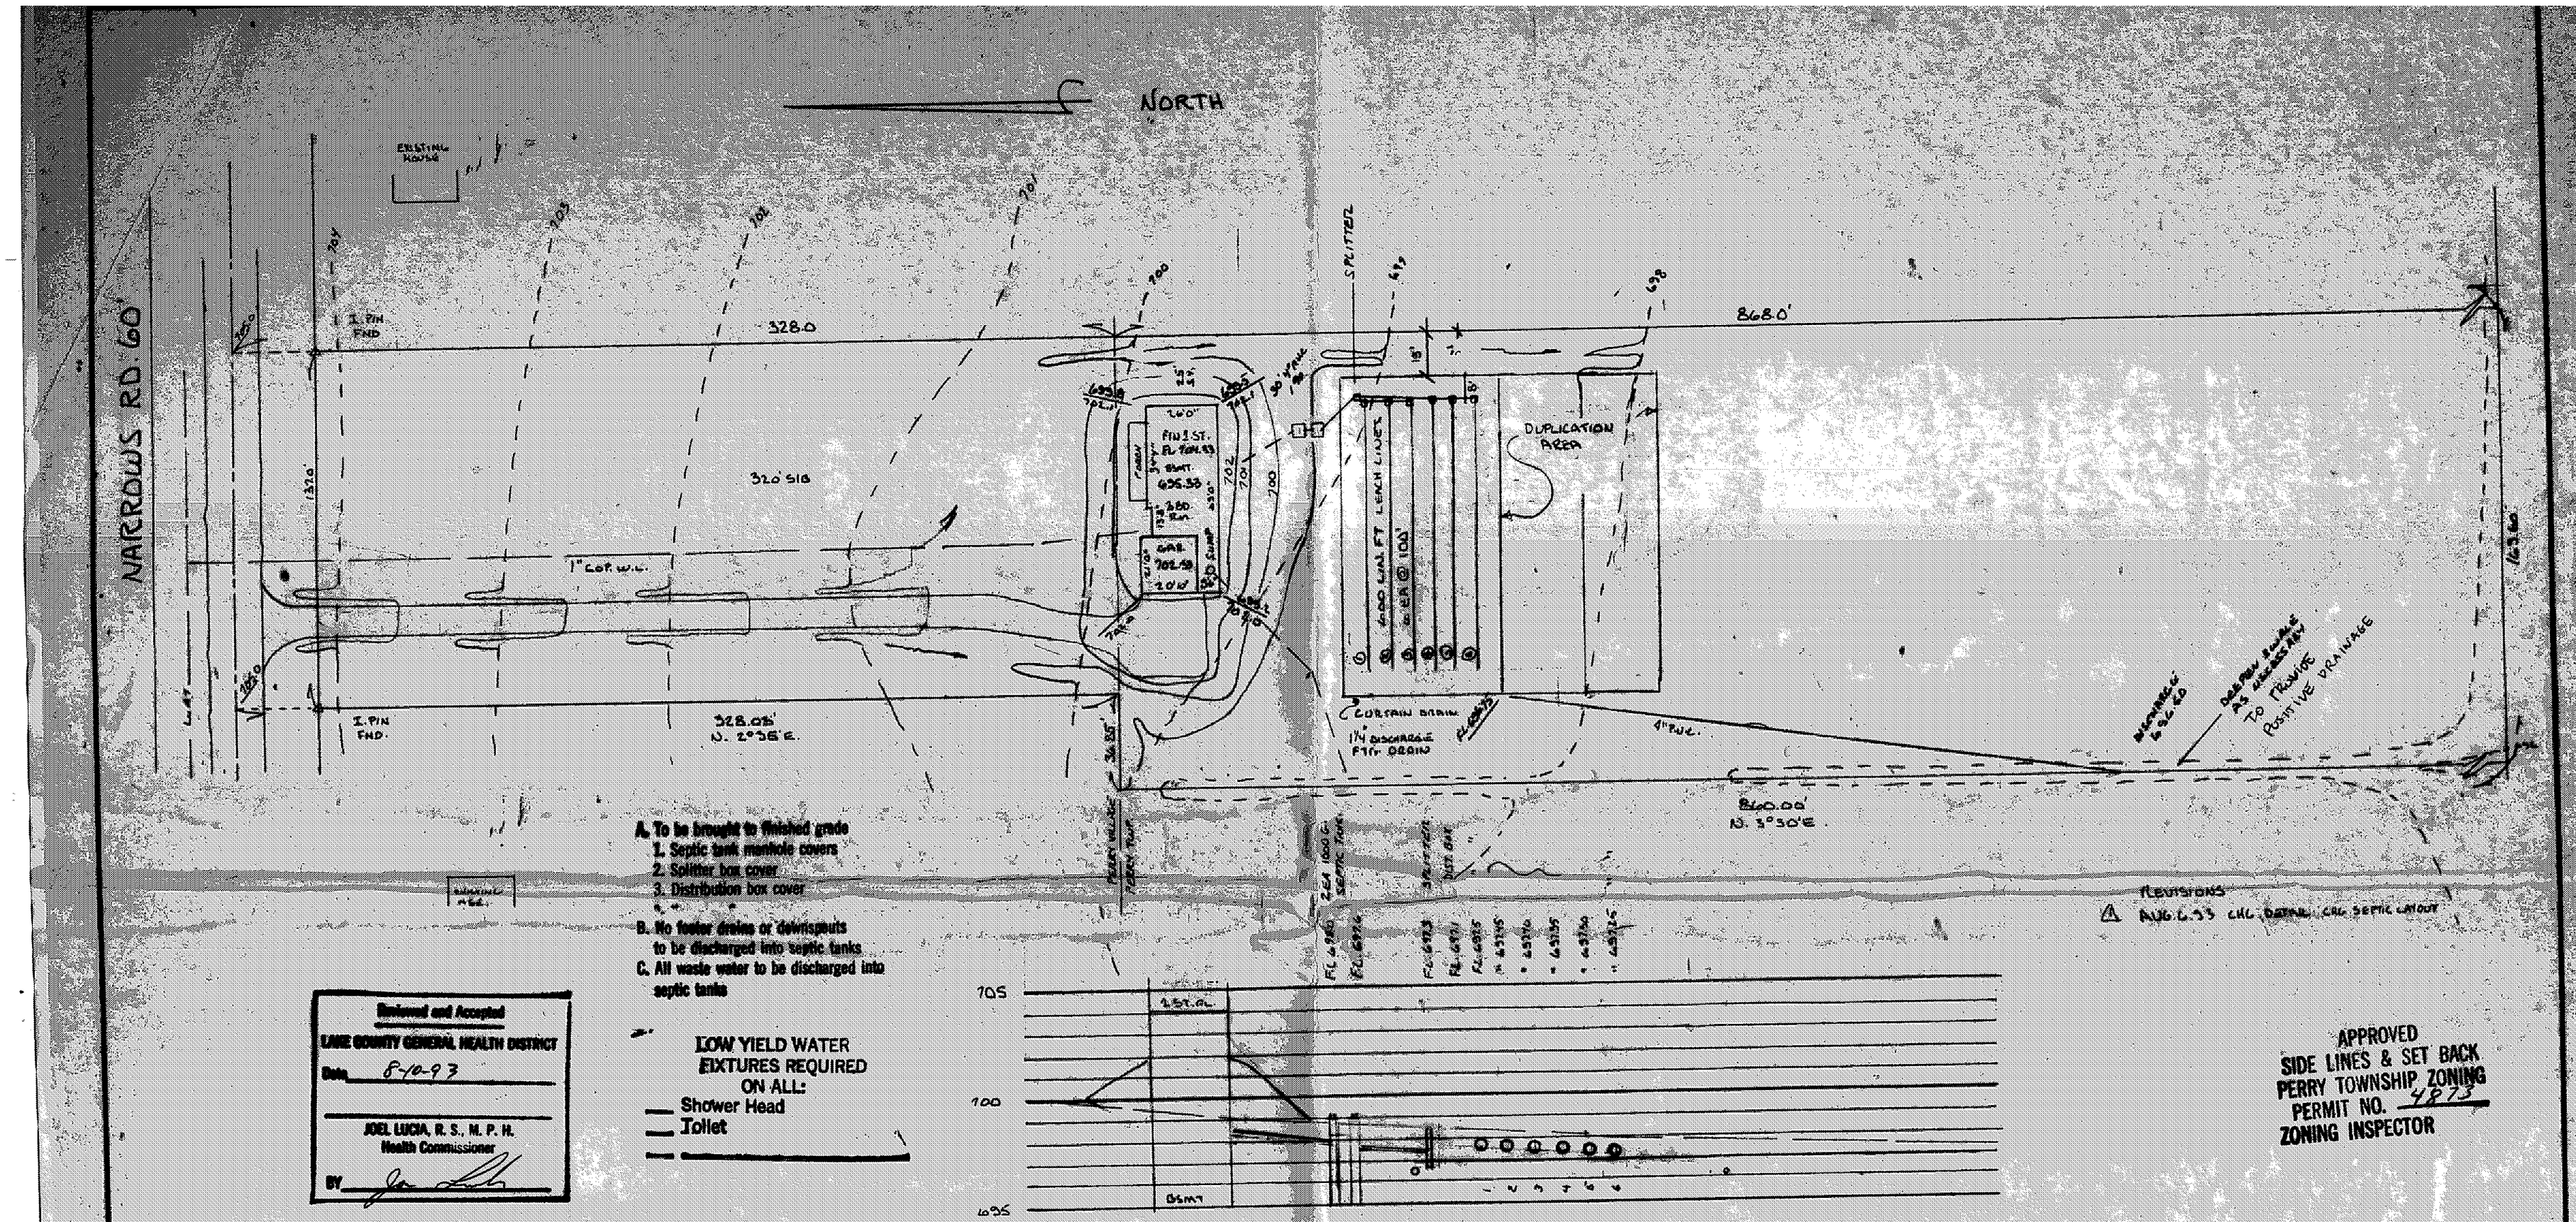

A. To be brought to finished grade
1. Septic tank manhole covers
2. Splitter box cover
3. Distribution box cover
B. No footer drains or downspouts to be discharged into septic tanks
C. All waste water to be discharged into septic tanks

Reviewed and Accepted
LAKE COUNTY GENERAL HEALTH DISTRICT
Date 8-10-93
JOEL LUCIA, R. S., M. P. H.
Health Commissioner
BY [signature]

LOW YIELD WATER FIXTURES REQUIRED ON ALL:
___ Shower Head
___ Toilet

SEWAGE DISPOSAL PERMIT MUST BE OBTAINED BY A LAKE COUNTY LICENSED INSTALLER BEFORE INSTALLATION IS STARTED.

APPROVED
SIDE LINES & SET BACK
PERRY TOWNSHIP ZONING
PERMIT NO. 4873
ZONING INSPECTOR

"I, the undersigned hereby certify that this topography, indicated by 6", 1' or 2' contours, and elevations shown hereon represent an actual field survey made by me on the 26 day of JULY, 1993 and that the elevations were taken at appropriate intervals and that as of that date they existed as indicated hereon."

[signature] Name — RS 6356 Reg. No

STATE OF OHIO
JOHN CLOUD SKONIECZNY
S-6356
REGISTERED SURVEYOR

I CERTIFY THAT THIS PLAN WAS PREPARED BY ME AND IS CORRECT TO THE BEST OF MY KNOWLEDGE AND BELIEF
[signature]
REG. SURVEYOR #6356

JOHN C. SKONIECZNY
7739 VIEWMOUNT DR.
PAINESVILLE, OHIO 44077
PH. 352-7742

Grading Plan Approved as shown and/or noted
THOMAS P. GILLES, P.E.
Lake County Engineer
By GJH Date 8.19.93

ROOF DRAINS SHALL DISCHARGE TO SPLASH BLOCKS.

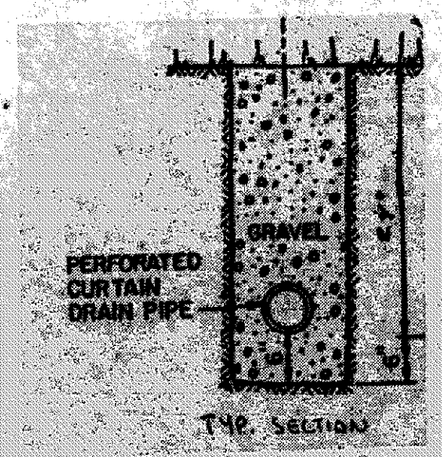

TYP. SECTION
CURTAIN DRAIN
THE CURTAIN DRAIN MUST BE 6" DEEPER THEN THE DEEPEST LEACHING TRENCH BOTTOM.

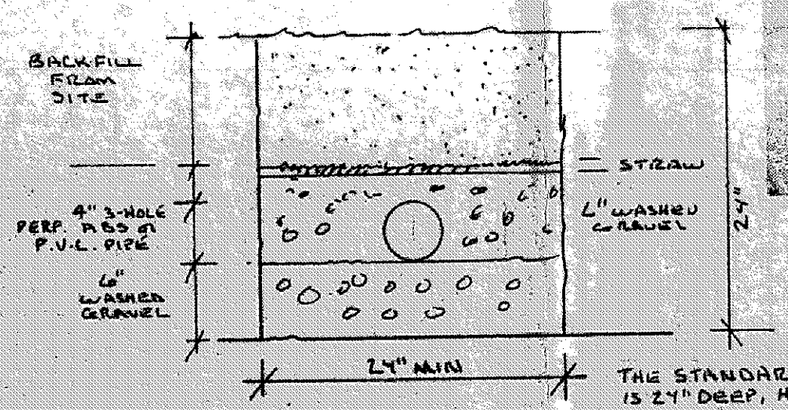

TYP. SECTION
LEACHING TRENCH

THE STANDARD LEACHING TRENCH IS 24" DEEP, HOWEVER THE TRENCH CAN VERY BETWEEN 18 TO 30 INCHES DEEP IF NECESSARY. GRAVEL REQUIREMENTS ARE STANDARD - AMOUNT OF BACKFILL WOULD VARY.

EXISTING GRADES
PROPOSED GRADES
SWALE

SITE PLAN FOR:
FRANCO GIANFAGNA
SEC. EVANGELINE CLEVELAND, OHIO

SCALE: 1" = 40'	APPROVED BY	DRAWN BY J.C.S.
DATE: AUG 93		

AS DESCRIBED IN VOL. 617-595 L.C.R.D.
TOWNSHIP OF PERRY & VILLAGE OF PERRY
COUNTY OF LAKE STATE OF OHIO

DRAWING NUMBER 93-1183