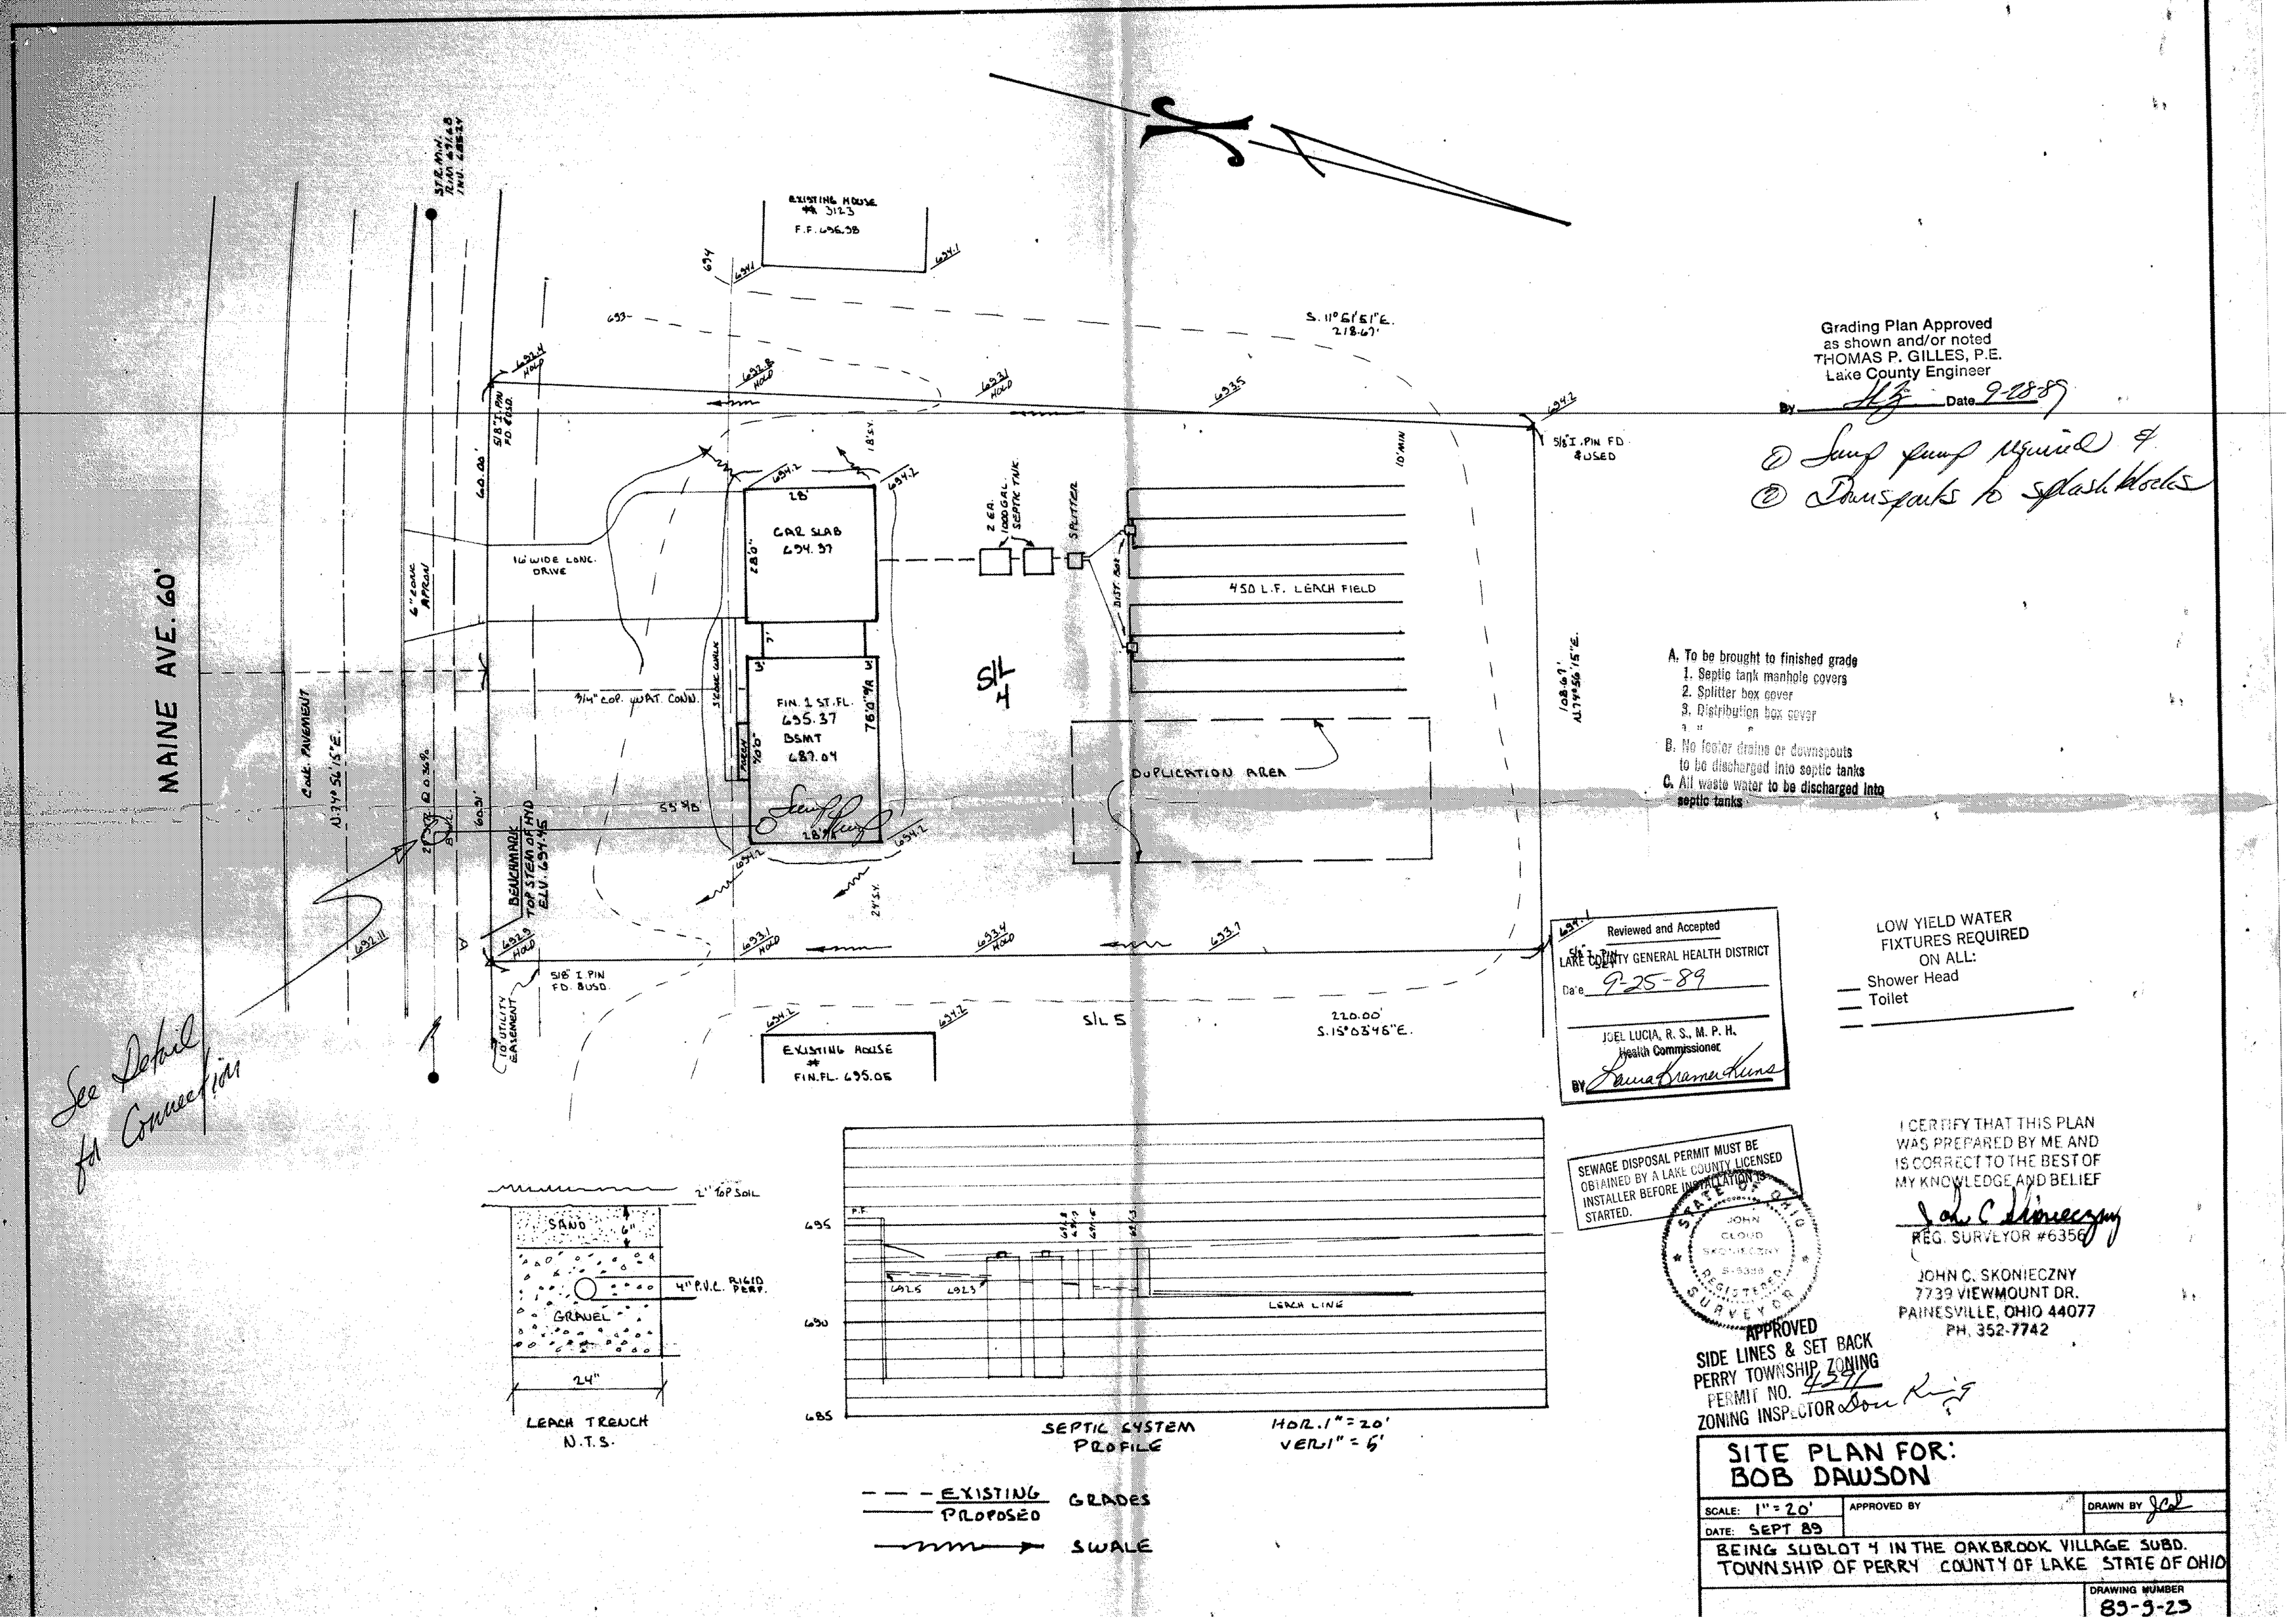

Grading Plan Approved
as shown and/or noted
THOMAS P. GILLES, P.E.
Lake County Engineer
By [signature] Date 9-28-89

① Sump pump required &
② Downspouts to splash blocks

A. To be brought to finished grade
1. Septic tank manhole covers
2. Splitter box cover
3. Distribution box cover
4. " "
B. No footer drains or downspouts to be discharged into septic tanks
C. All waste water to be discharged into septic tanks

Reviewed and Accepted
LAKE COUNTY GENERAL HEALTH DISTRICT
Date 9-25-89
JOEL LUCIA, R. S., M. P. H.
Health Commissioner
BY [signature]

LOW YIELD WATER FIXTURES REQUIRED ON ALL:
— Shower Head
— Toilet

SEWAGE DISPOSAL PERMIT MUST BE OBTAINED BY A LAKE COUNTY LICENSED INSTALLER BEFORE INSTALLATION IS STARTED.

STATE OF OHIO JOHN CLOUD SKONIECZNY REGISTERED SURVEYOR

I CERTIFY THAT THIS PLAN WAS PREPARED BY ME AND IS CORRECT TO THE BEST OF MY KNOWLEDGE AND BELIEF
[signature]
REG. SURVEYOR #6356

JOHN C. SKONIECZNY
7739 VIEWMOUNT DR.
PAINESVILLE, OHIO 44077
PH. 352-7742

APPROVED
SIDE LINES & SET BACK
PERRY TOWNSHIP ZONING
PERMIT NO. 4291
ZONING INSPECTOR [signature]

SITE PLAN FOR: BOB DAWSON

SCALE: 1" = 20'	APPROVED BY	DRAWN BY [signature]
DATE: SEPT 89		

BEING SUBLOT 4 IN THE OAKBROOK VILLAGE SUBD.
TOWNSHIP OF PERRY COUNTY OF LAKE STATE OF OHIO

DRAWING NUMBER 89-9-23