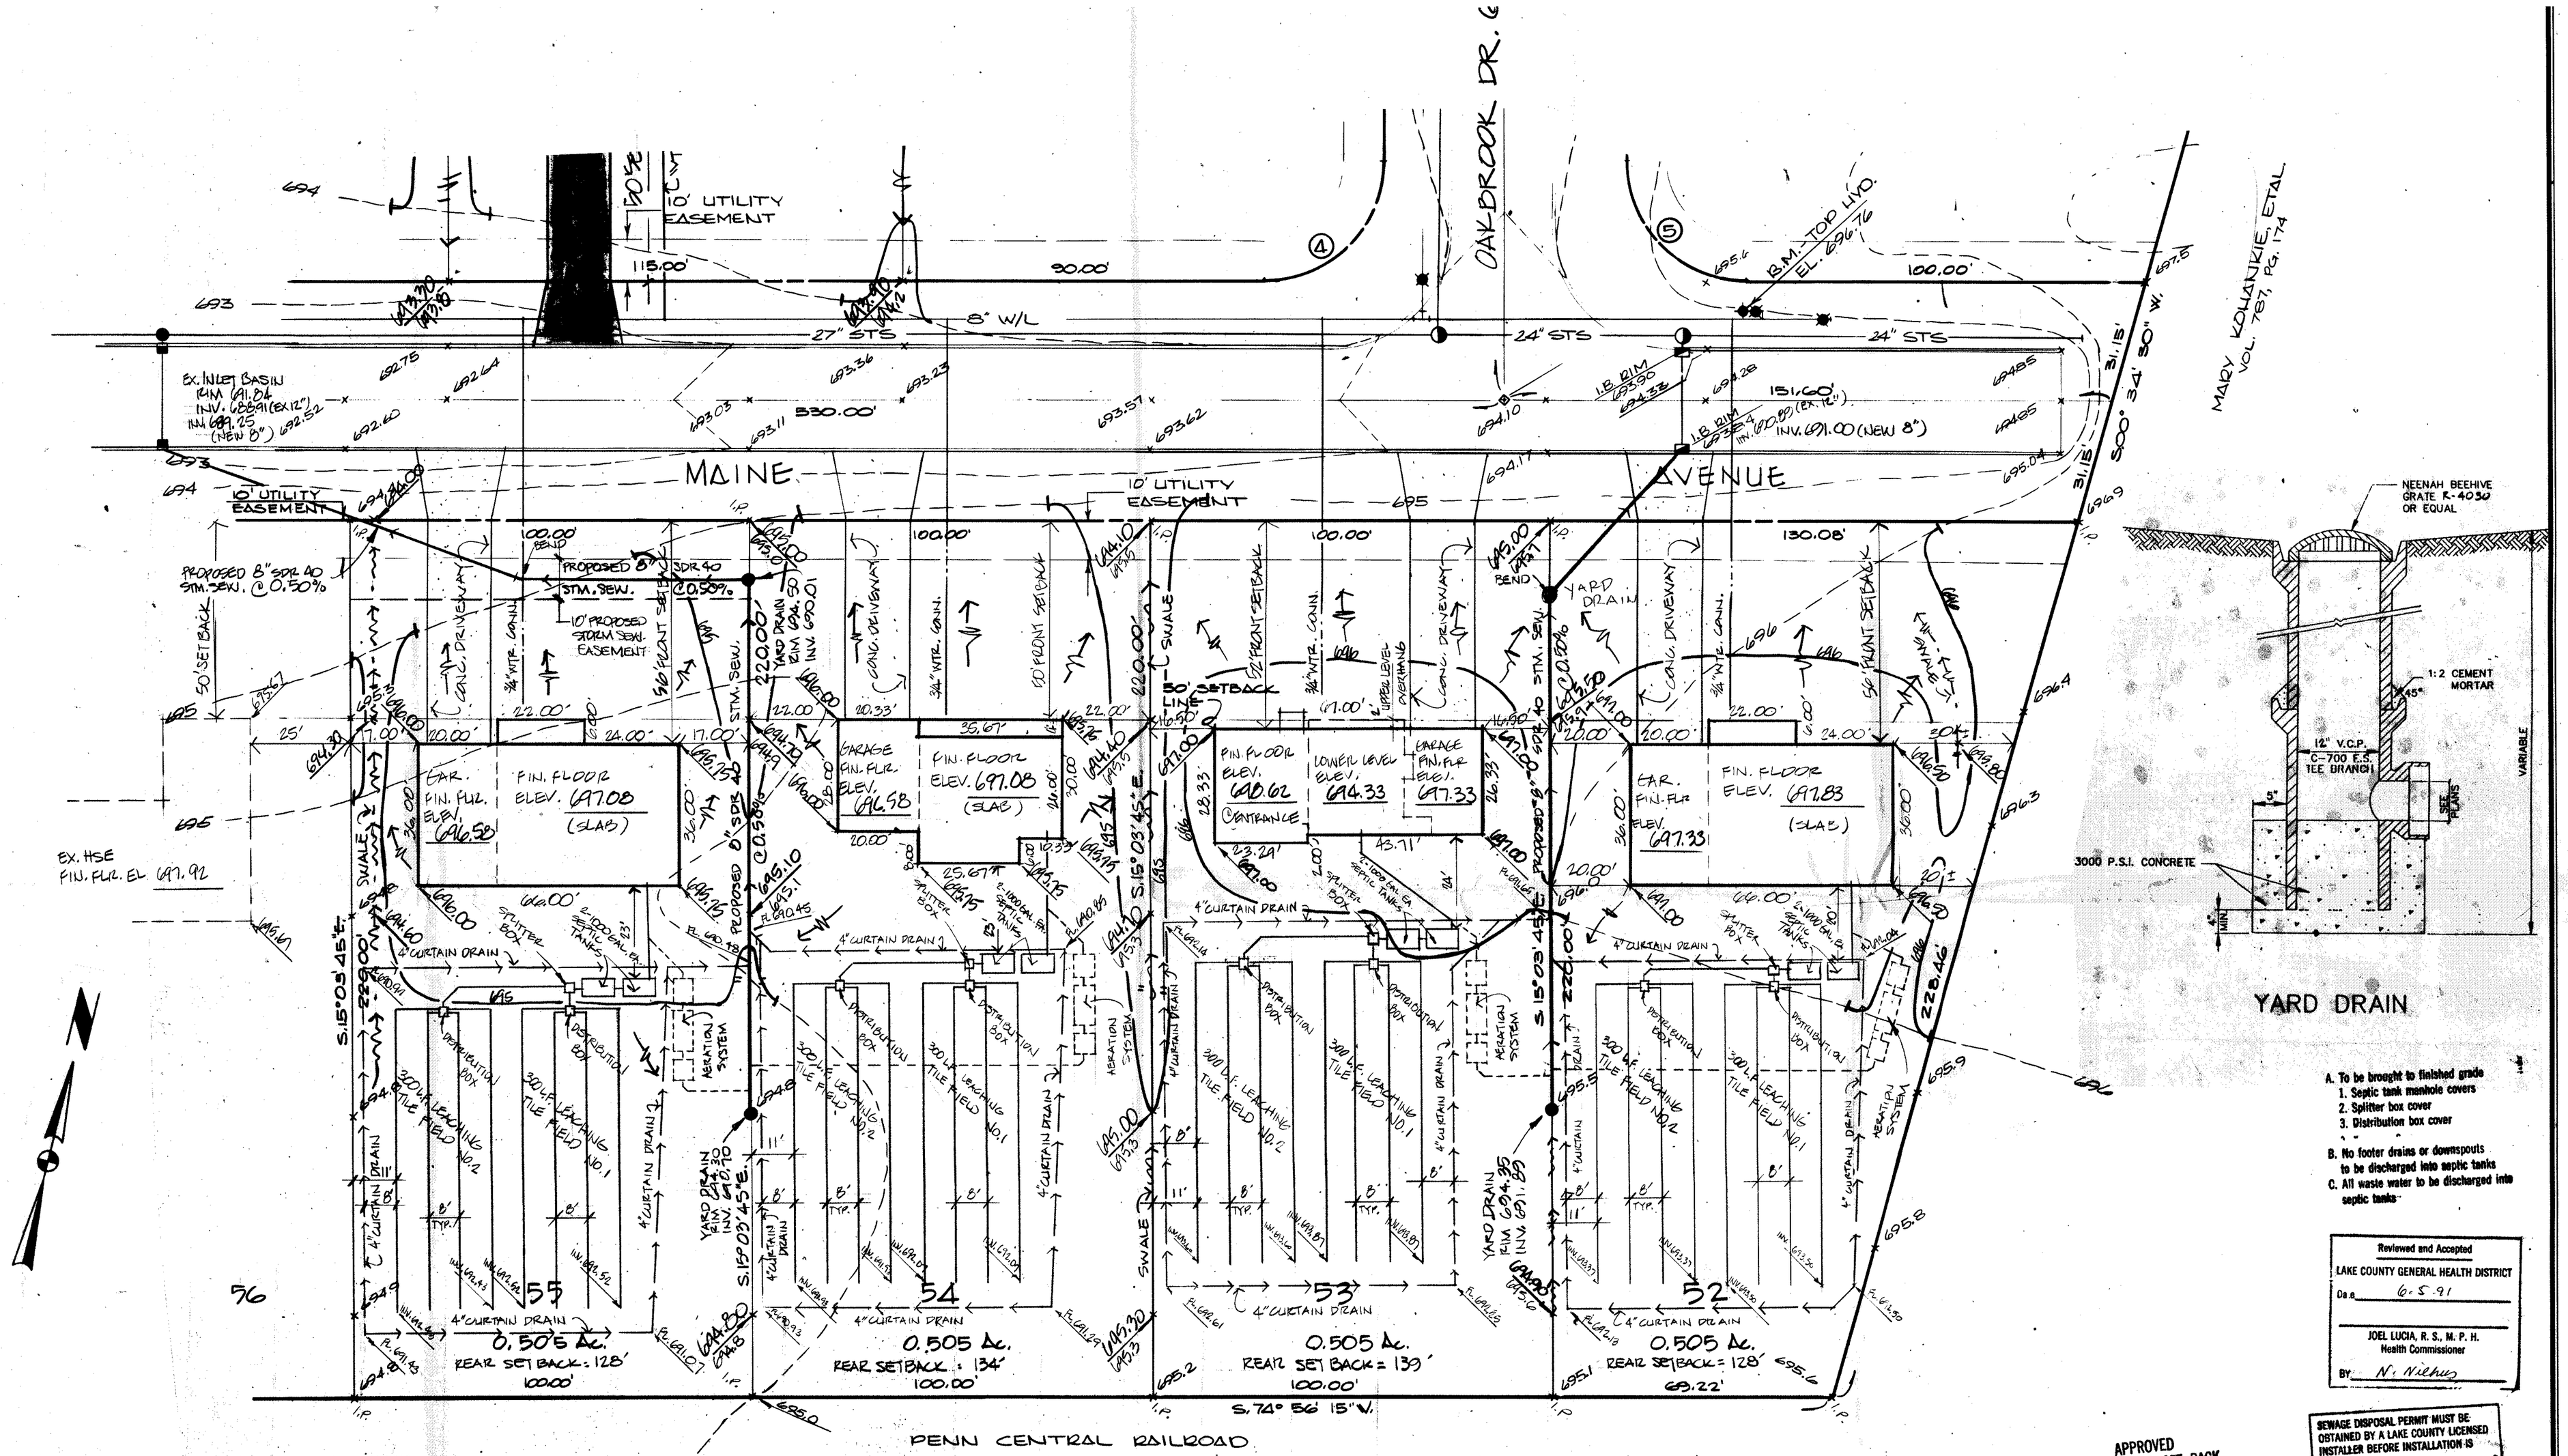

A. To be brought to finished grade
1. Septic tank manhole covers
2. Splitter box cover
3. Distribution box cover

B. No footer drains or downspouts to be discharged into septic tanks

C. All waste water to be discharged into septic tanks

Reviewed and Accepted
LAKE COUNTY GENERAL HEALTH DISTRICT
Date 6-5-91
JOEL LUCIA, R. S., M. P. H.
Health Commissioner
BY: N. Niehus

SEWAGE DISPOSAL PERMIT MUST BE OBTAINED BY A LAKE COUNTY LICENSED INSTALLER BEFORE INSTALLATION IS STARTED.

APPROVED
SIDE LINES & SET BACK
PERRY TOWNSHIP ZONING
PERMIT NO. 1447
ZONING INSPECTOR

Grading Plan Approved as shown and/or noted
THOMAS P. GILLES, P.E.
Lake County Engineer
By GJH Date 6/17/91

INSTALL YARD DRAIN AT BEND.

LOW YIELD WATER FIXTURES REQUIRED ON ALL:
Shower Head
Toilet

CERTIFICATION:

I HEREBY CERTIFY THAT THIS PLAT WAS PREPARED BY ME AND IS CORRECT TO THE BEST OF MY KNOWLEDGE AND BELIEF.

BY: Richard J. Bilski

RICHARD J. BILSKI, P.S. NO. 5244

NOTE: AERATION SYSTEM TO BE USED FOR DUPLICATION SHOULD ORIGINAL SYSTEM FAIL - (SL 52, 53, 54 & 55)

CT Consultants, Inc.
Engineers • Architects • Planners
Willoughby • Mentor • Columbus • Lorain • North Canton • Youngstown

STATE OF OHIO RICHARD BILSKI 5244 REGISTERED

REV. NO.	DESCRIPTION	DATE	BY	CH'K'D.

DATE: May 3, 1991
DRAWN BY: CB
CHECKED BY:
APPROVED BY:

SITE PLAN FOR:
B.S.M. INC.
1291 MADISON AVENUE PAINESVILLE, OHIO.
BEING SUBLOT NO. 52, 53, 54 & 55 IN OAKBROOK

SCALES
HOR. 1" = 20'
VERT.
CONTRACT No. 91-211
SHEET NO. OF