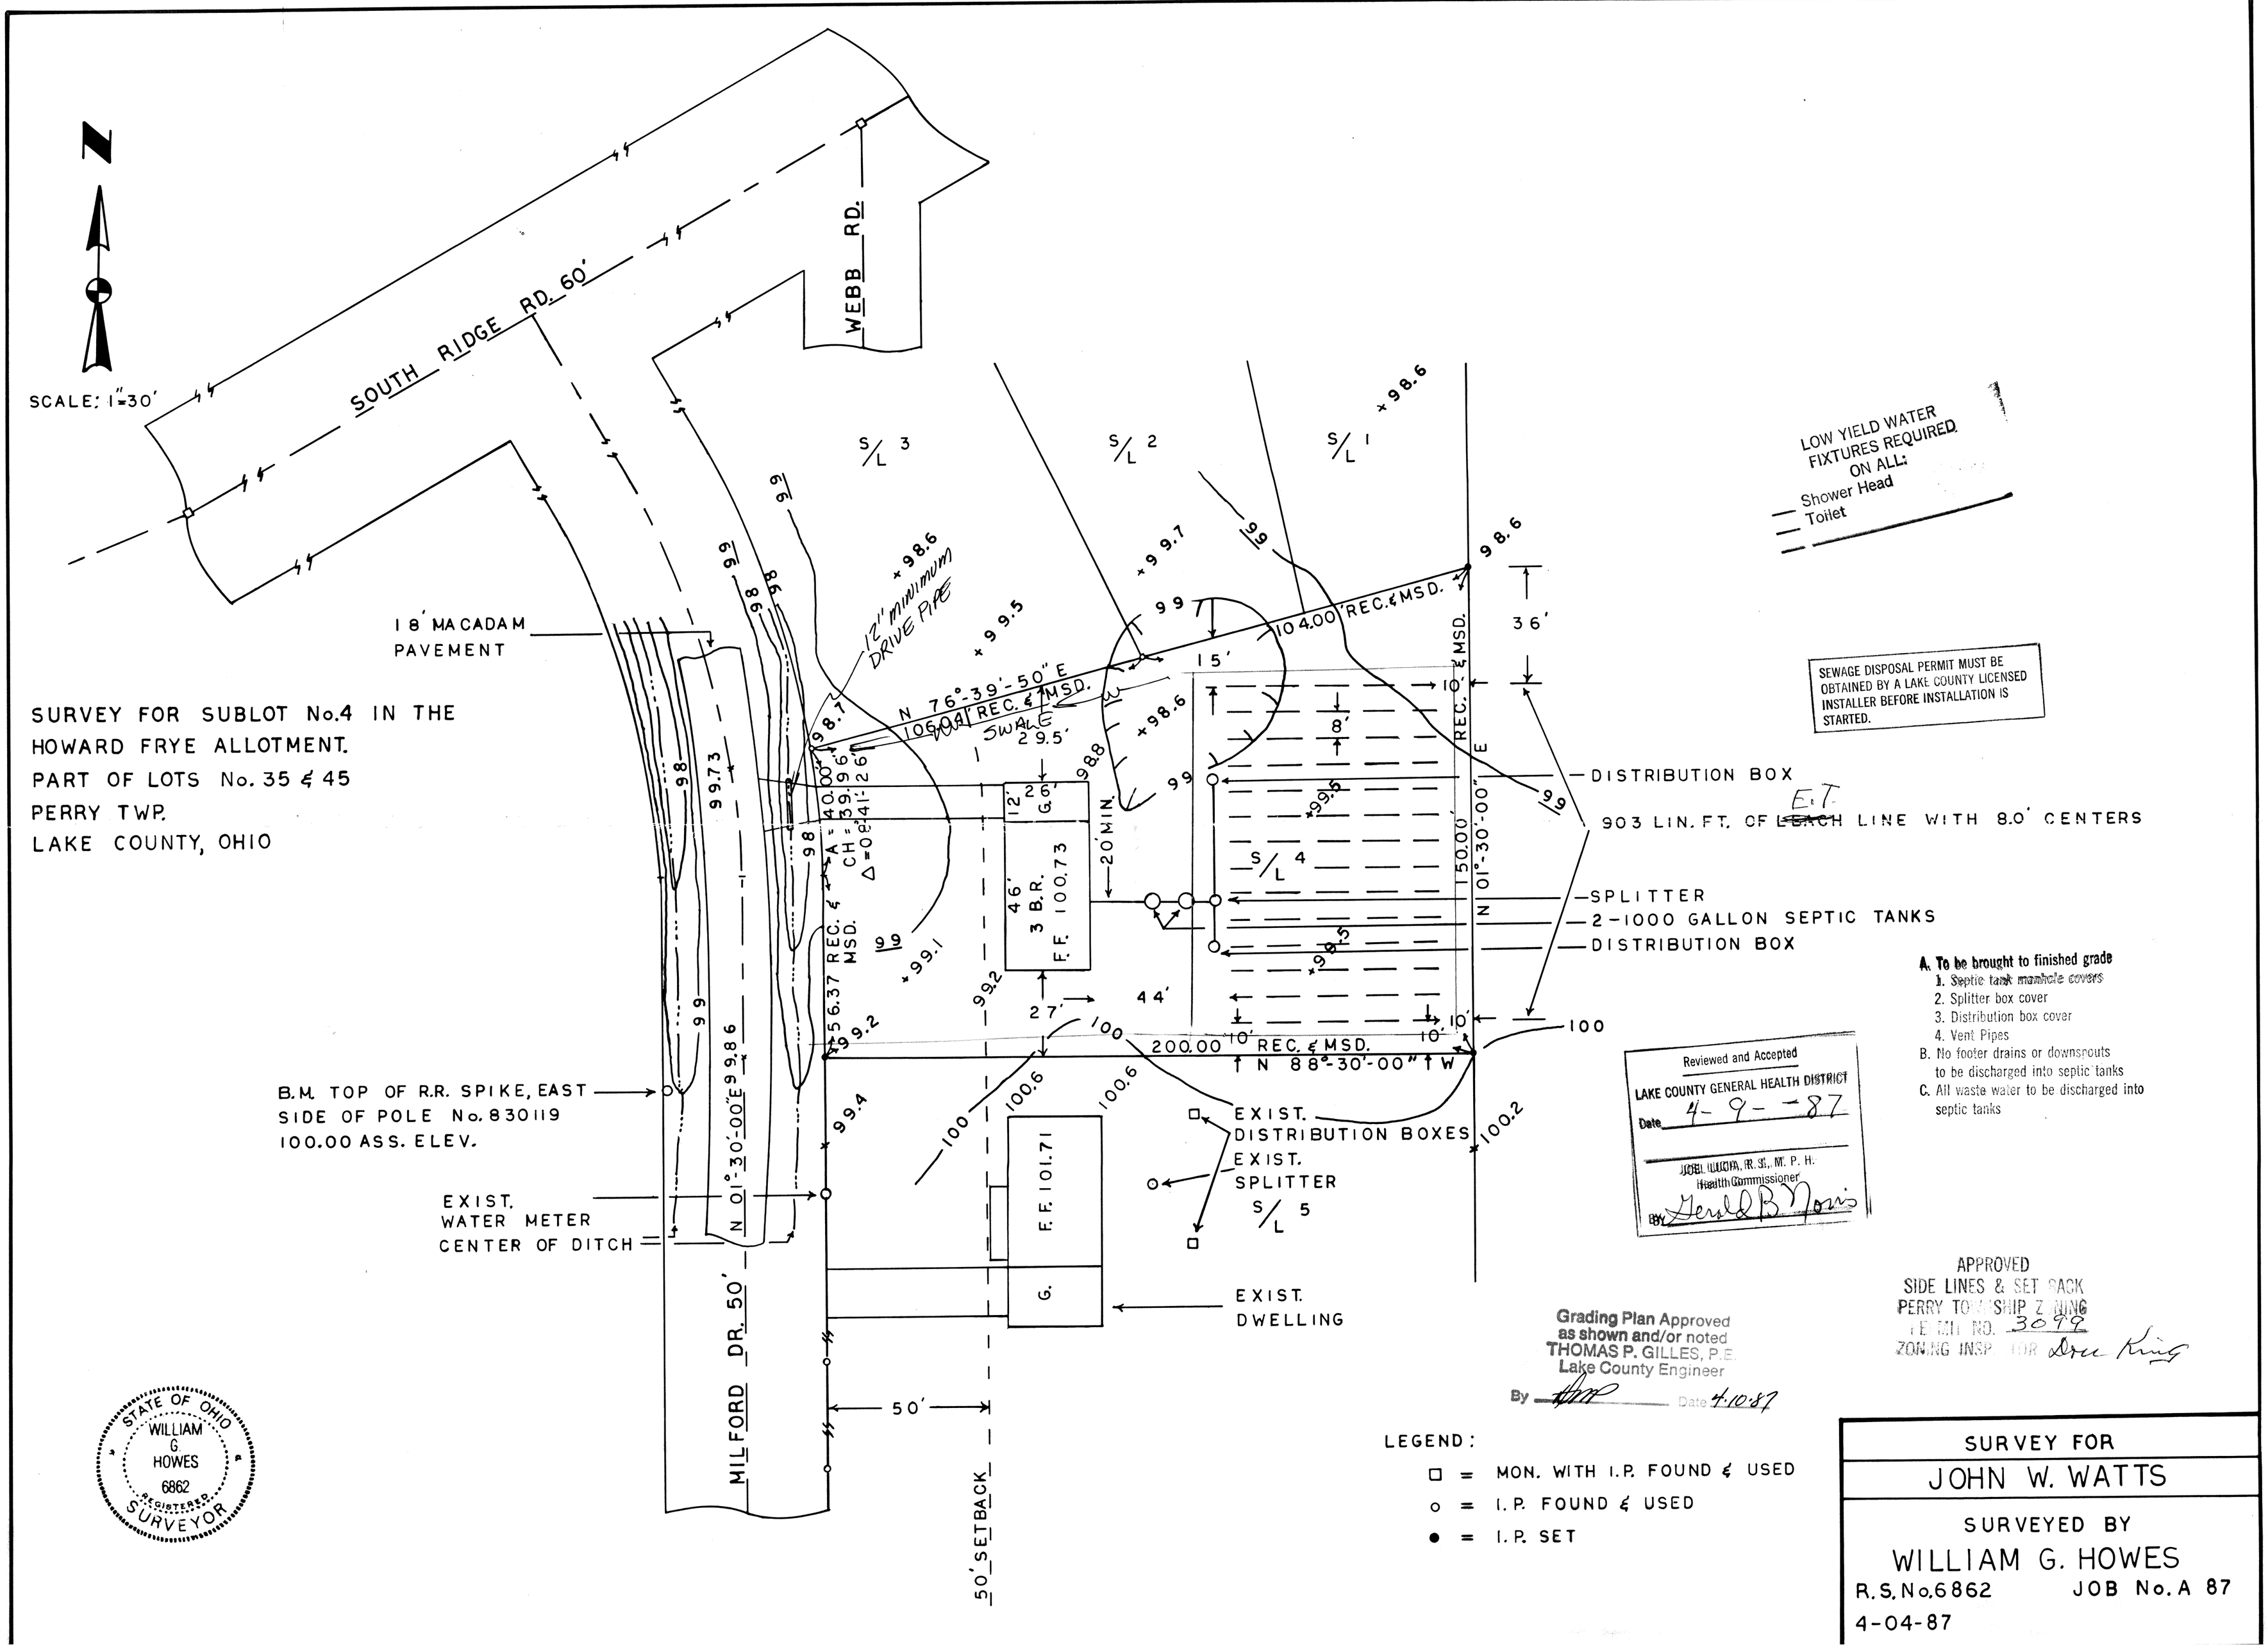
SCALE: 1"=30'
SOUTH RIDGE RD. 60'
WEBB RD.
18' MACADAM PAVEMENT
SURVEY FOR SUBLOT No.4 IN THE HOWARD FRYE ALLOTMENT.
PART OF LOTS No. 35 & 45
PERRY TWP.
LAKE COUNTY, OHIO
S/L 3
S/L 2
S/L 1
S/L 4
S/L 5
12" MINIMUM DRIVE PIPE
N 76°-39'-50" E
106.04' REC. & MSD.
104.00' REC. & MSD.
SWALE
A = 40.00'
CH = 39.96'
Δ = 08°41'-26"
56.37 REC. & MSD.
46' 3 B.R. F.F. 100.73
20' MIN.
150.00' REC. & MSD.
N 01°-30'-00" E
200.00' REC. & MSD.
N 88°-30'-00" W
F.F. 101.71
G.
MILFORD DR. 50'
N 01°-30'-00" E
50' SETBACK
DISTRIBUTION BOX
903 LIN. FT. OF ~~LEACH~~ E.T. LINE WITH 8.0' CENTERS
SPLITTER
2-1000 GALLON SEPTIC TANKS
DISTRIBUTION BOX
B.M. TOP OF R.R. SPIKE, EAST SIDE OF POLE No. 830119 100.00 ASS. ELEV.
EXIST. WATER METER
CENTER OF DITCH
EXIST. DISTRIBUTION BOXES
EXIST. SPLITTER
EXIST. DWELLING
LOW YIELD WATER FIXTURES REQUIRED ON ALL:
Shower Head
Toilet
SEWAGE DISPOSAL PERMIT MUST BE OBTAINED BY A LAKE COUNTY LICENSED INSTALLER BEFORE INSTALLATION IS STARTED.
A. To be brought to finished grade
1. Septic tank manhole covers
2. Splitter box cover
3. Distribution box cover
4. Vent Pipes
B. No footer drains or downspouts to be discharged into septic tanks
C. All waste water to be discharged into septic tanks
Reviewed and Accepted
LAKE COUNTY GENERAL HEALTH DISTRICT
Date 4-9-87
JOEL LUCIA, R.S., M.P.H.
Health Commissioner
By Gerald B. Norris
APPROVED
SIDE LINES & SET BACK
PERRY TOWNSHIP ZONING
PERMIT NO. 3099
ZONING INSPECTOR Dree King
Grading Plan Approved as shown and/or noted
THOMAS P. GILLES, P.E.
Lake County Engineer
By
Date 4-10-87
STATE OF OHIO
WILLIAM G. HOWES
6862
REGISTERED SURVEYOR
LEGEND:
□ = MON. WITH I.P. FOUND & USED
○ = I.P. FOUND & USED
● = I.P. SET
SURVEY FOR
JOHN W. WATTS
SURVEYED BY
WILLIAM G. HOWES
R.S. No. 6862
JOB No. A 87
4-04-87