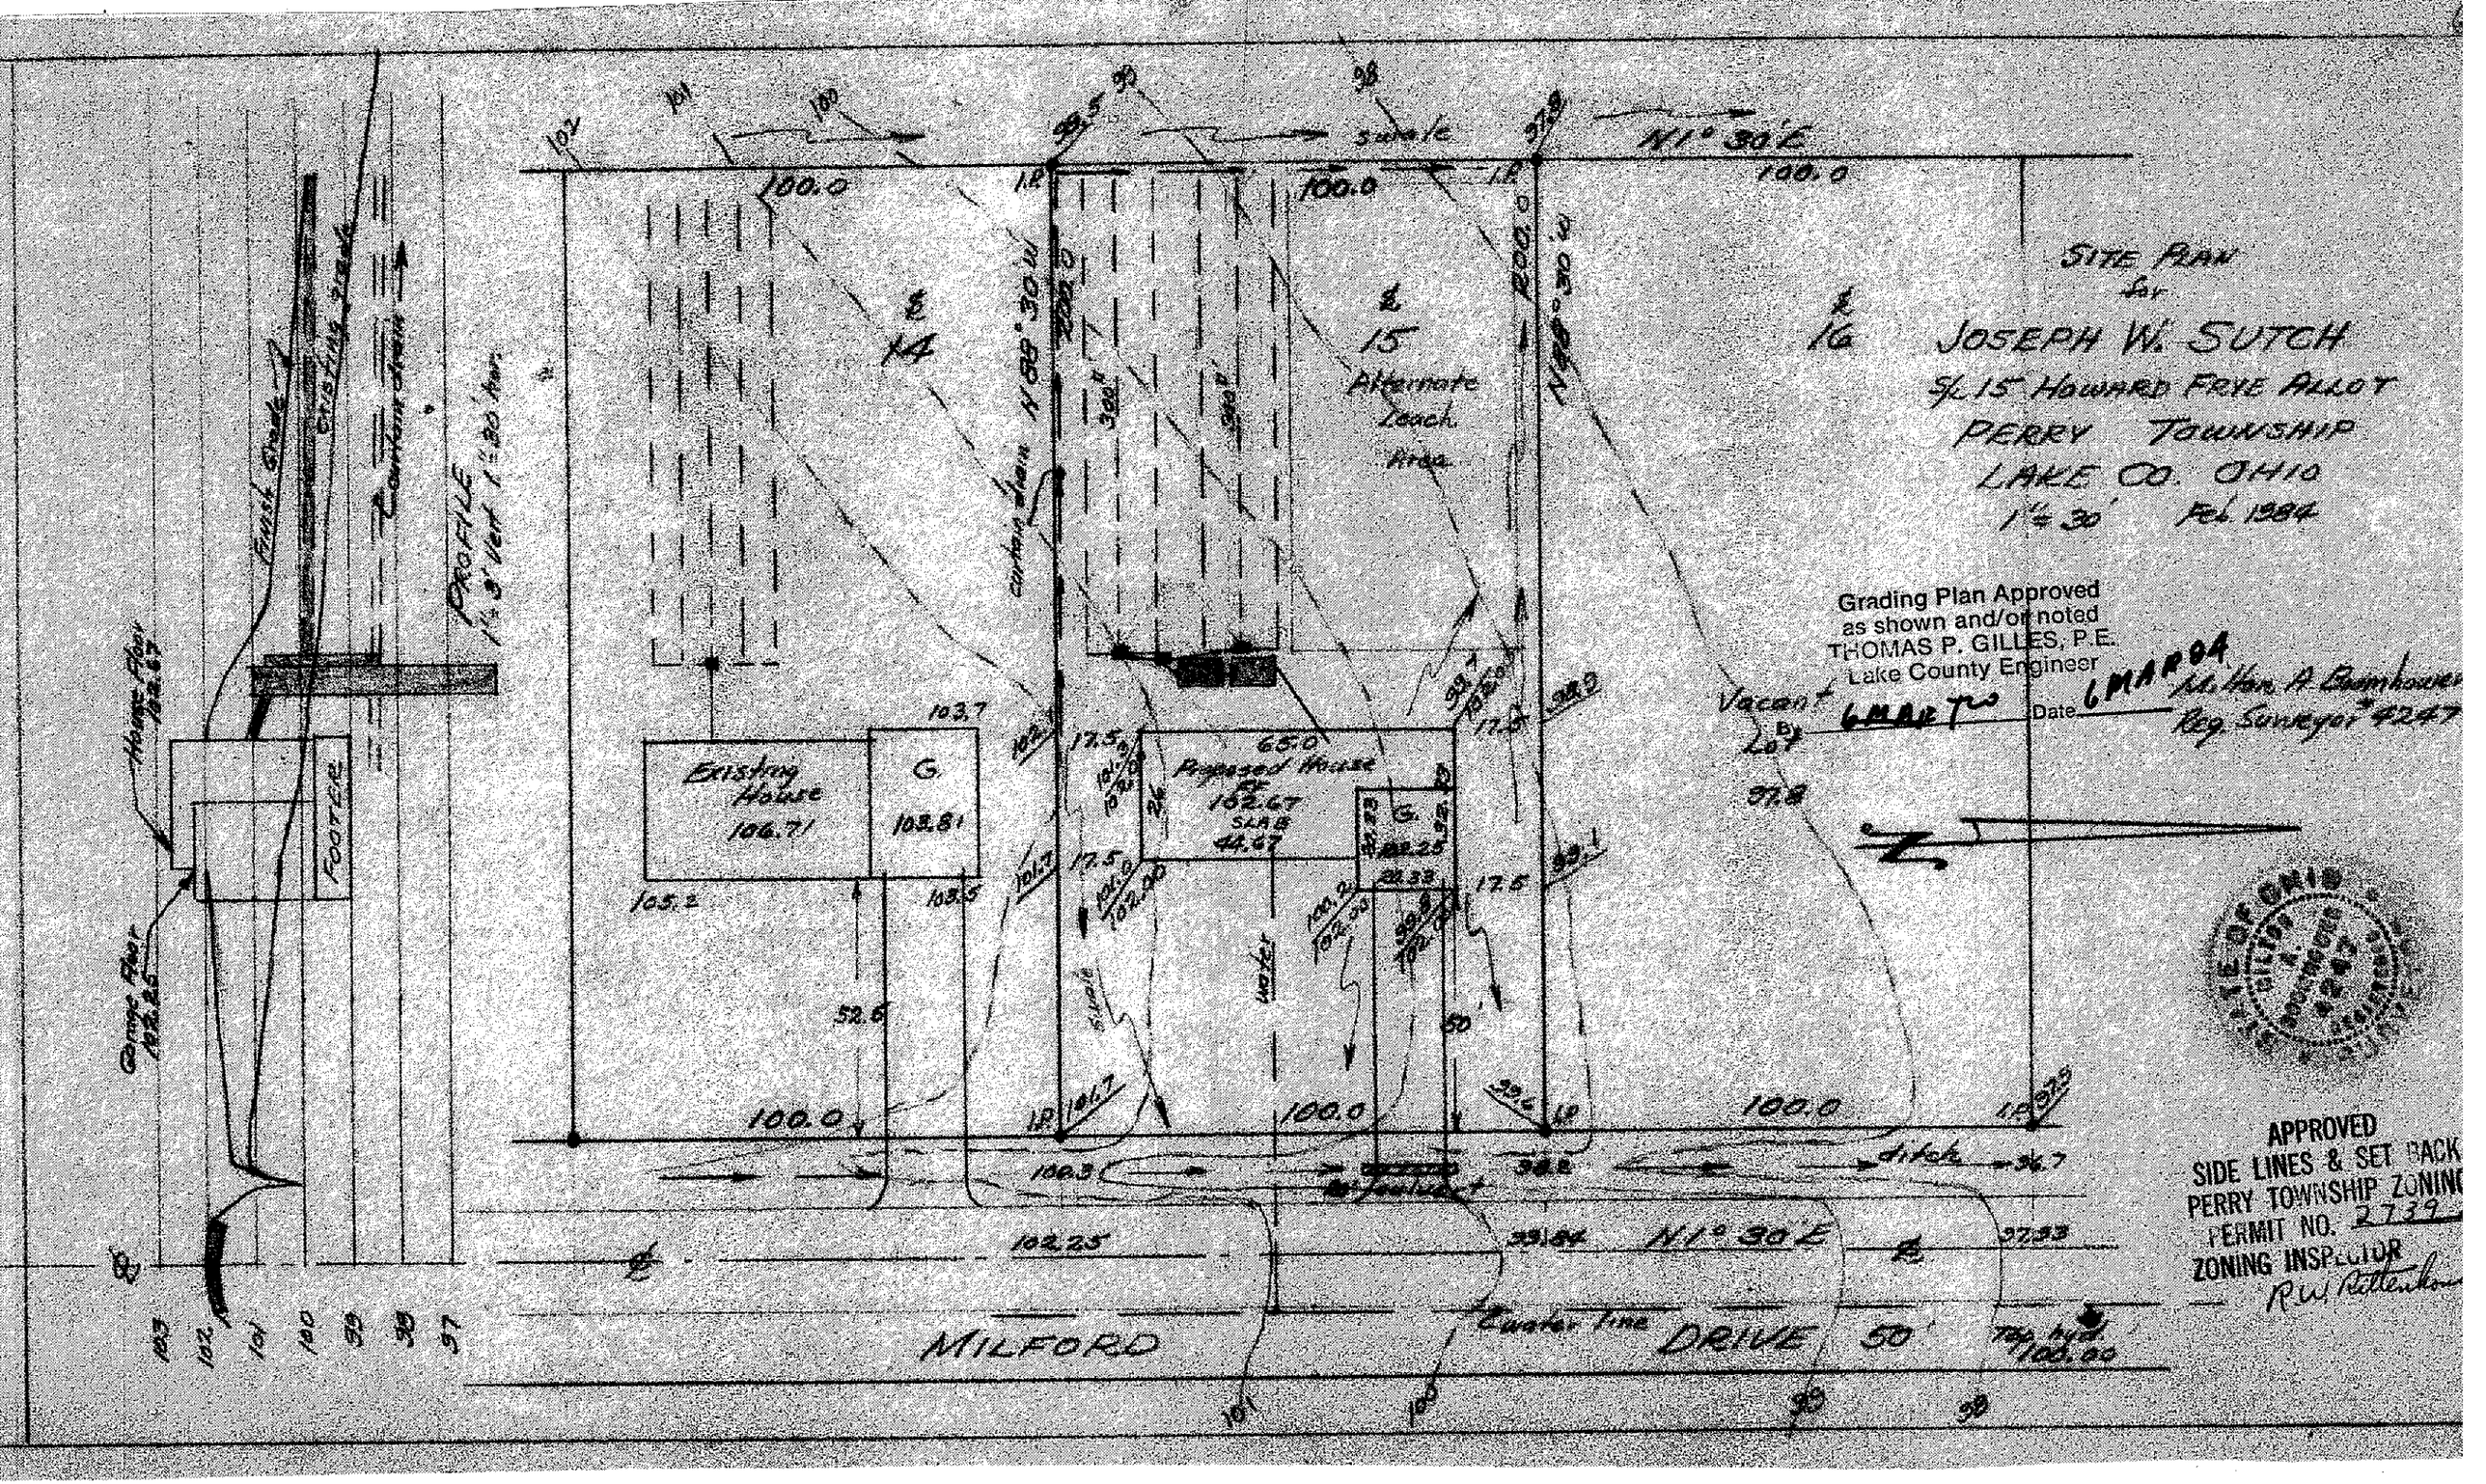
SITE PLAN
for
JOSEPH W. SUTCH
S/L 15 HOWARD FRYE ALLOT
PERRY TOWNSHIP
LAKE CO. OHIO
1" = 30'
Feb. 1984
Grading Plan Approved
as shown and/or noted
THOMAS P. GILLES, P.E.
Lake County Engineer
Date 6 MAR 84
Reg. Surveyor # 4247
APPROVED
SIDE LINES & SET BACK
PERRY TOWNSHIP ZONING
PERMIT NO. 2739
ZONING INSPECTOR
R.W. Rittenhouse
Existing House
106.71
G.
103.81
Proposed House
102.67
SLAB
44.67
Alternate Leach Area
N 1° 30' E
N 88° 30' W
100.0
100.0
100.0
100.0
100.0
100.0
100.3
102.25
MILFORD
DRIVE
50'
water line
ditch
Top hyd. 100.00
Vacant Lot
Existing Grade
Curtain drain
Finish Grade
PROFILE
1" = 3' Vert 1" = 30' Hor.
House Floor 102.67
Garage Floor 102.25
FOOTER
103
102
101
100
99
98
97