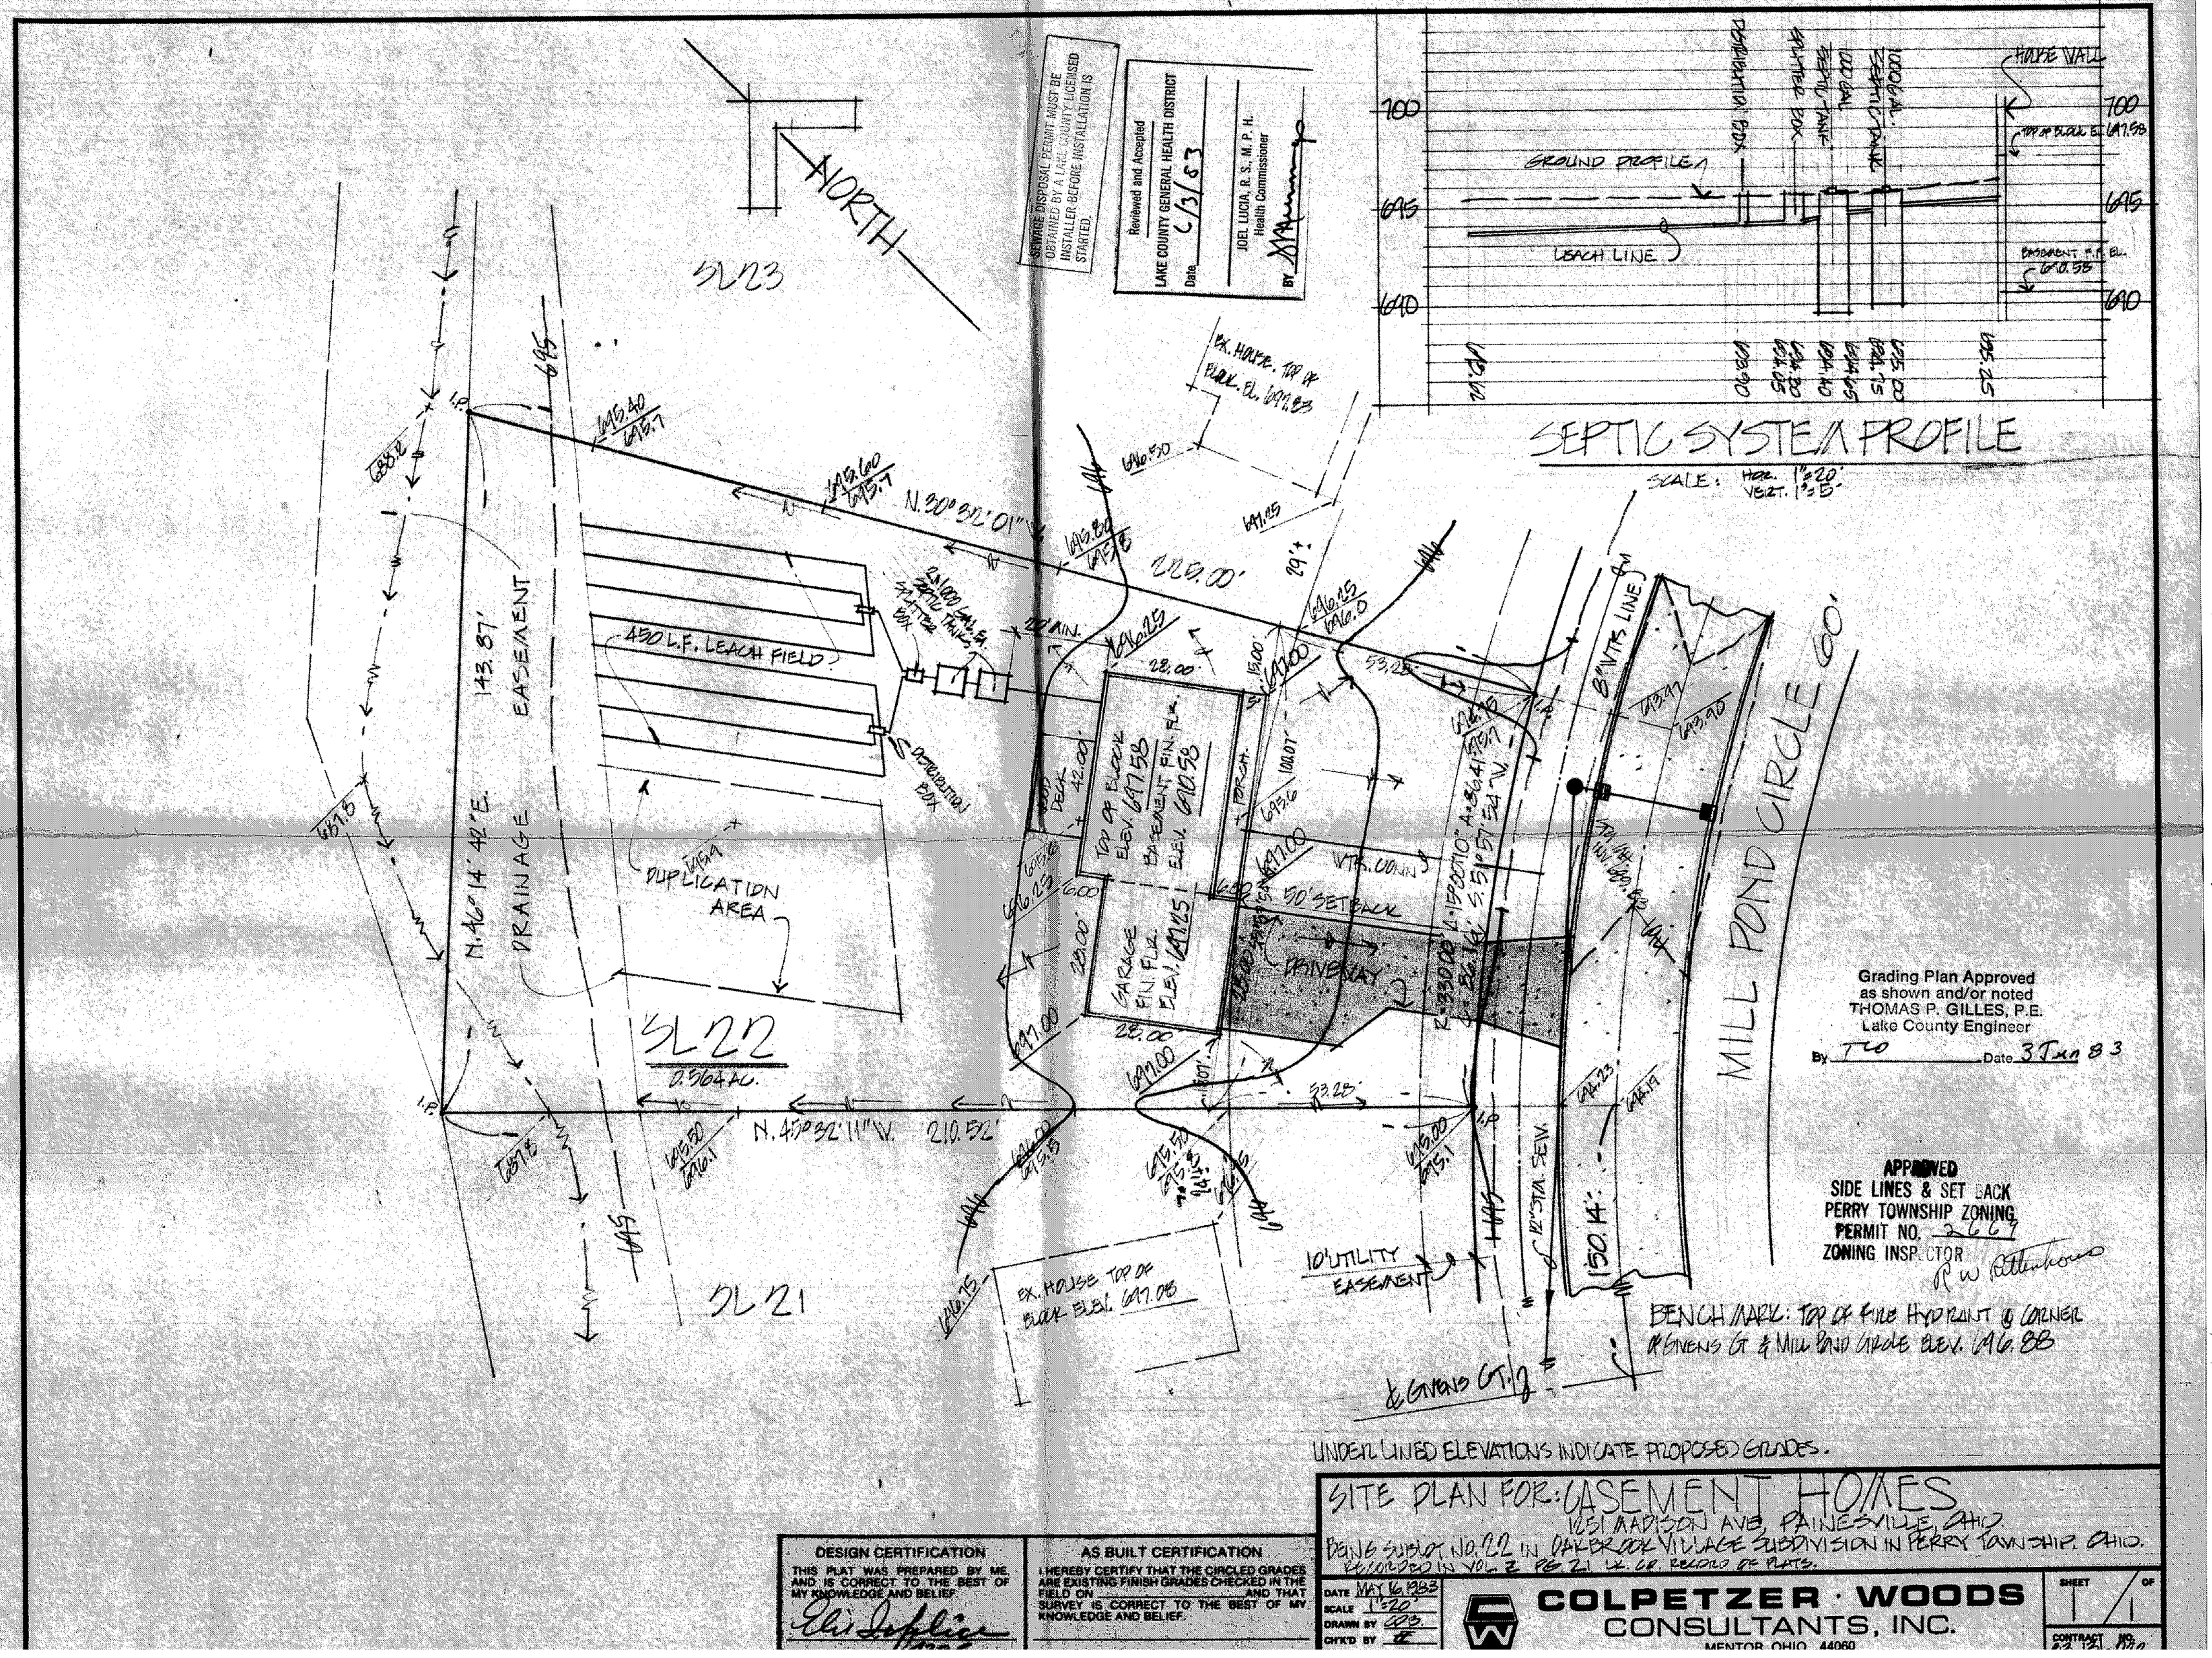

SEWAGE DISPOSAL PERMIT MUST BE OBTAINED BY A LAKE COUNTY LICENSED INSTALLER BEFORE INSTALLATION IS STARTED.

Reviewed and Accepted
LAKE COUNTY GENERAL HEALTH DISTRICT
Date 6/3/83
JOEL LUCIA, R.S., M.P.H.
Health Commissioner
BY

Grading Plan Approved as shown and/or noted
THOMAS P. GILLES, P.E.
Lake County Engineer
By TCO Date 3 Jun 83

APPROVED
SIDE LINES & SET BACK
PERRY TOWNSHIP ZONING
PERMIT NO. 2669
ZONING INSPECTOR
R W Rittenhouse

BENCH MARK: TOP OF FIRE HYDRANT @ CORNER OF GIVENS CT & MILL POND CIRCLE ELEV. 696.88

UNDER LINED ELEVATIONS INDICATE PROPOSED GRADES.

SITE PLAN FOR: CASEMENT HOMES
1251 MADISON AVE, PAINESVILLE, OHIO.
BEING SUBLOT NO. 22 IN OAKBROOK VILLAGE SUBDIVISION IN PERRY TOWNSHIP, OHIO.
RECORDED IN VOL. 2 PG. 21 LK. CO. RECORD OF PLATS.

DESIGN CERTIFICATION
THIS PLAT WAS PREPARED BY ME, AND IS CORRECT TO THE BEST OF MY KNOWLEDGE AND BELIEF.
Eli Joplice

AS BUILT CERTIFICATION
I HEREBY CERTIFY THAT THE CIRCLED GRADES ARE EXISTING FINISH GRADES CHECKED IN THE FIELD ON _____ AND THAT SURVEY IS CORRECT TO THE BEST OF MY KNOWLEDGE AND BELIEF.

DATE MAY 16, 1983
SCALE 1"=20'
DRAWN BY CDB
CH'K'D BY

COLPETZER · WOODS
CONSULTANTS, INC.
MENTOR, OHIO 44060

SHEET 1 OF 1
CONTRACT NO.