LEGEND

- Exist Ground Elev
- Prop Ground Elev
- Exist. Structure (To Be Removed)
- Exist. Contour Line
- Prop Contour Line

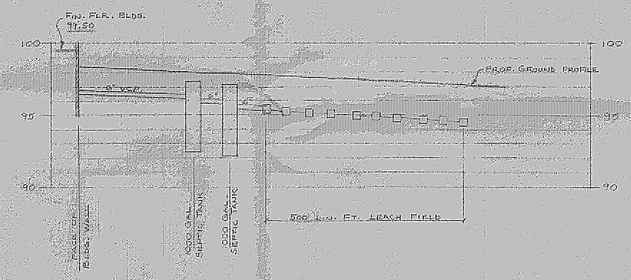

5068
North Ridge Rd
Perry Ohio

Site Plan For:

Total Design Enterprises
37914 Euclid Avenue
Willoughby, Ohio 44094

Being Part Of Lot 81 And 91
In Perry Township, Lake
County, Ohio

Prepared By:

Wm. R. Gray Assoc. Inc.
7547 Mentor Avenue
Mentor, Ohio 44060

Scale: 1" = 20'
Date: April 19, 1977

Certification:

I Hereby Certify That
This Plat Is Correct To
The Best Of My Knowledge.

By: Wm. R. Gray
Wm. R. Gray Reg. Surv. #2752

Grading Plan Approved
as shown and/or noted
THOMAS P. GILLES, P.E.
Lake County Engineer
By D.J.L. Date 7/15/77

APPROVED
SIDE LINES & SET BACK
PERRY TOWNSHIP ZONING
PERMIT NO. 1947
ZONING INSPECTOR

7/19/77 R.W. Rittenhouse

gas pump for future Bldg not approved at this time
separate permits needed

Grade plan must be approved by County Engineer
before Bldg permit is issued + Const begins

Septic System Profile

Scale: Horz. - 1" = 20' Vert. - 1" = 5'

STATE OF OHIO
WM. R. GRAY
2752
REGISTERED
PROFESSIONAL SURVEYOR