SITE PLAN FOR BETTER BLDR.'S

BEING SUBLOT NO. 48, BIRCHFIELD MEADOWS SUB'D II, TOWNSHIP OF PERRY, COUNTY OF LAKE, STATE OF OHIO

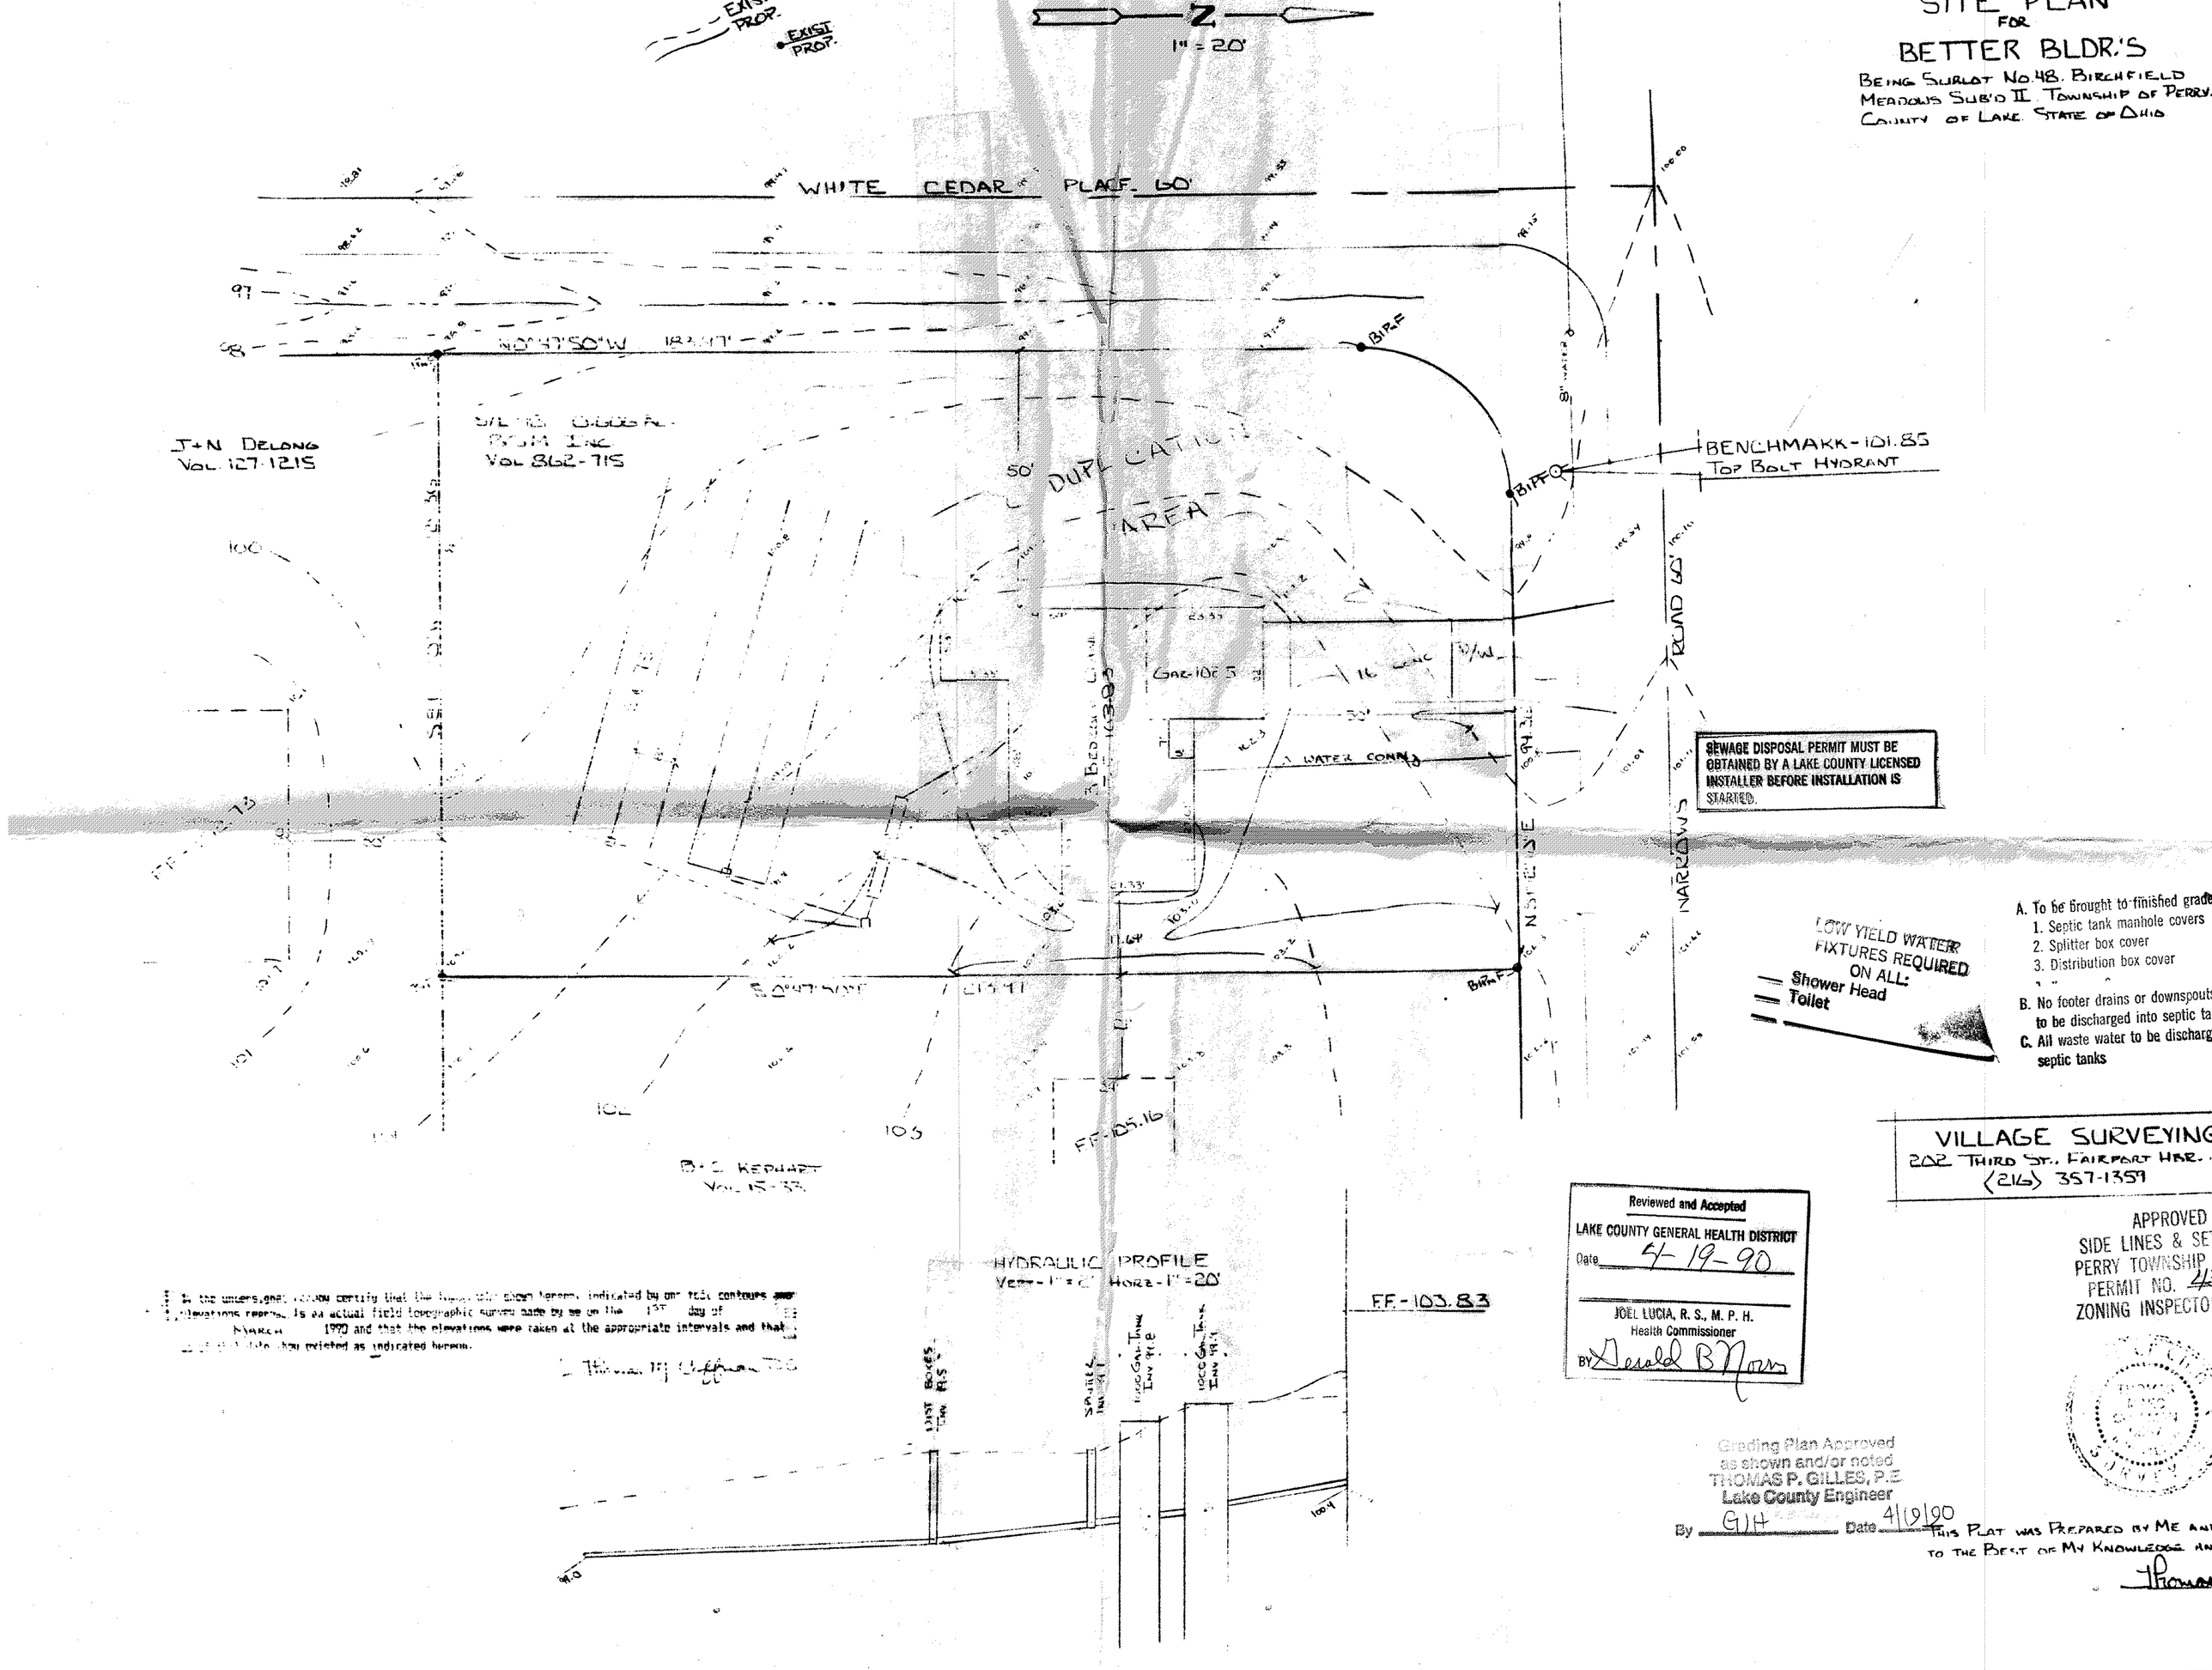

SEWAGE DISPOSAL PERMIT MUST BE OBTAINED BY A LAKE COUNTY LICENSED INSTALLER BEFORE INSTALLATION IS STARTED.

LOW YIELD WATER FIXTURES REQUIRED ON ALL:
- Shower Head
- Toilet

A. To be brought to finished grade
1. Septic tank manhole covers
2. Splitter box cover
3. Distribution box cover

B. No footer drains or downspouts to be discharged into septic ta

C. All waste water to be discharg septic tanks

VILLAGE SURVEYING
202 THIRD ST., FAIRPORT HBR.
(216) 357-1359

Reviewed and Accepted
LAKE COUNTY GENERAL HEALTH DISTRICT
Date 4-19-90
JOEL LUCIA, R. S., M. P. H.
Health Commissioner
BY Gerald B Morris

APPROVED
SIDE LINES & SE
PERRY TOWNSHIP
PERMIT NO. 4
ZONING INSPECTO

Grading Plan Approved as shown and/or noted
THOMAS P. GILLES, P.E.
Lake County Engineer
By GJH Date 4/19/90

I, the undersigned, hereby certify that the [illegible] shown hereon, indicated by our field contours and elevations represents an actual field topographic survey made by me on the 1ST day of MARCH 1990 and that the elevations were taken at the appropriate intervals and that [illegible] do exist as indicated hereon.

THIS PLAT WAS PREPARED BY ME AN TO THE BEST OF MY KNOWLEDGE AN

Thomas