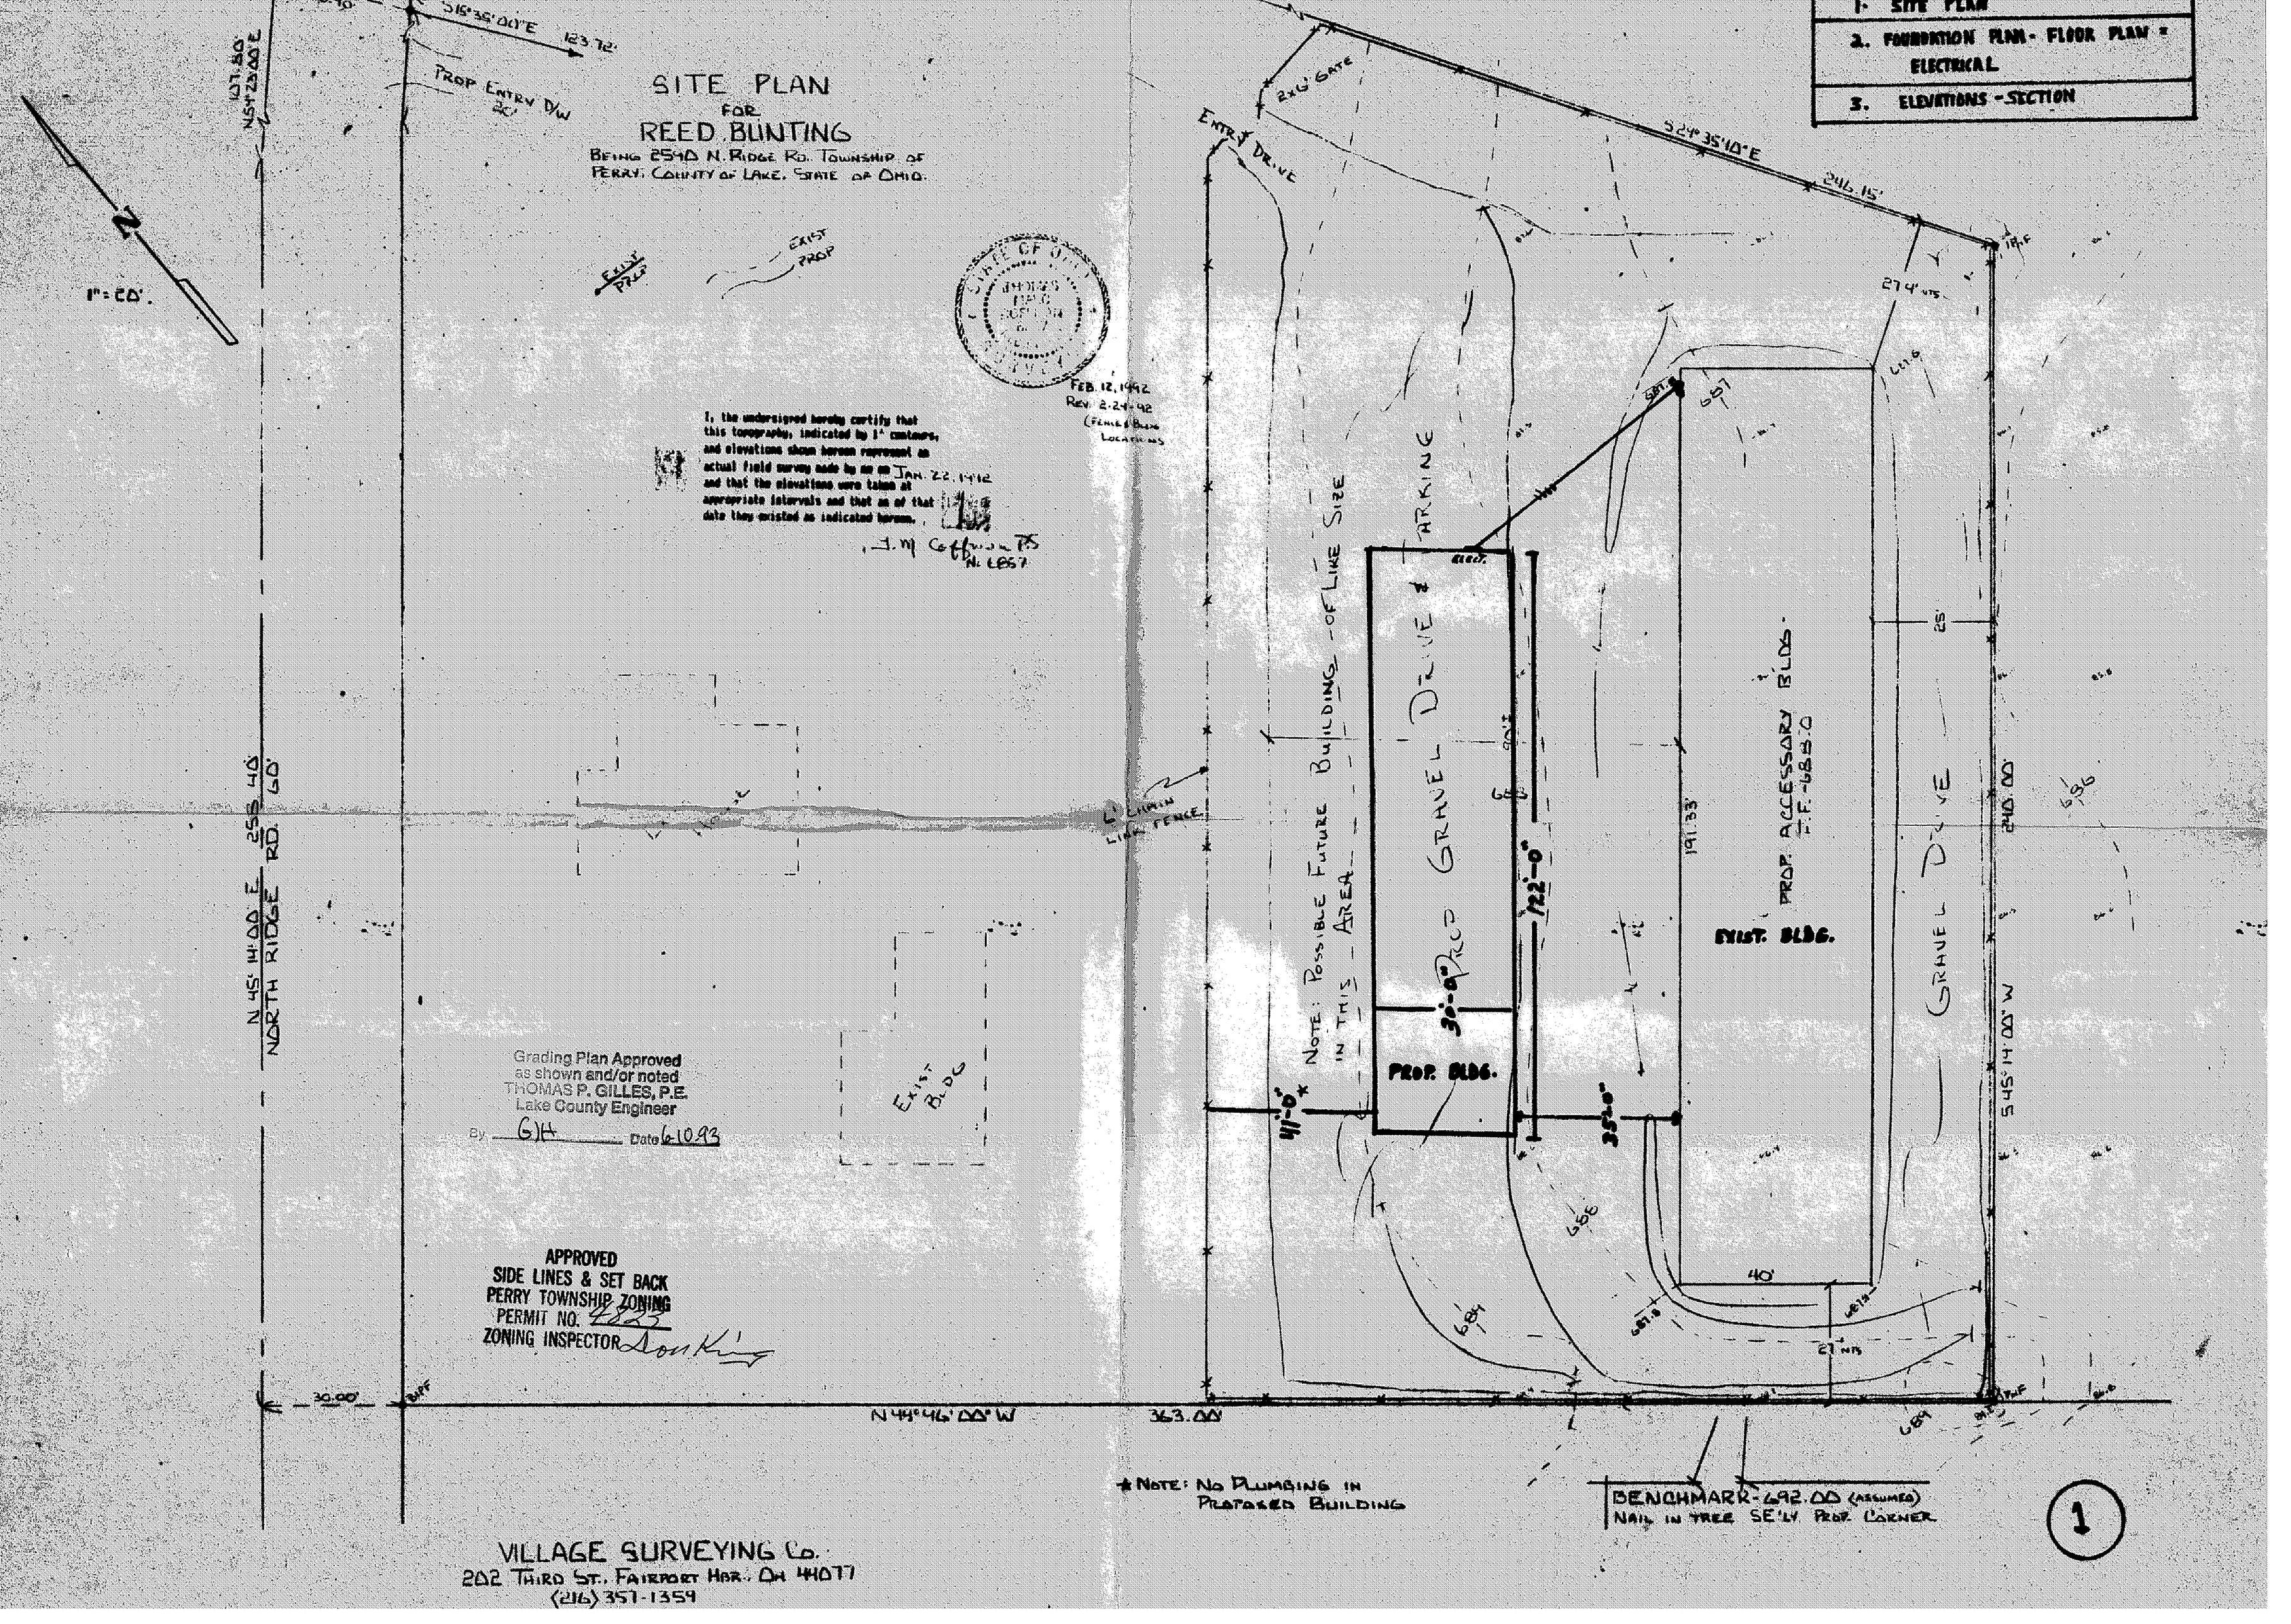

1. SITE PLAN
2. FOUNDATION PLAN - FLOOR PLAN = ELECTRICAL
3. ELEVATIONS - SECTION
SITE PLAN
FOR
REED BUNTING
BEING 2590 N. RIDGE RD. TOWNSHIP OF PERRY, COUNTY OF LAKE, STATE OF OHIO.
1" = 20'
N
S15°35'00"E 123.72'
PROP ENTRY D/W 20'
EXIST PROP
FEB. 12, 1992
REV. 2-24-92
(FENCE & BLDG LOCATIONS)
I, the undersigned hereby certify that this topography, indicated by 1' contours, and elevations shown hereon represent an actual field survey made by me on JAN. 22, 1992 and that the elevations were taken at appropriate intervals and that as of that date they existed as indicated hereon.
J. M. Coffman PS
N. 6857
N 45° 14' 00" E 255.40'
NORTH RIDGE RD. 60'
N 44° 46' 00" W
363.00'
30.00'
Grading Plan Approved as shown and/or noted
THOMAS P. GILLES, P.E.
Lake County Engineer
By GJH Date 6-10-93
APPROVED
SIDE LINES & SET BACK
PERRY TOWNSHIP ZONING
PERMIT NO. 4823
ZONING INSPECTOR Don King
EXIST BLDG
6' CHAIN LINK FENCE
ENTRY DRIVE
2x6' GATE
S24°35'40"E
246.15'
27.4' NTS
NOTE: POSSIBLE FUTURE BUILDING OF LIKE SIZE IN THIS AREA
PROP GRAVEL DRIVE & PARKING
PROP. BLDG.
30'-0"
122'-0"
41'-0"*
35'-0"
191.33'
PROP. ACCESSORY BLDG. F.F.-688.0
EXIST. BLDG.
GRAVEL DRIVE
240.00'
S45°14'00"W
25'
40'
27' NTS
* NOTE: NO PLUMBING IN PROPOSED BUILDING
BENCHMARK - 692.00 (ASSUMED)
NAIL IN TREE SE'LY PROP. CORNER
VILLAGE SURVEYING Co.
202 THIRD ST. FAIRPORT HBR. OH 44077
(216) 357-1359
1