Grading Plan Approved
as shown and/or noted
THOMAS P. GILLES, P.E.
Lake County Engineer

By ZBG Date 2 Nov 72 Swale to Maine Ave to be completed before const. begins.

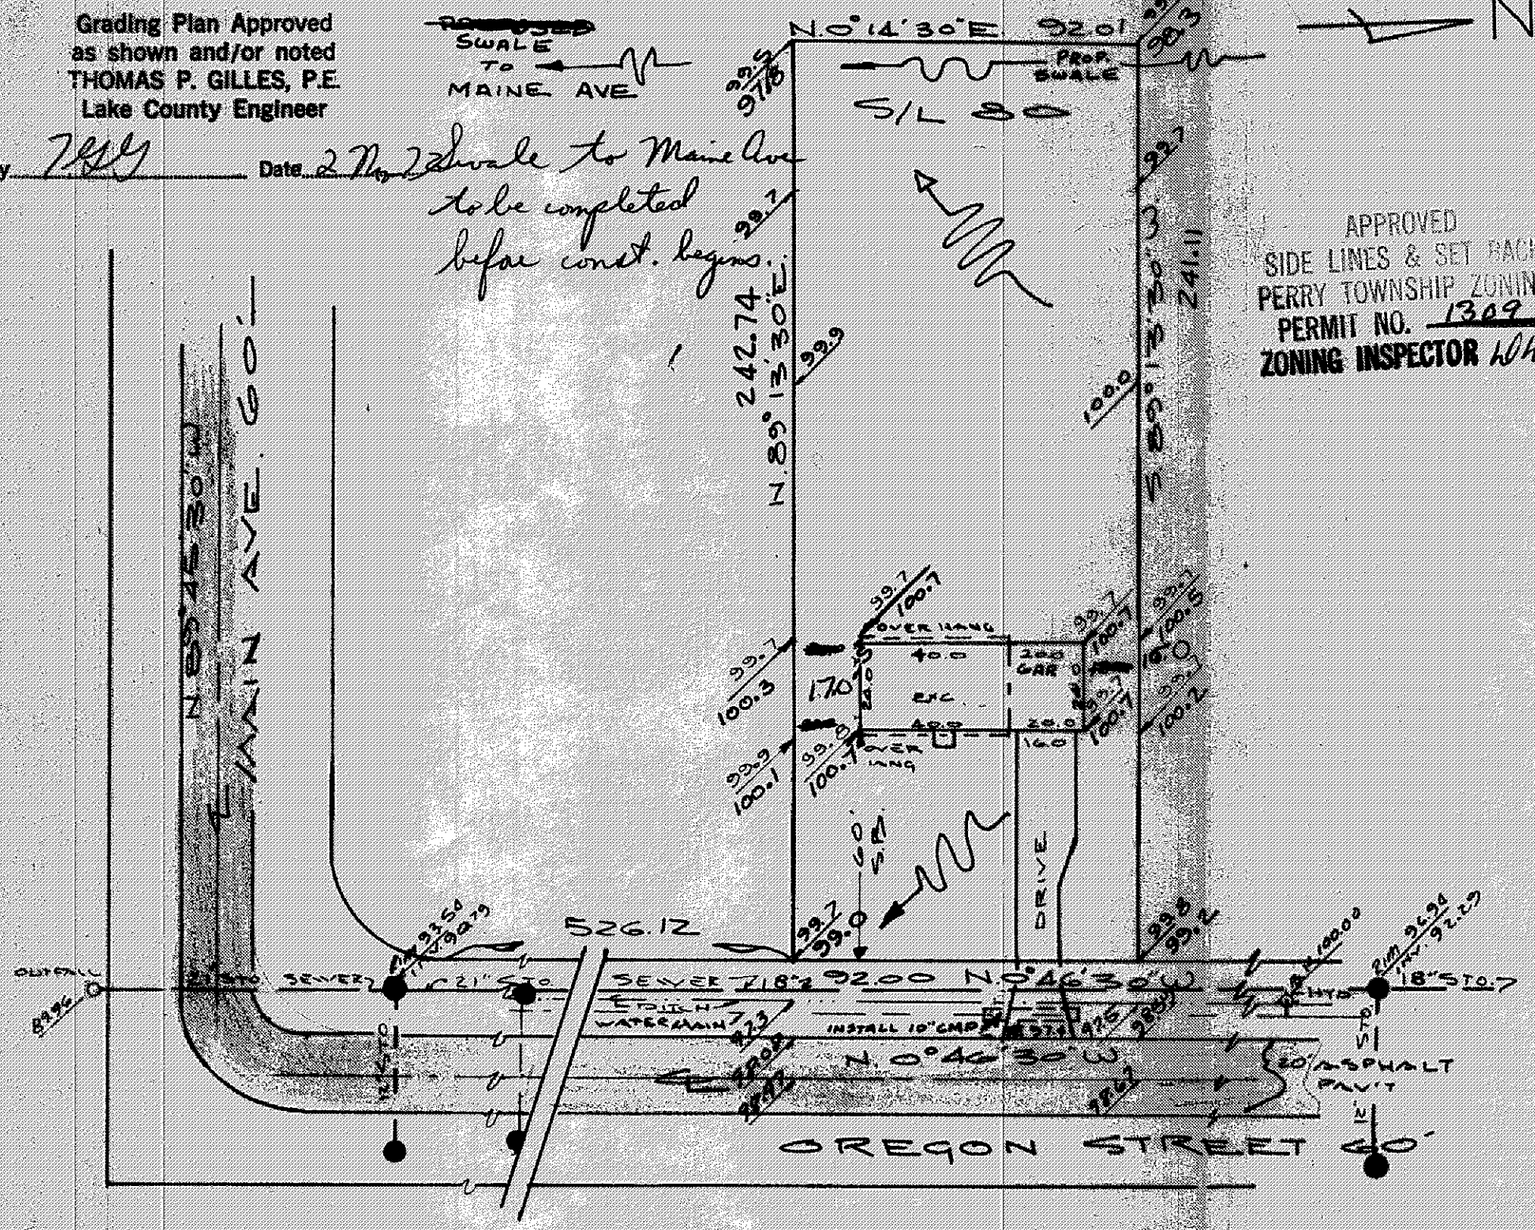

APPROVED
SIDE LINES & SET BACK
PERRY TOWNSHIP ZONING
PERMIT NO. 1309
ZONING INSPECTOR WHS

SITE PLAN

PERRY TOWNSHIP LAKE COUNTY, OHIO

for: CLIENT OWNER

ADDRESS STREET CITY ZIP

SIXON ACRES ALLT. SUBDIVISION NAME — E 10 VOL. PG

80 SUBLOT NO. OREGON ST. STREET

LOT TRACT

VOLUME PAGE

PERM. PARCEL # STREET

LEGEND

SANITARY MANHOLE
STORM MANHOLE
INLET OR CATCH BASIN
HYDRANT
EXISTING CONTOURS
PROPOSED CONTOURS
EXIST. ELEV. 100.0
100.0 PROP. ELEV.

WATER VALVE (GAS)
WATER METER (GAS)
AS BUILT ELEVATION (100.0)

REMARKS

ALL BOUNDARY DATA SHOWN WAS OBTAINED FROM (DEEDS, RECORDED SUBDIVISION PLAT, OR OTHER PUBLIC RECORDS)

DESIGN CERTIFICATION

THIS PLAT WAS PREPARED BY ME, AND IS CORRECT TO THE BEST OF MY KNOWLEDGE AND BELIEF

Richard A. Debevec PS # 5244

NAME SURVEYOR REGISTRATION NO.

CHECK LIST

DIMENSIONS
BEARINGS
TIE TO NEAREST STREET
SUBLOT NO. PARCEL NO
SURROUNDING OWNERS
BLDG. DIMENSIONS FIN GR
BLDG. TIES FLR GRADES
APRON TYPE WIDTH THICKNESS
SIDEWALK TYPE WIDTH THICKNESS
CULVERT TYPE DIA LENGTH

WATER MAIN SIZE LOCATION
SAN SEWER SIZE % GR. LOC.
SAN MH. CAST ELEV. INV. ELEV.
SAN CONN. SIZE LOC DEPTH
STORM SEWER SIZE % GR. LOC.
STORM MH. CAST ELEV. INV. ELEV.
PAVT. TYPE GRADE CURBS
GAS LINE LOC. SIZE PRESSURE
SEPTIC TANK SIZE LOC
WELL LOCATION

"AS BUILT" CERTIFICATION

I, HEREBY CERTIFY THAT THE CIRCLED GRADES ARE EXISTING FINISH GRADES CHECKED IN FIELD ON _____ 19__ BY SURVEYING AND ARE CORRECT TO THE BEST OF MY KNOWLEDGE AND BELIEF

REGISTERED SURVEYOR REG. NO.

REVISIONS		
NO	DATE	BY
1		
2		
3		
4		
5		

PLAN PREPARED BY:
DEBEVEC-SALO & ASSOC., INC.
NAME
130 EAST JACKSON ST, PAINESVILLE
ADDRESS

DRAWN BY WB	SCALE 1"=40'	PHONE NO
CHK'D RAB	DATE 20 OCT. 72	DRAWING NO 3757-80
CREW CHIEF	APP'D	