SITE PLAN
FOR
LARRY BRAINARD
BEING SUBLOT NO. 50. OAKBROOK
VILLAGE SUB'D., TOWNSHIP OF PERRY.
COUNTY OF LAKE, STATE OF OHIO.

Grading Plan Approved
as shown and/or noted
THOMAS P. GILLES, P.E.
Lake County Engineer
By GJH Date 2-1-93

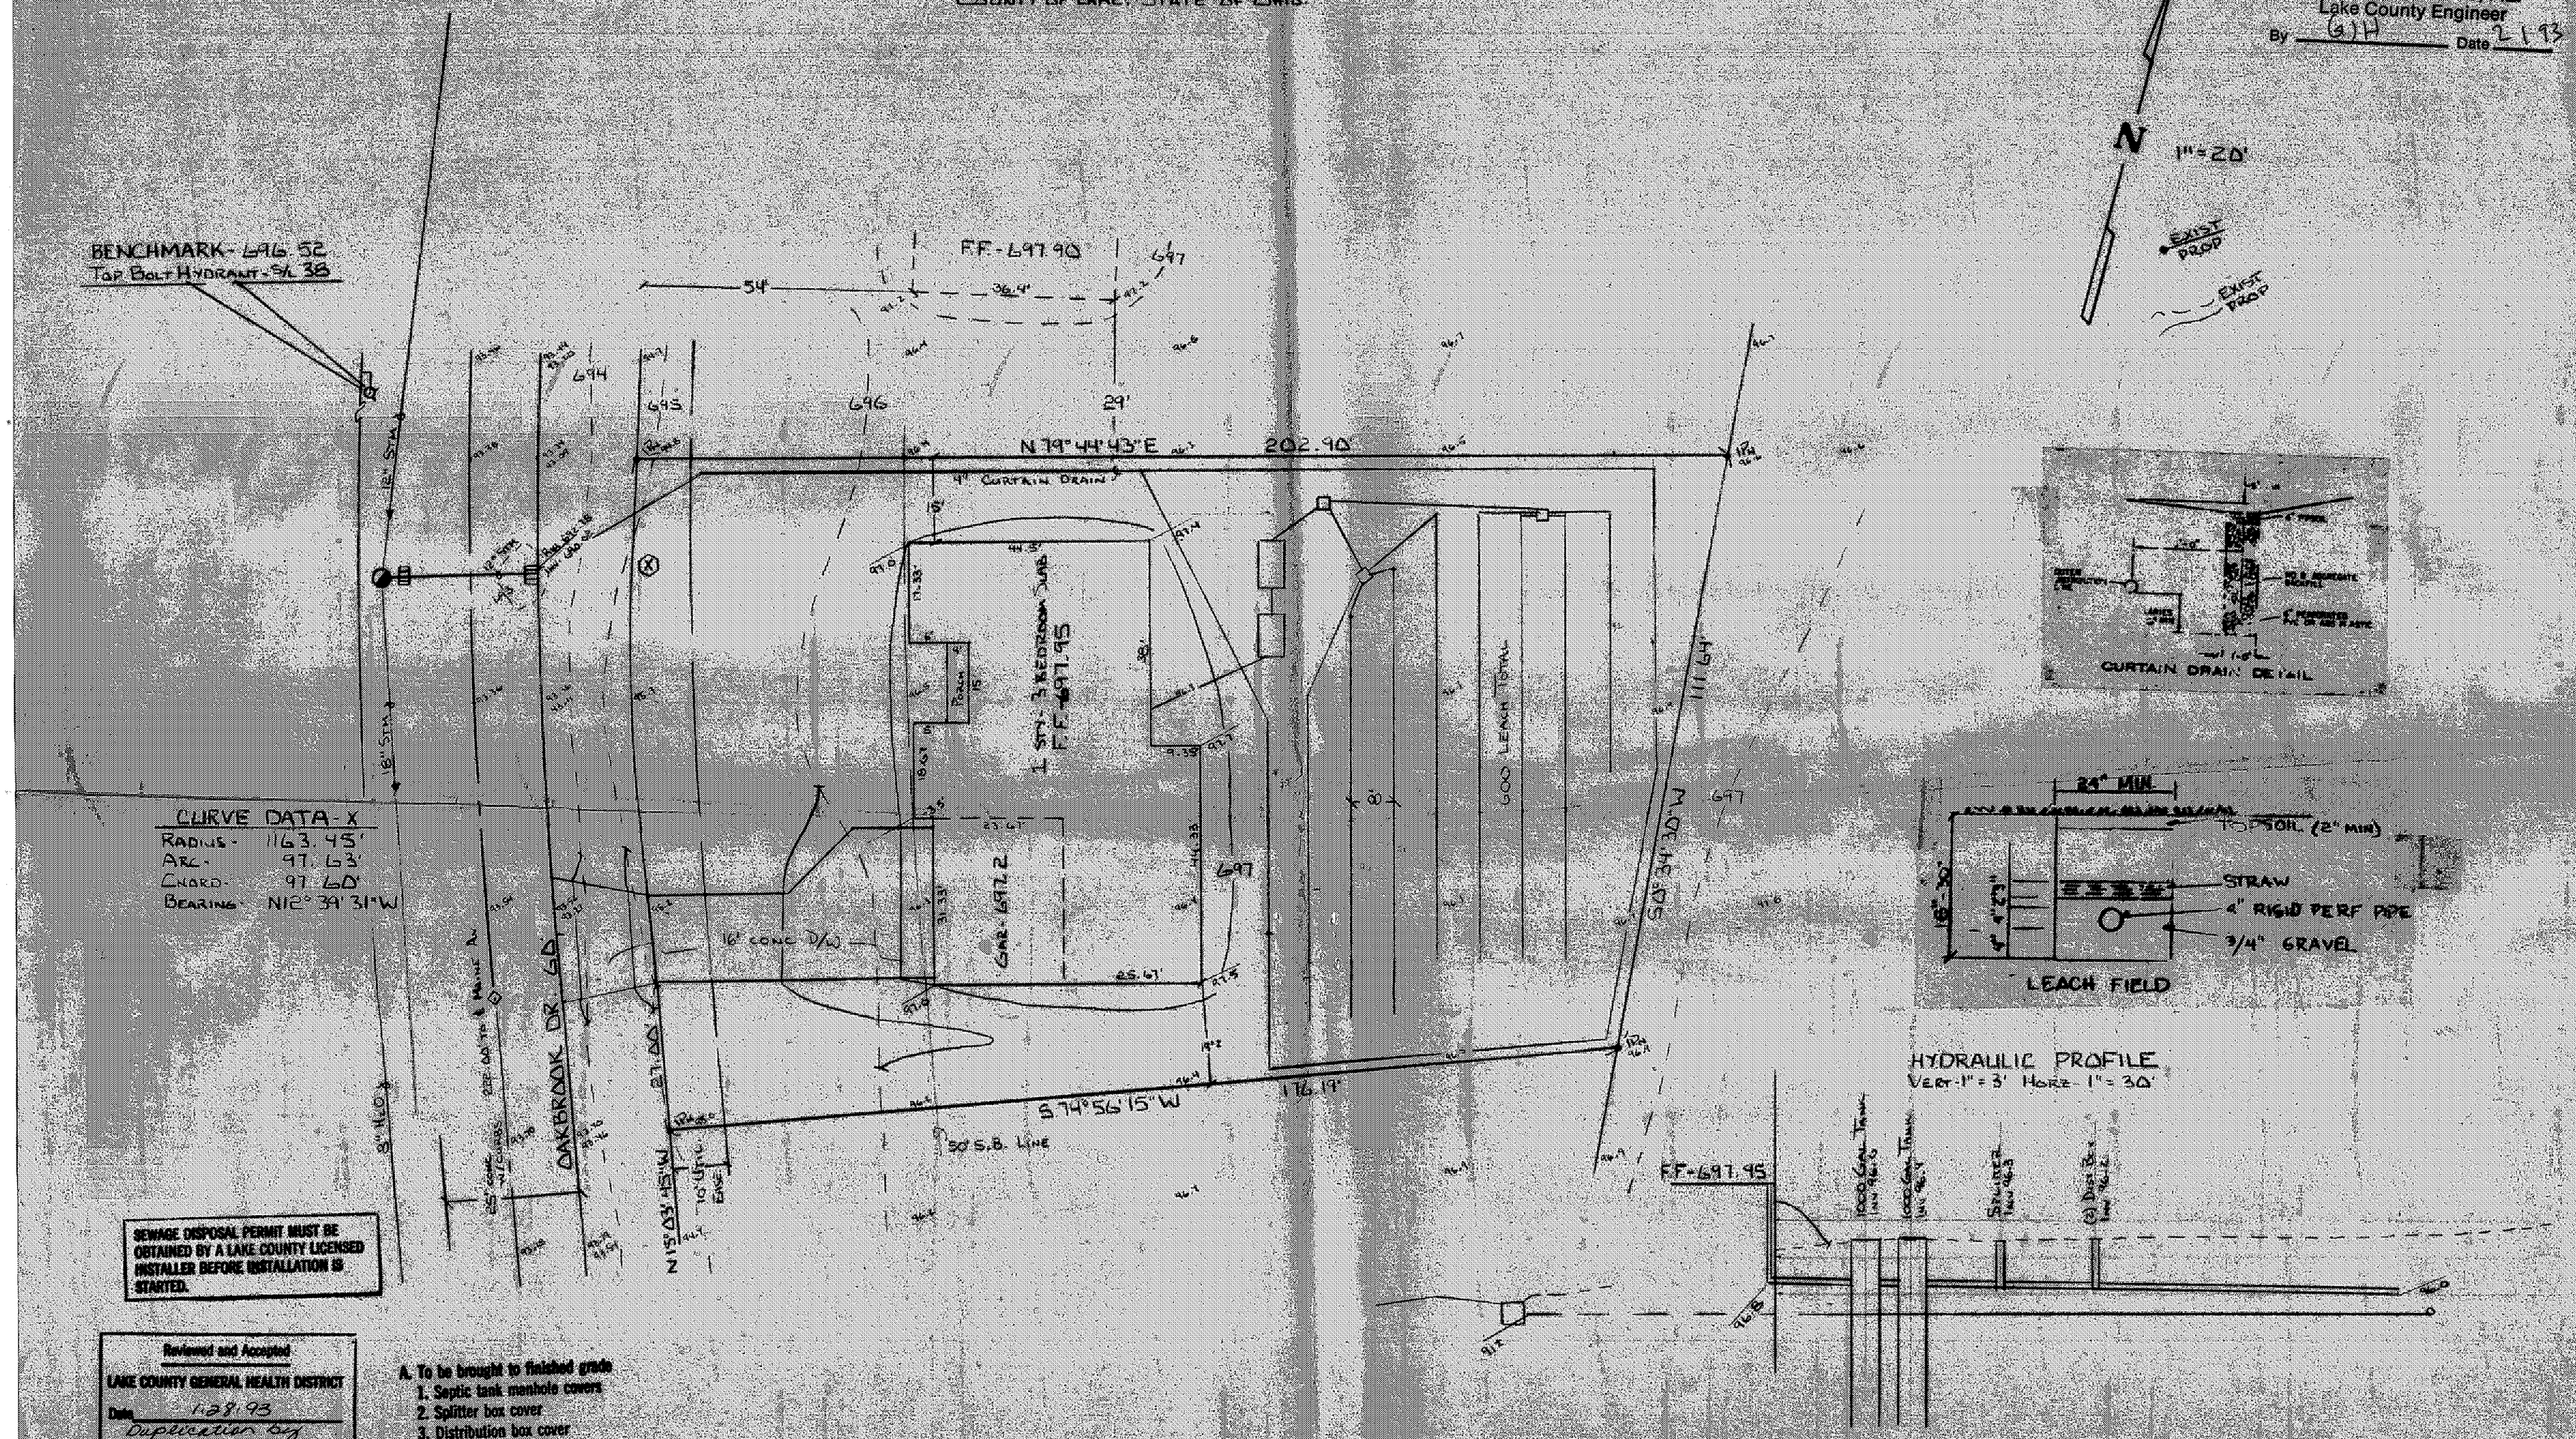

SEWAGE DISPOSAL PERMIT MUST BE OBTAINED BY A LAKE COUNTY LICENSED INSTALLER BEFORE INSTALLATION IS STARTED.

Reviewed and Accepted
LAKE COUNTY GENERAL HEALTH DISTRICT
Date 1-28-93
Duplication by aeration to storm
JOEL LUCIA, R. S., M. P. H.
Health Commissioner
BY N. Niehus

A. To be brought to finished grade
1. Septic tank manhole covers
2. Splitter box cover
3. Distribution box cover
B. No footer drains or downspouts to be discharged into septic tanks
C. All waste water to be discharged into septic tanks

VILLAGE SURVEYING Co.
202 THIRD ST. FAIRPORT HBR. OH 44077
(216) 357-1359

LOW YIELD WATER FIXTURES REQUIRED ON ALL:
___ Shower Head
___ Toilet

APPROVED
SIDE LINES & SET BACK
PERRY TOWNSHIP ZONING
PERMIT NO. 4738
ZONING INSPECTOR Don King

STATE OF OHIO
THOMAS MARC COFFMAN
6857
REGISTERED
SURVEYOR

REV. JAN 27, 1993

I, the undersigned hereby certify that this topography, indicated by 1' contours, and elevations shown hereon represent an actual field survey made by me on Dec 8, 1992 and that the elevations were taken at appropriate intervals and that as of that

J. M. Coffman PS
No 6857