OFFICE: 354-4100

RES.: 354-8908

JOSEPH D. HADDEN

Registered Surveyor

130 E. JACKSON STREET

PAINESVILLE, OHIO 44077

Grading Plan Approved
as shown and/or noted
THOMAS P. GILLES, P.E.
Lake County Engineer

By JWK Date 26 April 73

DRAINAGE GRADE
NOT REQUIRED
FOR THIS PERMIT
PERMIT NO. 1359
ZONING INSPECTOR
Wallas H

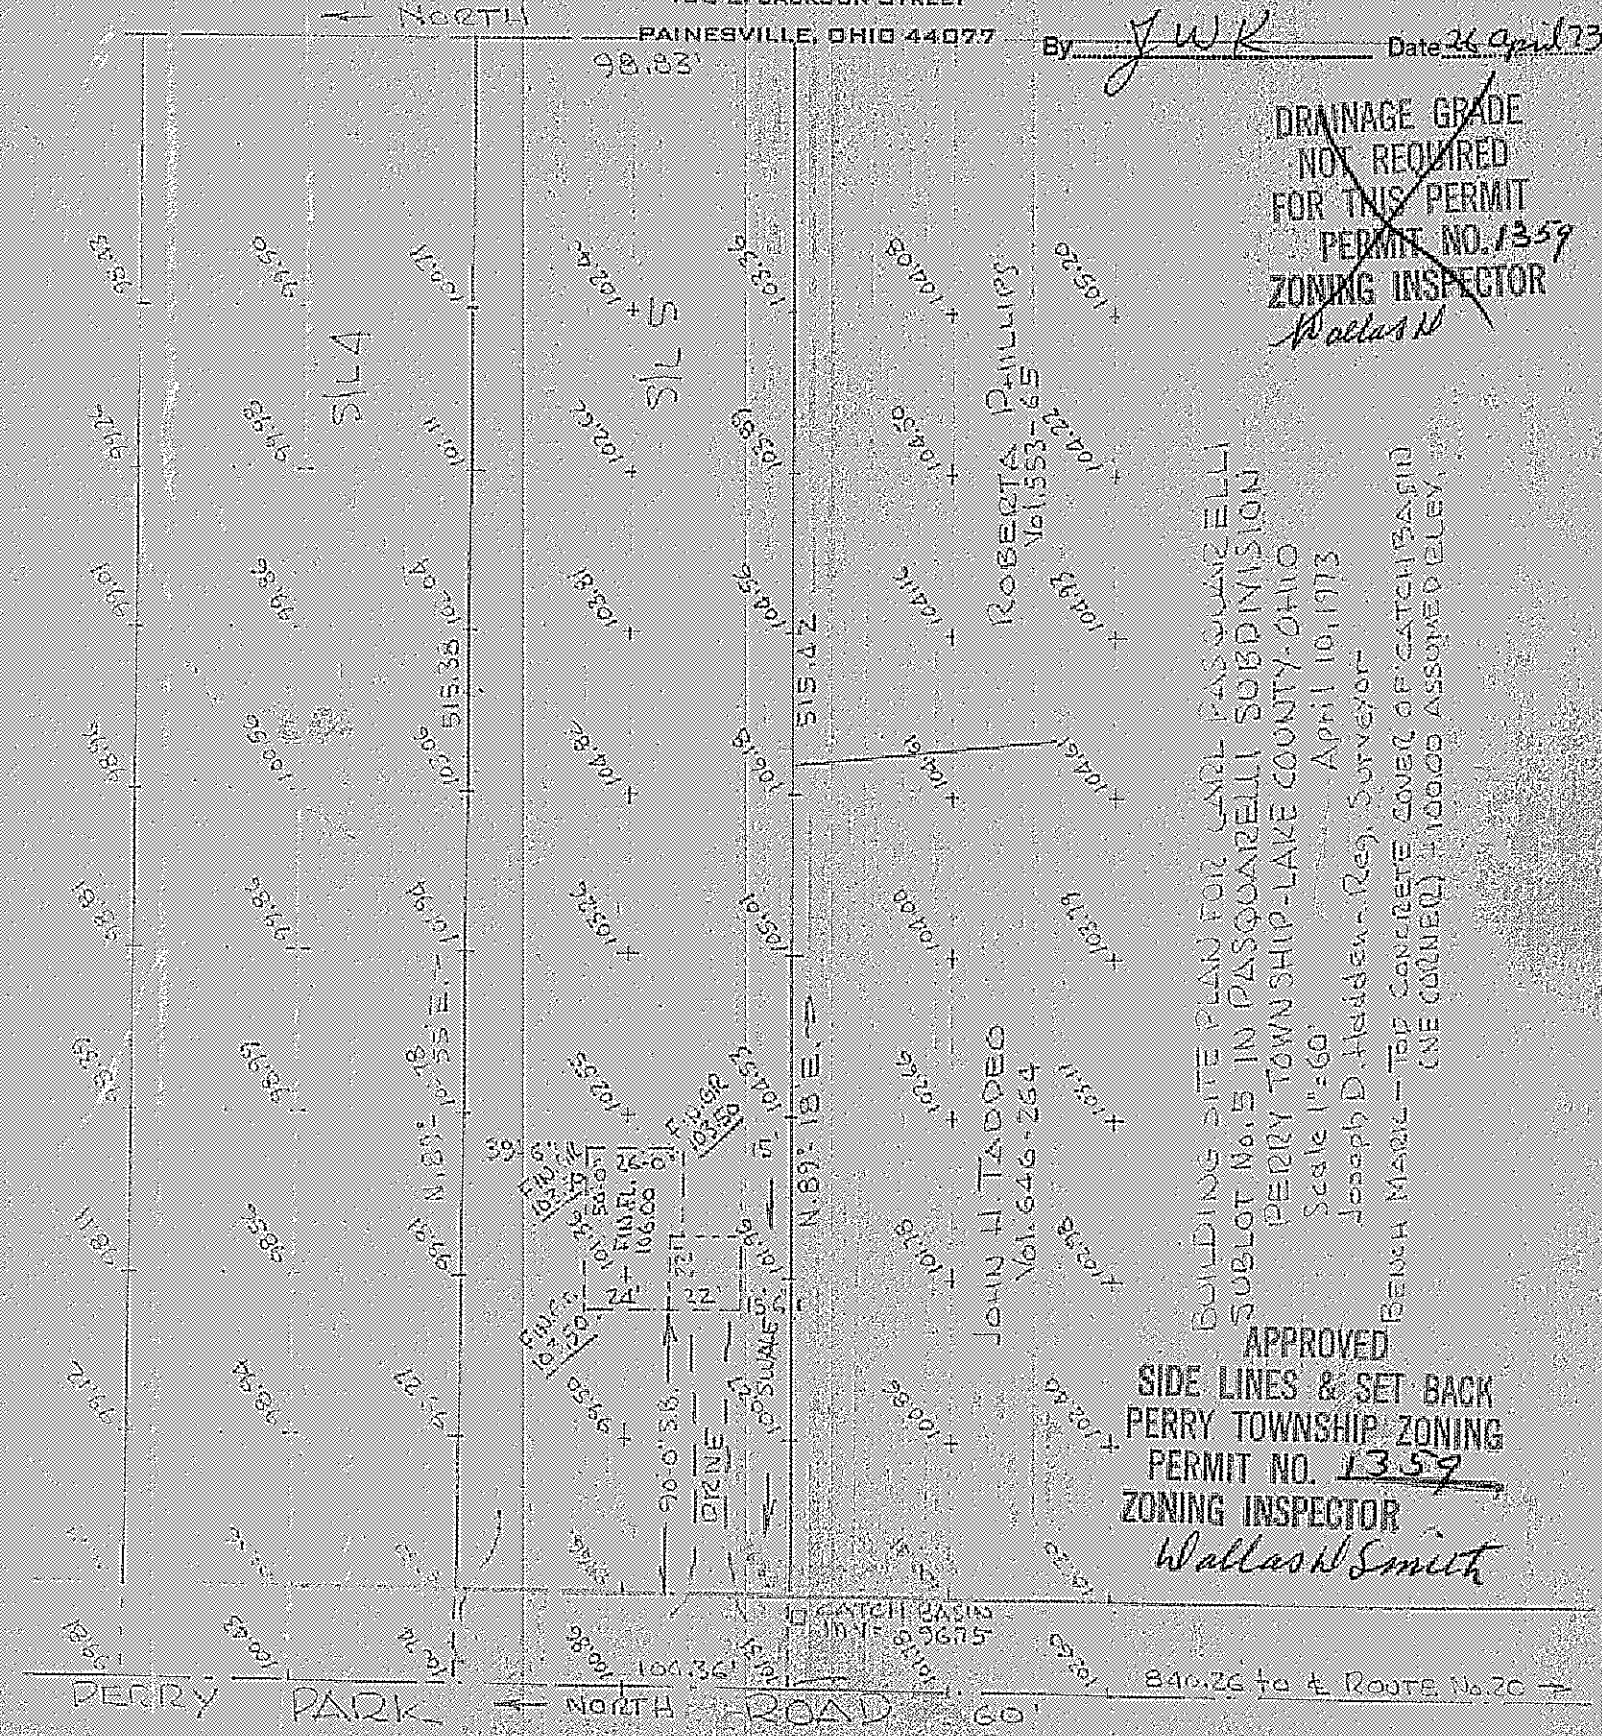

BUILDING SITE PLAN FOR CARL PASQUARELLI
SUBLOT No. 5 IN PASQUARELLI SUBDIVISION
PERRY TOWNSHIP-LAKE COUNTY-OHIO
Scale 1"=60' April 10, 1973
Joseph D. Hadden - Reg. Surveyor
BENCH MARK - TOP CONCRETE COVER OF CATCH BASIN
ONE CORNER) +100.00 ASSUMED ELEV.

APPROVED
SIDE LINES & SET BACK
PERRY TOWNSHIP ZONING
PERMIT NO. 1359
ZONING INSPECTOR
Wallas H Smith