SITE PLAN

LANE GROVE ESTATES

SUBLOT NO. 10

VOLUME S PAGE 12

PERRY TOWNSHIP

LAKE COUNTY OHIO

for

CASEMENT HOMES
1251 MADISON AVE.
PAINESVILLE, OHIO

PREPARED BY:

Wilson and Associates
Registered Surveyors
11005 Wilson Mills Road
Chardon, Ohio 44024

Date: March 29, 1974
Scale: 1" = 30'

Grading Plan Approved as shown and/or noted
THOMAS P. GILLES, P.E.
Lake County Engineer
By: [signature] Date 4-25-74

CERTIFICATION:

I certify that this plat was prepared by me, and is correct to the best of my knowledge.

By: Lawrence Wilson
Lawrence Wilson, Reg. Surveyor No. 5807

"AS BUILT" CERTIFICATION:

I certify that on _____ 1974, the finished grades were checked in the field, shown encircled, and are correct to the best of my knowledge

By: _____
Lawrence Wilson, Reg. Surveyor No. 5807
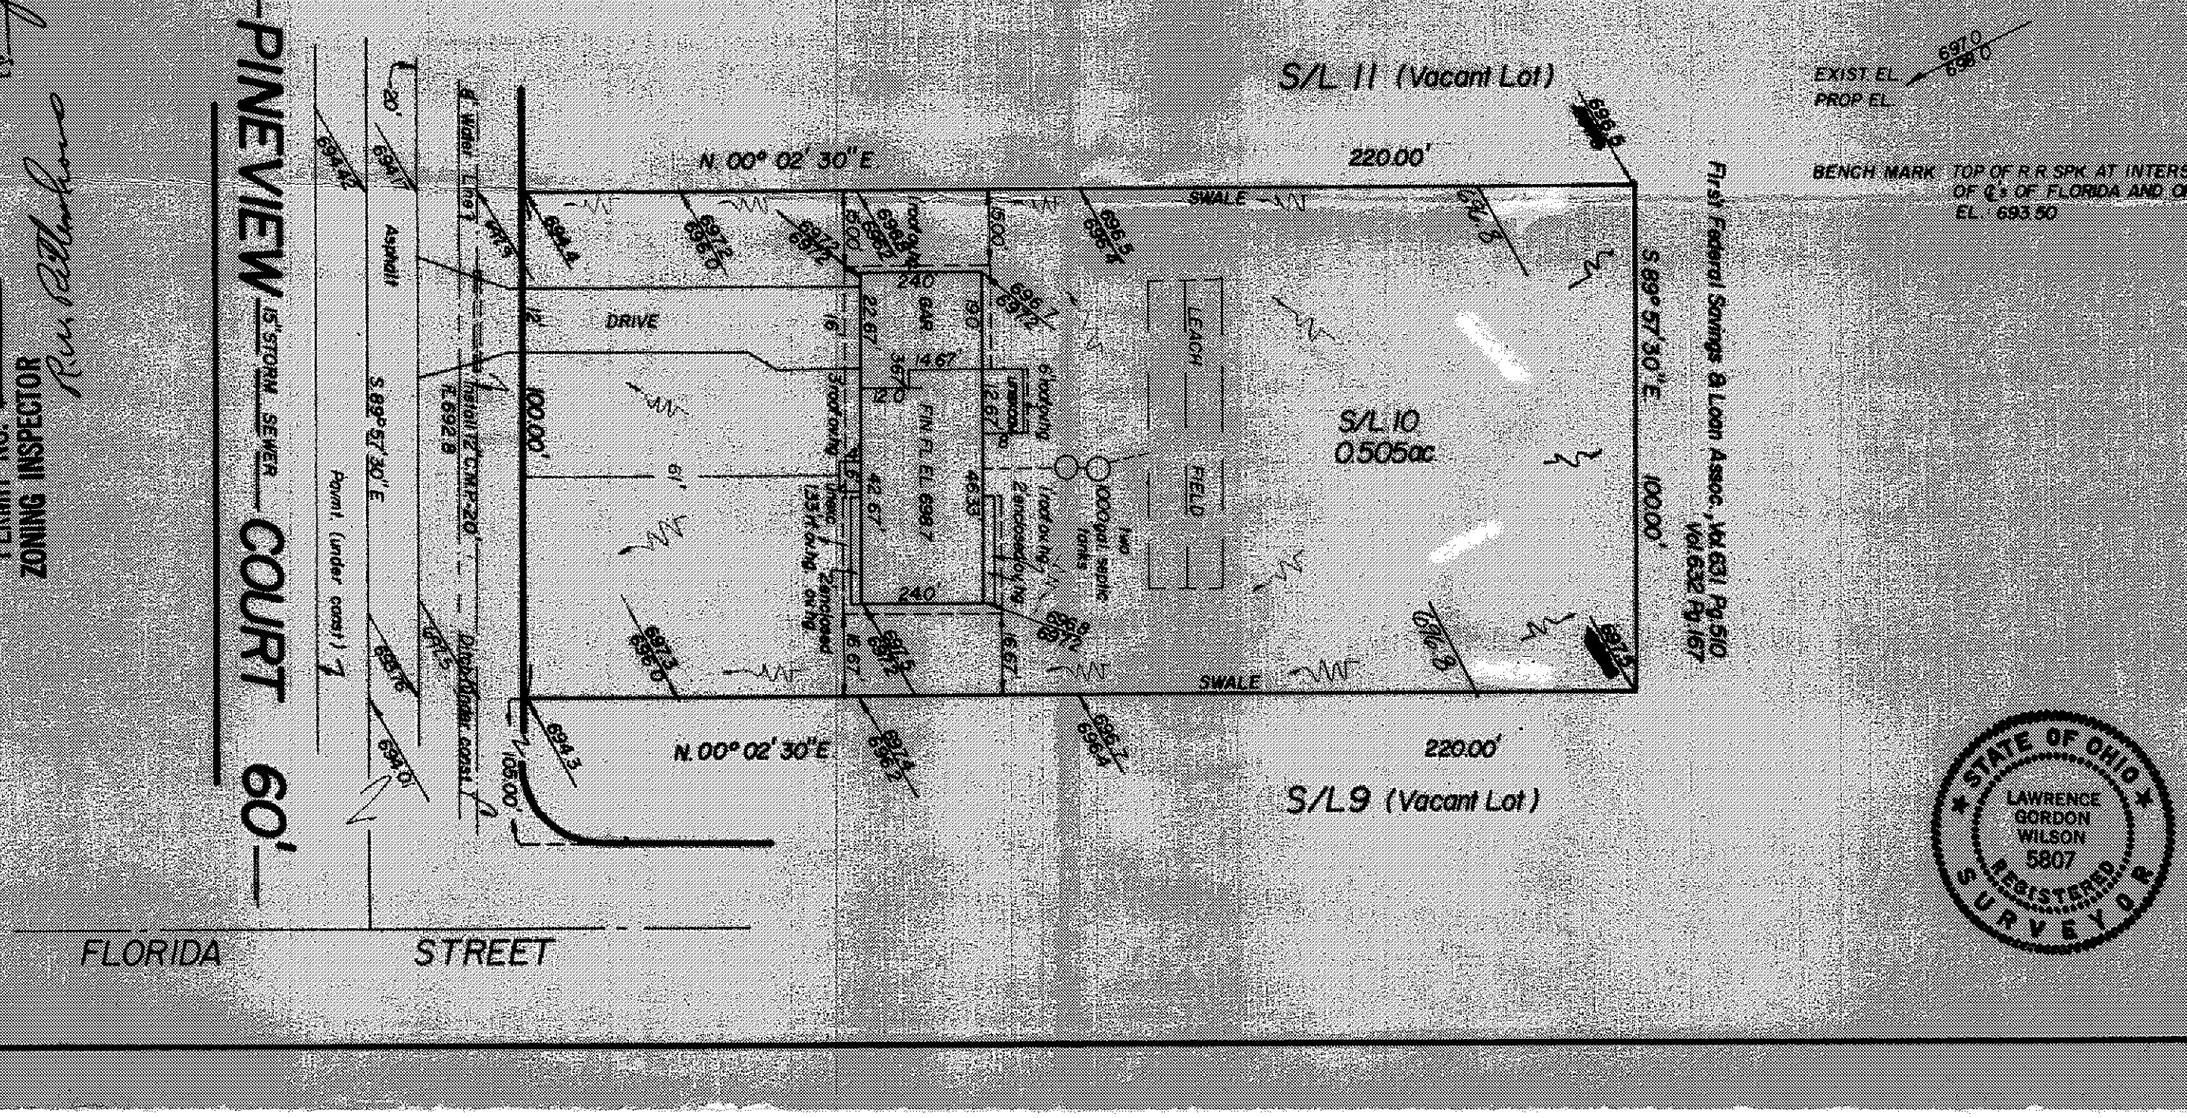
APPROVED
SIDE LINES & SET BACK
PERRY TOWNSHIP ZONING
PERMIT NO. 74-7
ZONING INSPECTOR [signature]