SITE PLAN
FOR
THE McGONNELL'S
BEING PART OF ORIGINAL LOT NO. 97
IN THE TOWNSHIP OF PERRY, COUNTY OF
LAKE, STATE OF OHIO.
2955 PERRY PARK ROAD

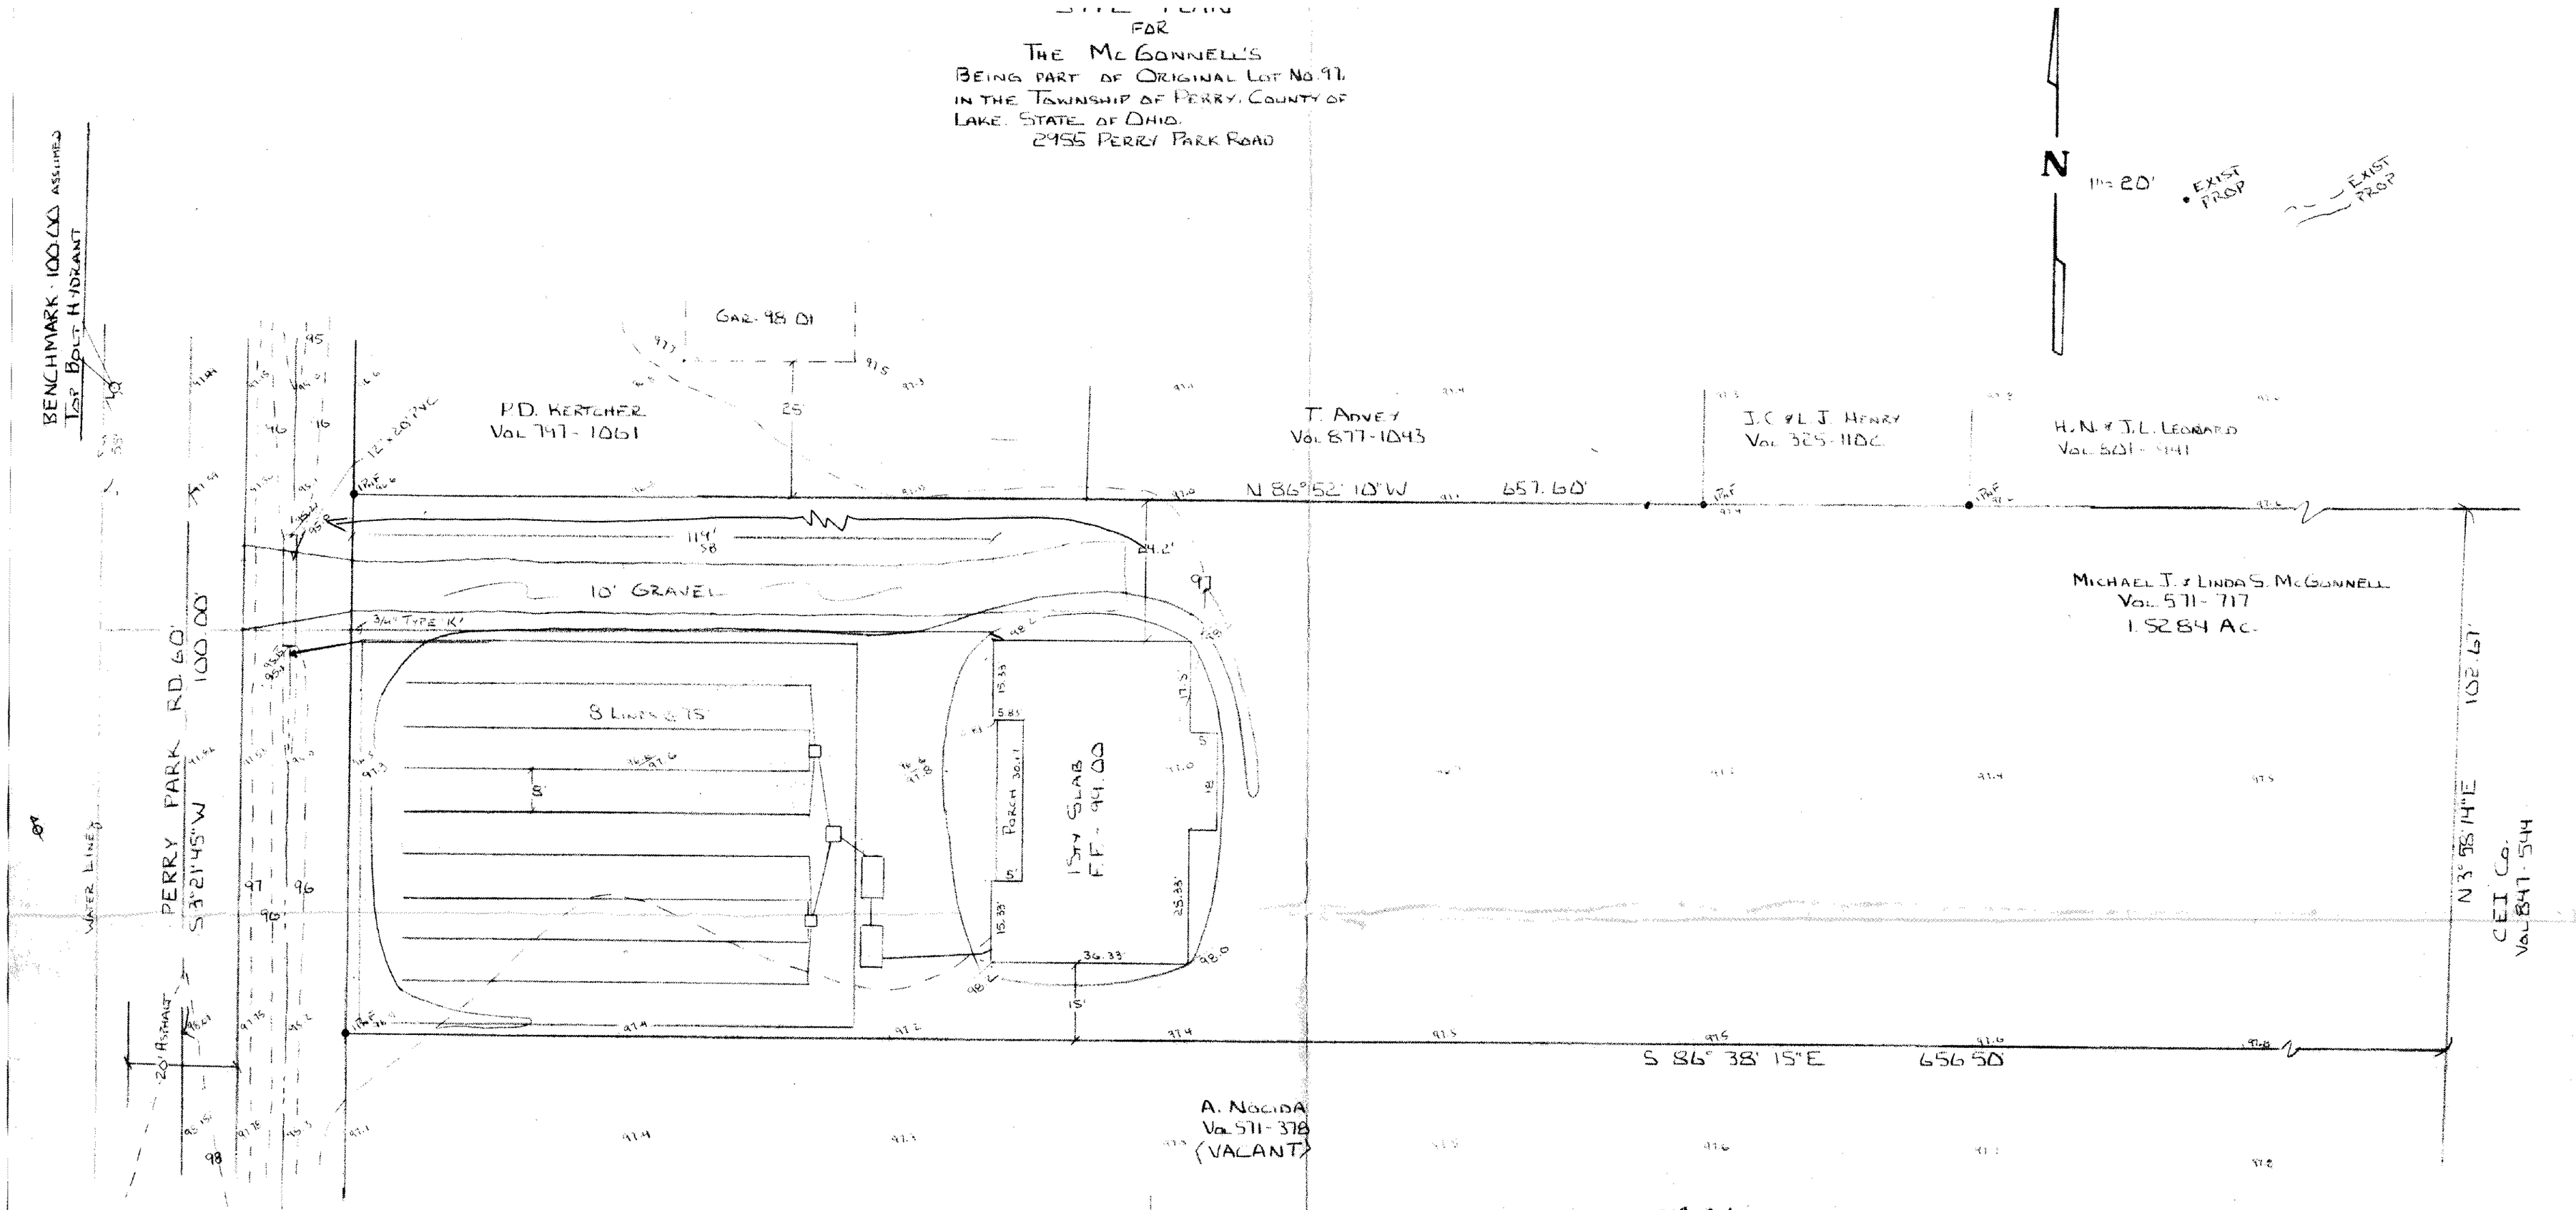

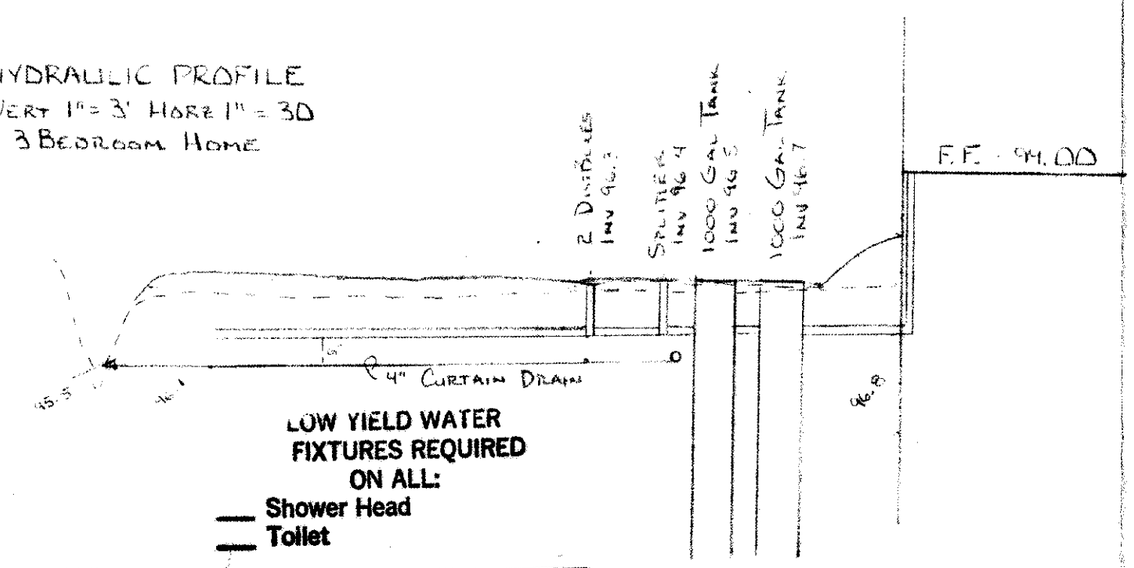

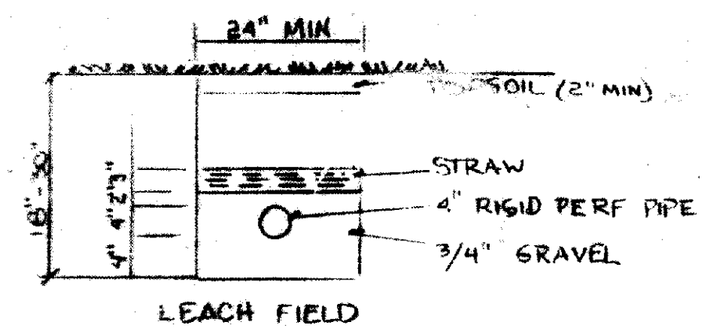

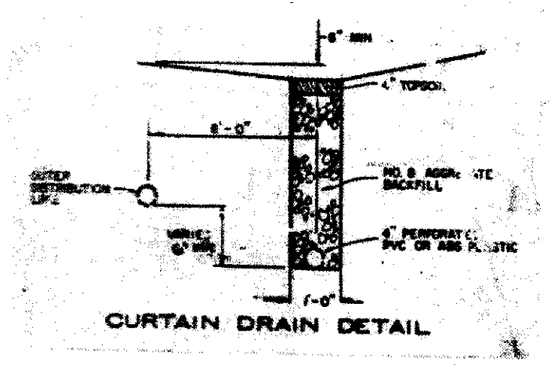

APRIL 7, 1993
REV 4-26 (RAISE SYSTEM)

LOW YIELD WATER
FIXTURES REQUIRED
ON ALL:
___ Shower Head
___ Toilet

SEWAGE DISPOSAL PERMIT MUST BE OBTAINED BY A LAKE COUNTY LICENSED INSTALLER BEFORE INSTALLATION IS STARTED.

VILLAGE SURVEYING Co.
202 THIRD ST. FAIRPORT HBR., OH 44077
(216) 357-1359

Reviewed and Accepted
LAKE COUNTY GENERAL HEALTH DISTRICT
Date April 26, 1993
Elevate system 1 foot
JOEL LUCIA, R. S., M. P. H.
Health Commissioner
BY Nancy Nieves

A. To be brought to finished grade
1. Septic tank manhole covers
2. Splitter box cover
3. Distribution box cover

B. No footer drains or downspouts to be discharged into septic tanks
C. All waste water to be discharged into

I, the undersigned hereby certify that this topography, indicated by 1' contours, and elevations shown hereon represent an actual field survey made by me on APRIL 2, 1993 and that the elevations were taken at appropriate intervals and that as of that

J. M. Coffman PS
No 6867

Grading Plan Approved
as shown and/or noted
THOMAS P. GILLES, P.E.
Lake County Engineer
By GIH Date 4-29-93

SWALE AS SHOWN