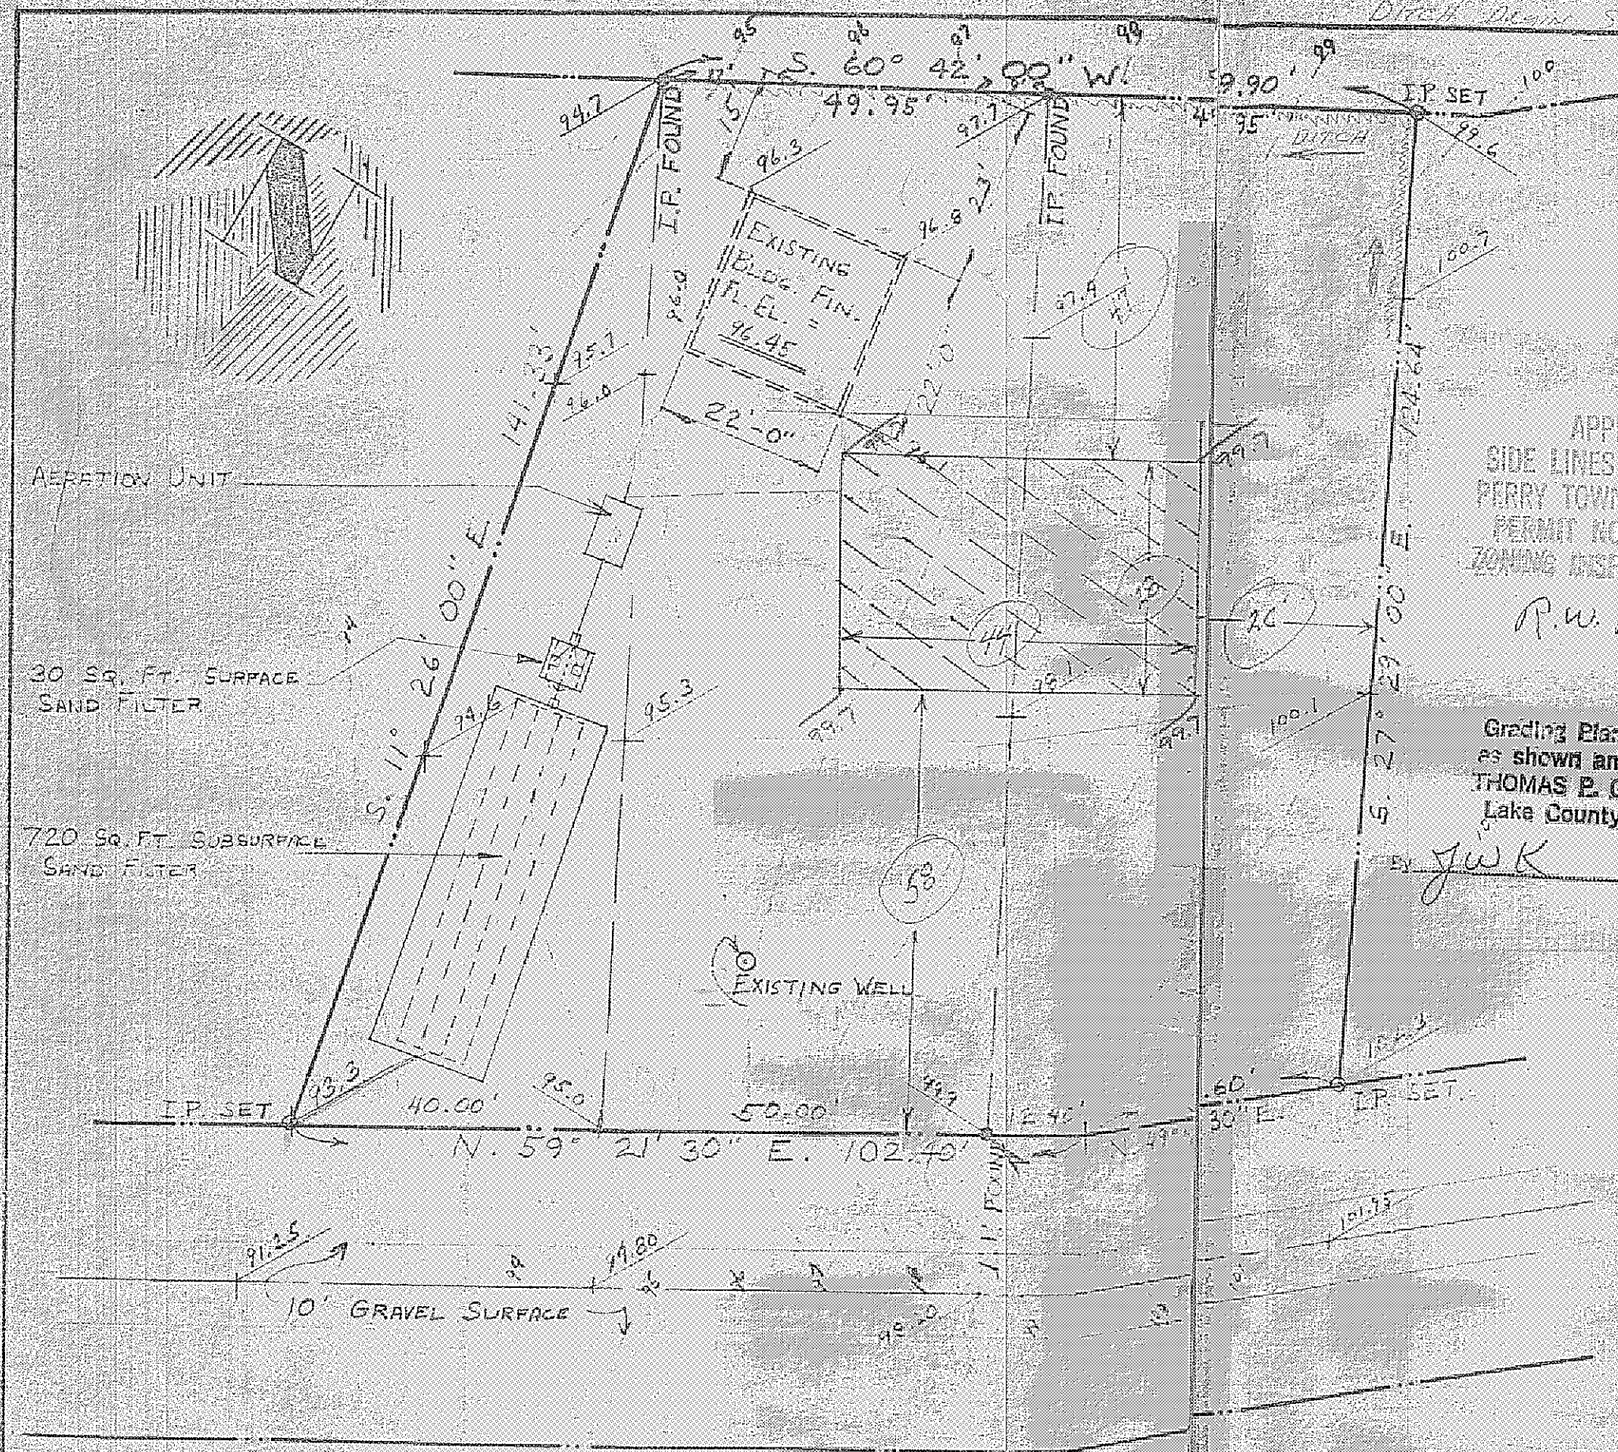

APPROVED
SIDE LINES & SET BACK
PERRY TOWNSHIP ZONING
PERMIT NO. 1562
ZONING INSPECTOR
R.W. Rittenhouse

Grading Plan Approved
as shown and/or noted
THOMAS P. GILLES, P.E.
Lake County Engineer
By JWK Date 9-10-74

SITE PLAN FOR:

CHARLES BROWN

6145 TALL OAKS DR.

MENTOR OHIO

BEING A PARCEL OF LAND LOCATED ON THE NORTH SIDE OF RIVER BANK DRIVE IN PERRY, OHIO.

PREPARED BY:

WM. R. GRAY ASSOC. INC.
7547 MENTOR, AVE.
MENTOR, OHIO

DATE: AUG. 20, 1974 SCALE 1" = 20'

REVISED DATE: AUG. 26, 1974

CERTIFICATION:

I HEREBY CERTIFY THAT THIS PLAT IS CORRECT TO THE BEST OF MY KNOWLEDGE.

By: Wm R. Gray
WM. R. GRAY REG. SURV. #2752