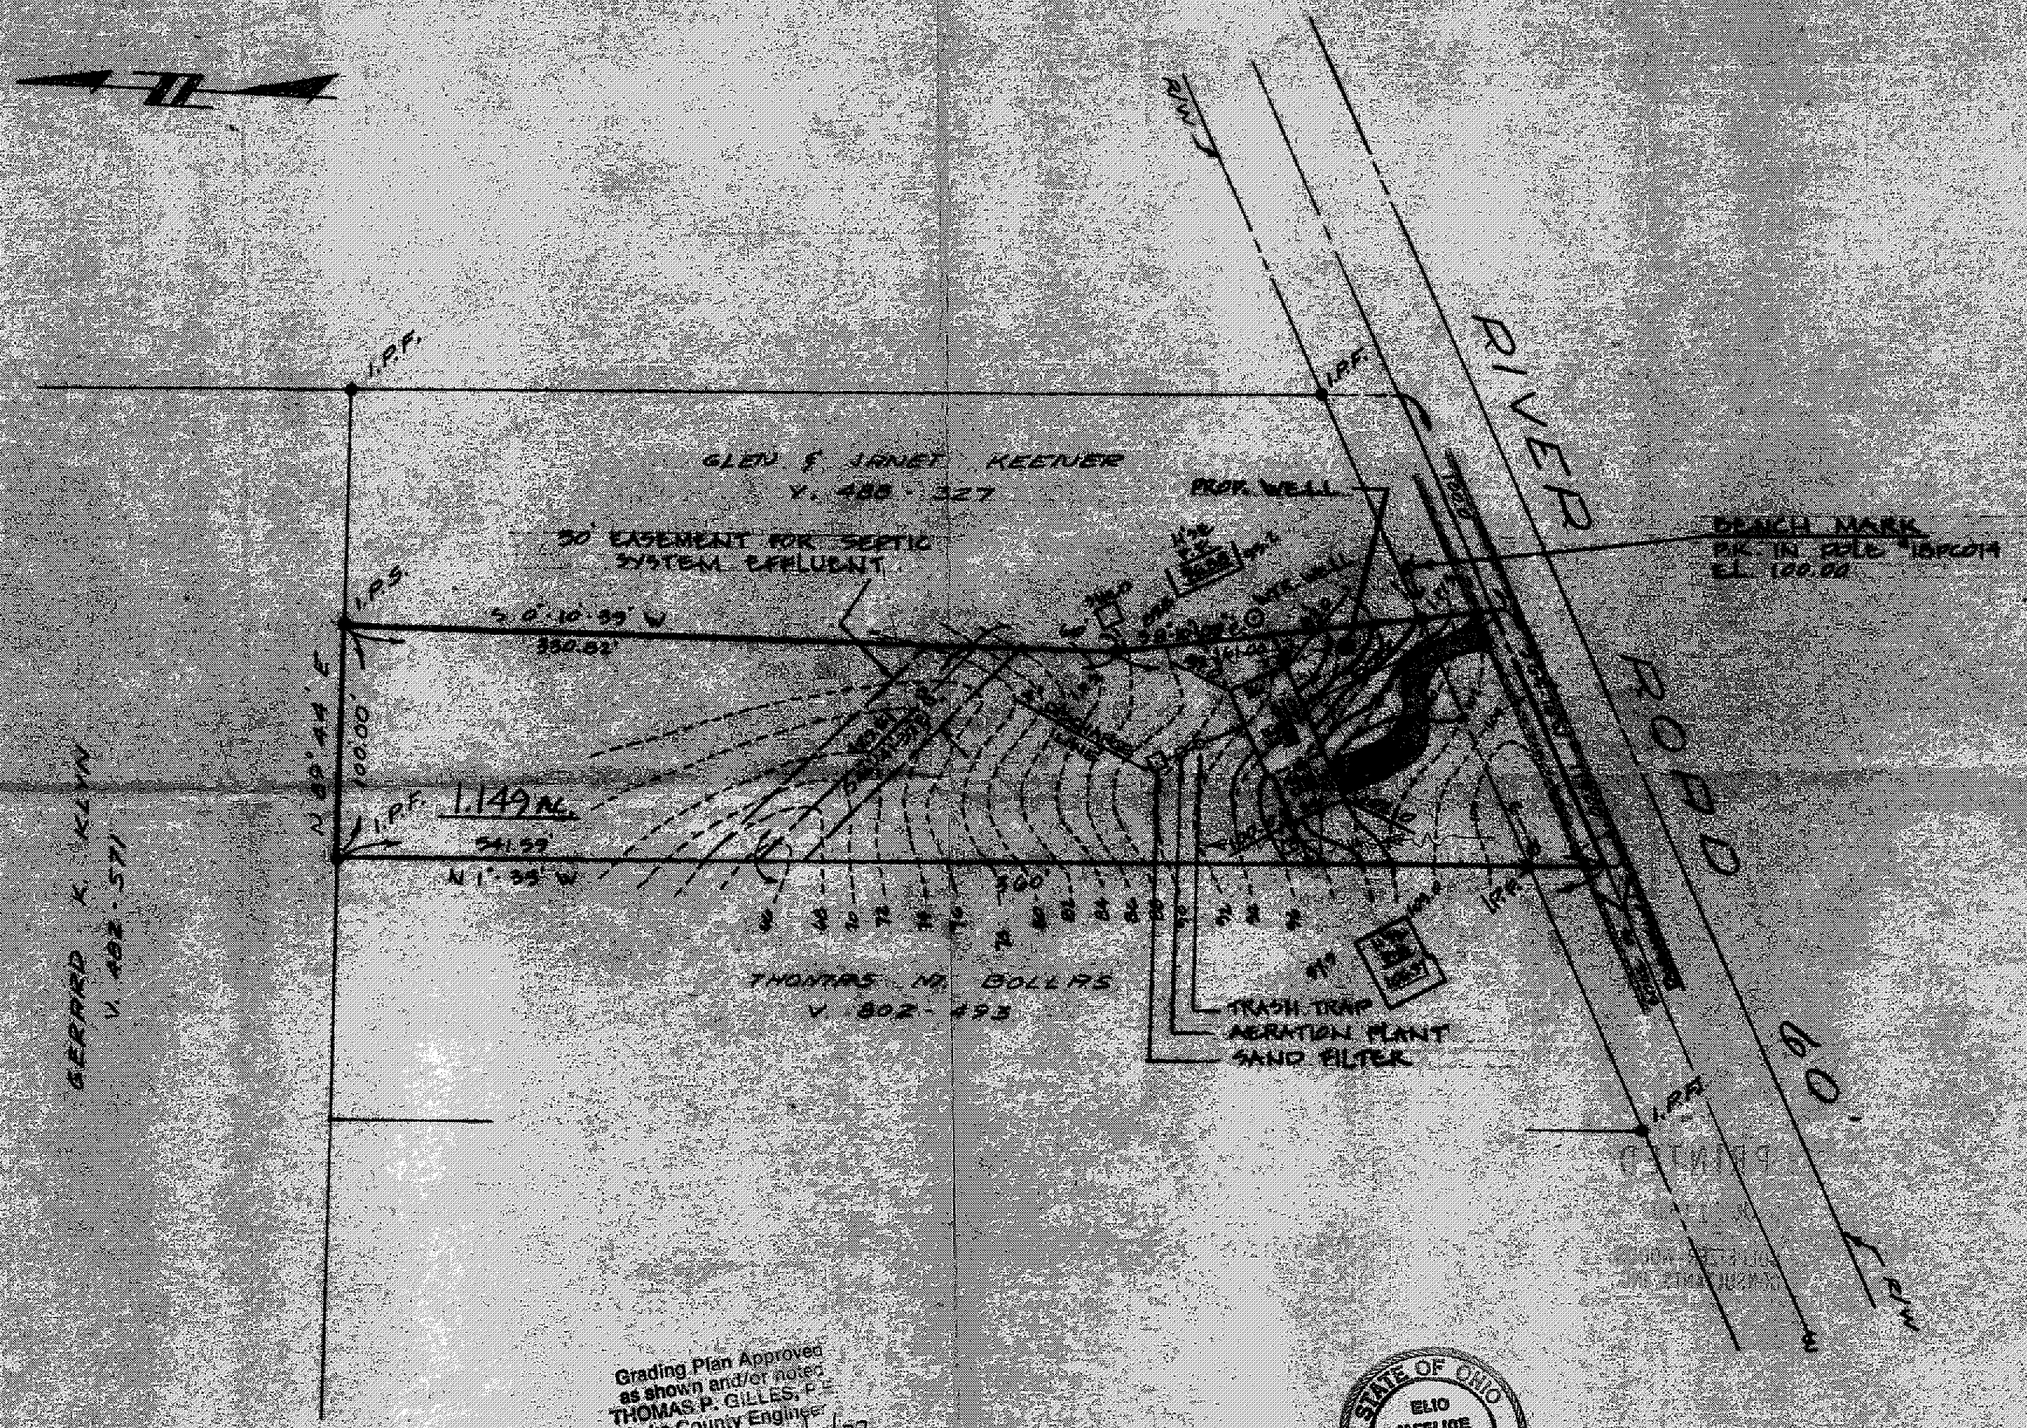

Grading Plan Approved
as shown and/or noted
THOMAS P. GILLES, P.E.
Lake County Engineer
By D.J.L. Date 7/14/77

STATE OF OHIO
ELIO IAFELICE
4786
REGISTERED
SURVEYOR

APPROVED
SIDE LINES & SET BACK
PERRY TOWNSHIP ZONING
PERMIT NO. 1941
ZONING INSPECTOR

7/13/77

subject to completion of plat survey
with side yd. clearance & set back
clearly marked
also (seal)

PLAT OF SURVEY
FOR
GLEN & JANET KEENER
PART OF ORIG. LOT 27, PERRY TWP., LAKE COUNTY, OHIO

DATE OCT. 1976
SCALE 1"=50'
DRAWN BY O.C.
CHK'D BY E.I.
F.B. 293 PG. 132

Colpetzer - Woods Consultants, Inc.
CONSULTING ENGINEERS AND SURVEYORS
PAINESVILLE, OHIO 44077

SHEET 1 /
CONTRACT 76-2

4597-1-2-C