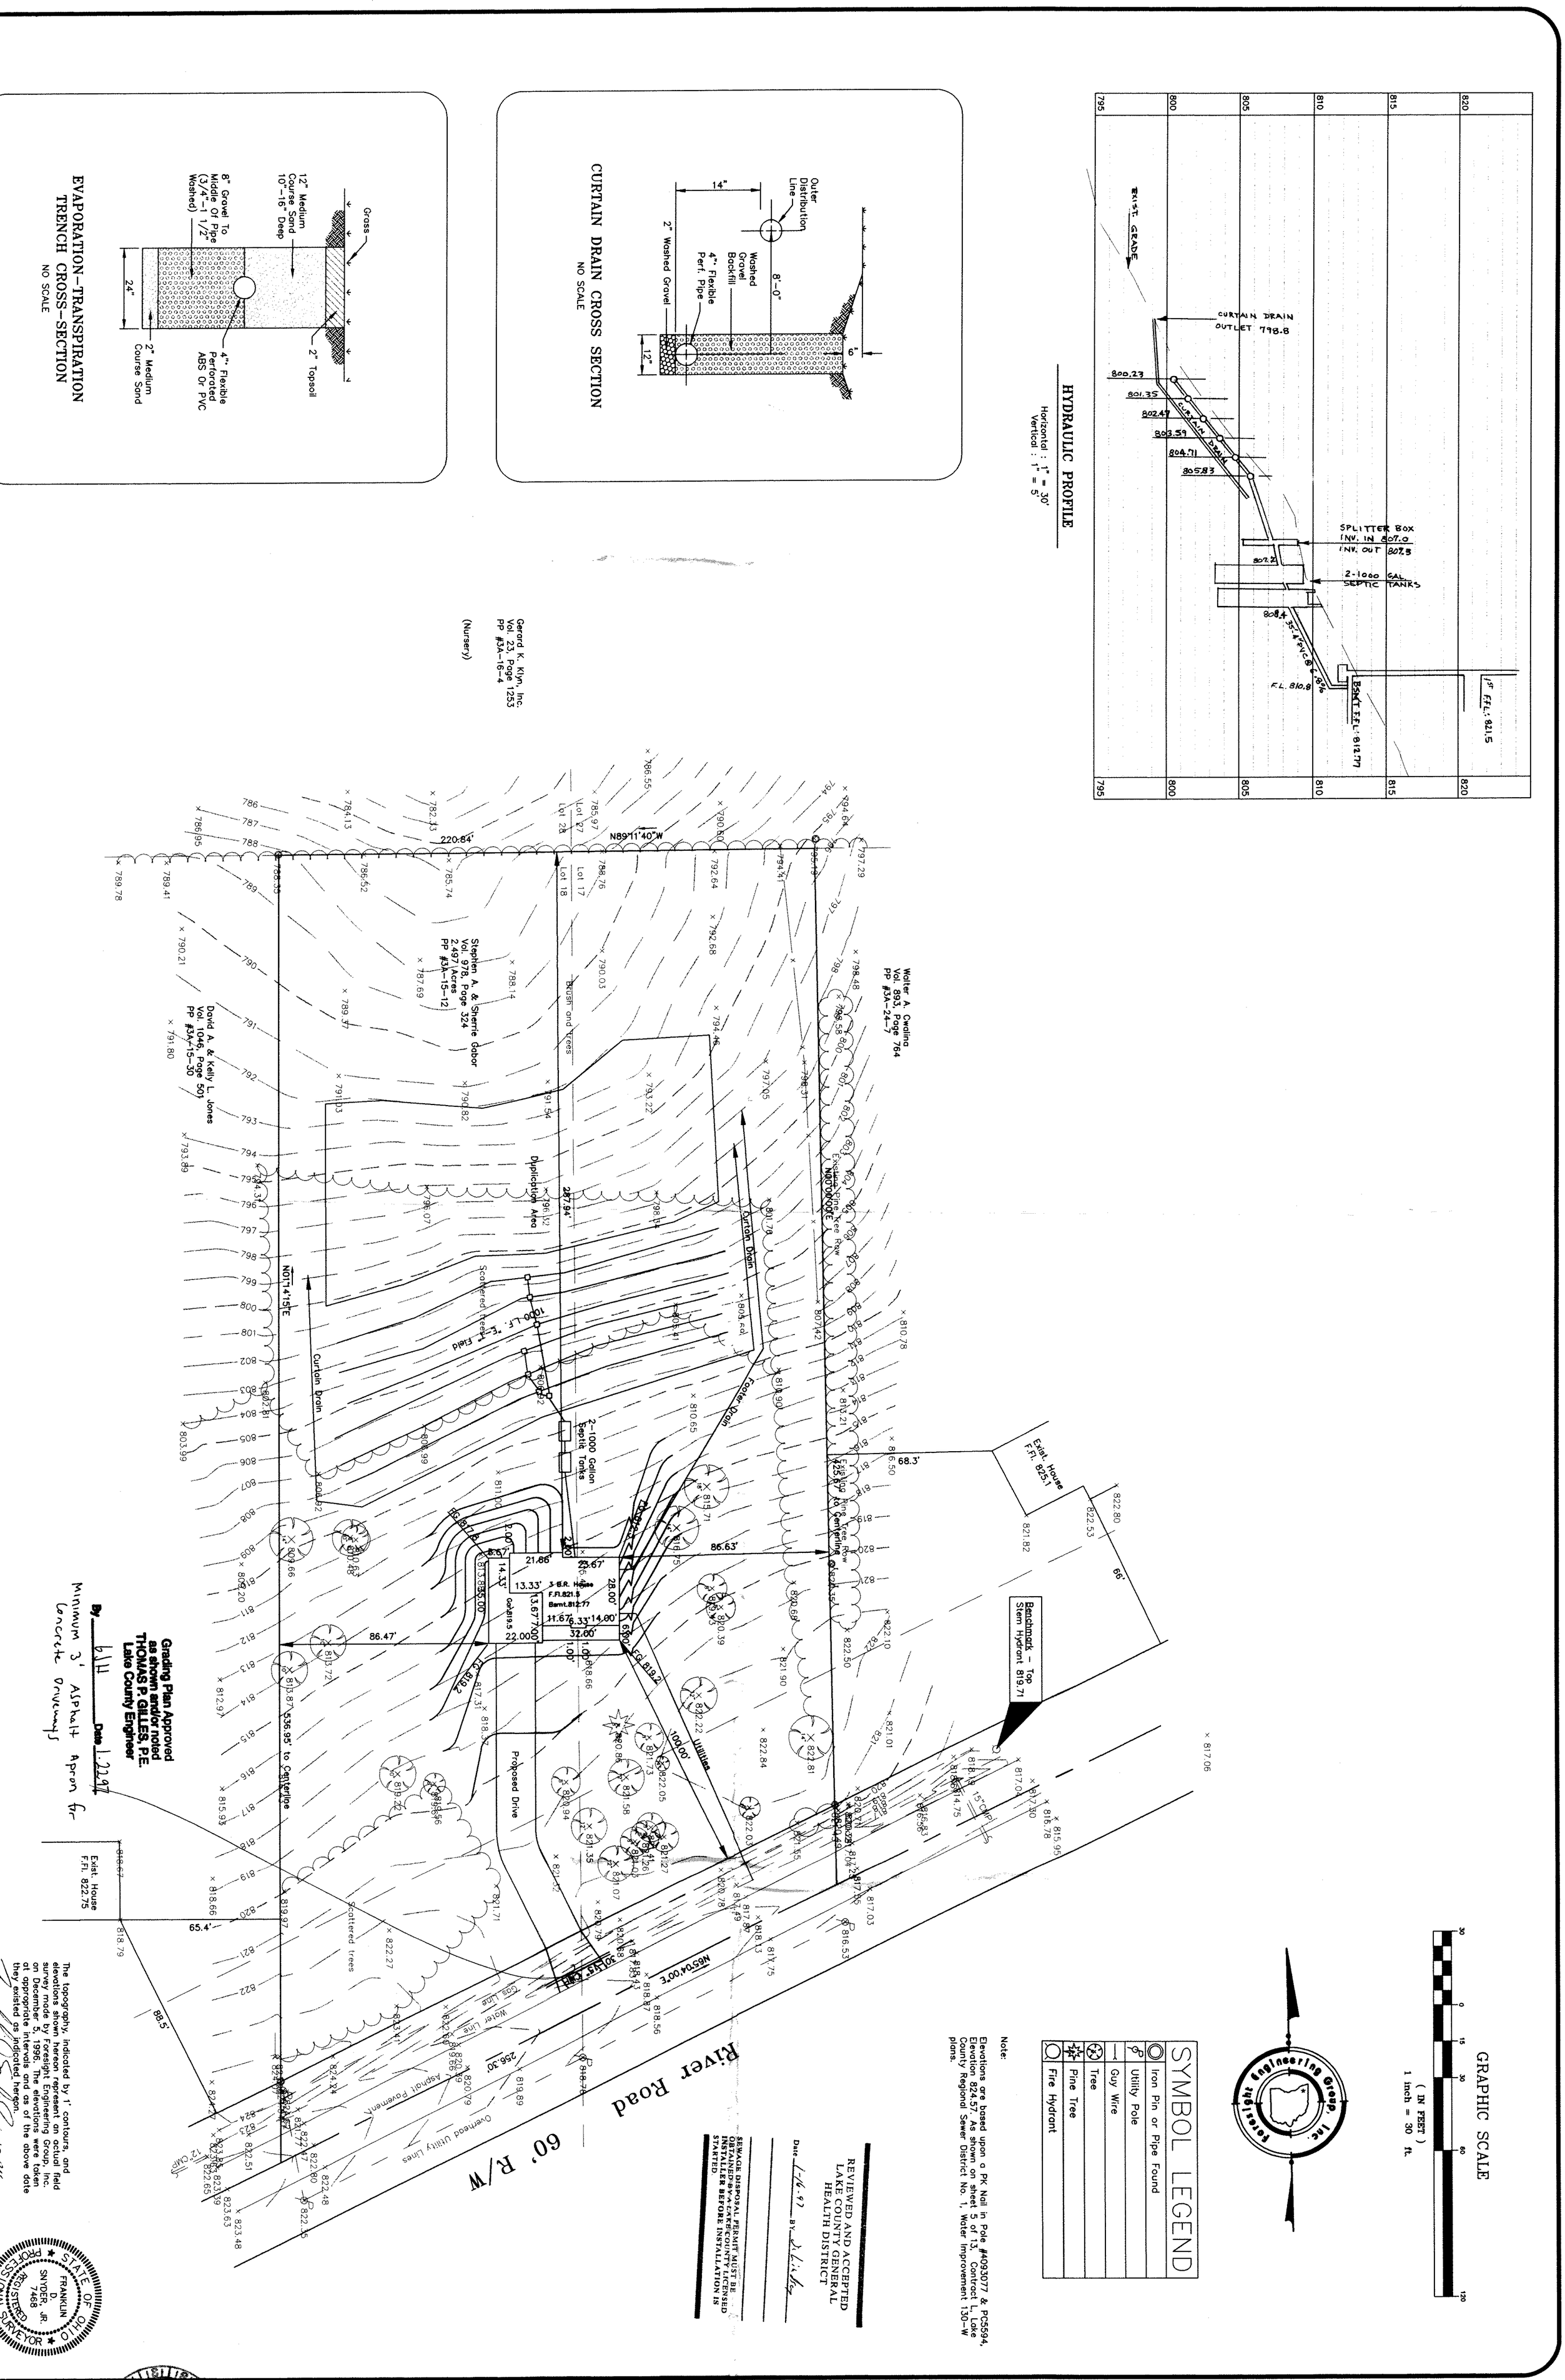

SHEET NO.

McCullough Builders
Part of Lots 17 & 18
Perry Twp., Lake County, Ohio
Site Plan

REVISIONS:	SCALE : Horz. 1" = 30' Vert. None
Septic System 1-13-97	FILE NAME: I:\Mcc19610\Topo
	DATE : Dec. 30, 1996

Foresight Engineering Group
216 286-1010
216 286-1034 fax
320 Center Street, Unit F
Chardon, Ohio 44024
Engineers & Surveyors