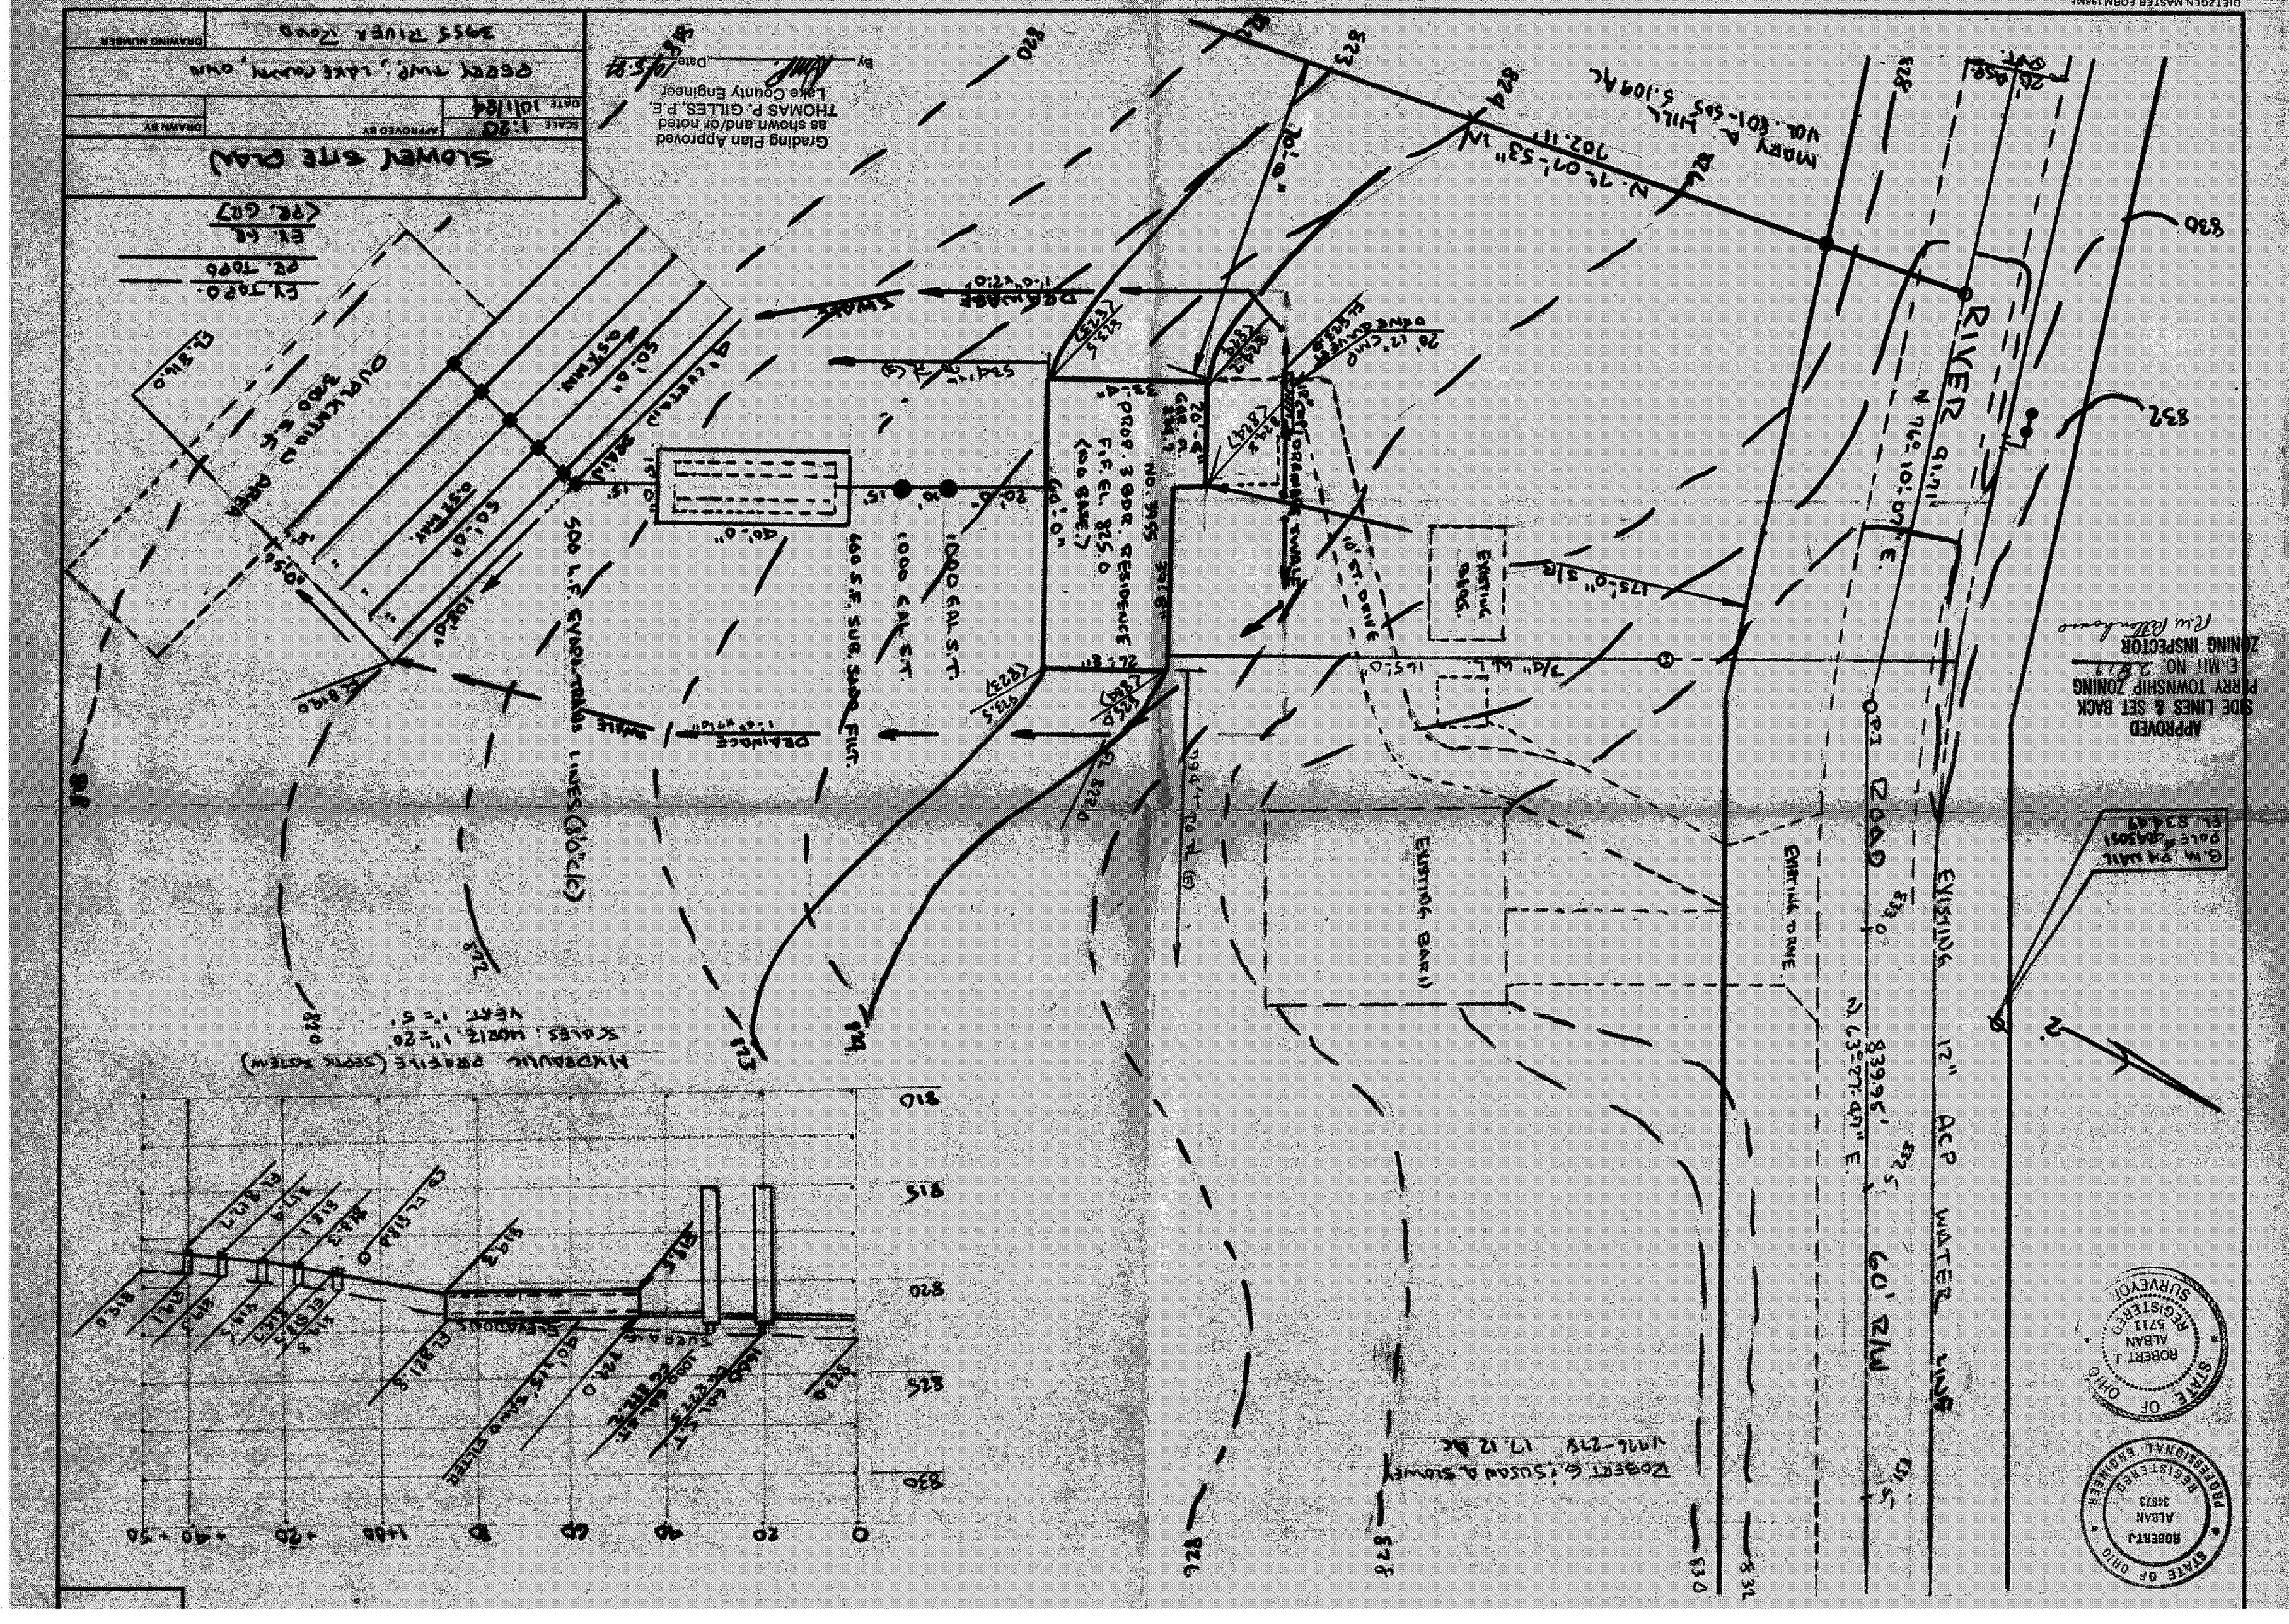
SLOWEY SITE PLAN
SCALE 1:20
DATE 10/1/84
APPROVED BY
DRAWN BY
PERRY TWP., LAKE COUNTY, OHIO
3955 RIVER ROAD
DRAWING NUMBER
Grading Plan Approved
as shown and/or noted
THOMAS P. GILLES, P.E.
Lake County Engineer
By
Date 10/5/84
APPROVED
SIDE LINES & SET BACK
PERRY TOWNSHIP ZONING
ZONING INSPECTOR
RIVER
ROAD
EXISTING 12" ACP WATER LINE
60' R/W
EXISTING BARN
EXISTING DRIVE
EXISTING BLDG.
PROP. 3 BDR. RESIDENCE
NO. 3955
1000 GAL S.T.
600 S.F. SUB. SAND FILT.
500 L.F. EVAPO-TRANS LINES
DUPLICATION AREA
HYDRAULIC PROFILE (SEPTIC SYSTEM)
ROBERT G. & SUSAN A. SLOWEY
1976-278 17.12 AC.
STATE OF OHIO
ROBERT J. ALBAN
5711
REGISTERED SURVEYOR
STATE OF OHIO
ROBERT J. ALBAN
34873
REGISTERED PROFESSIONAL ENGINEER