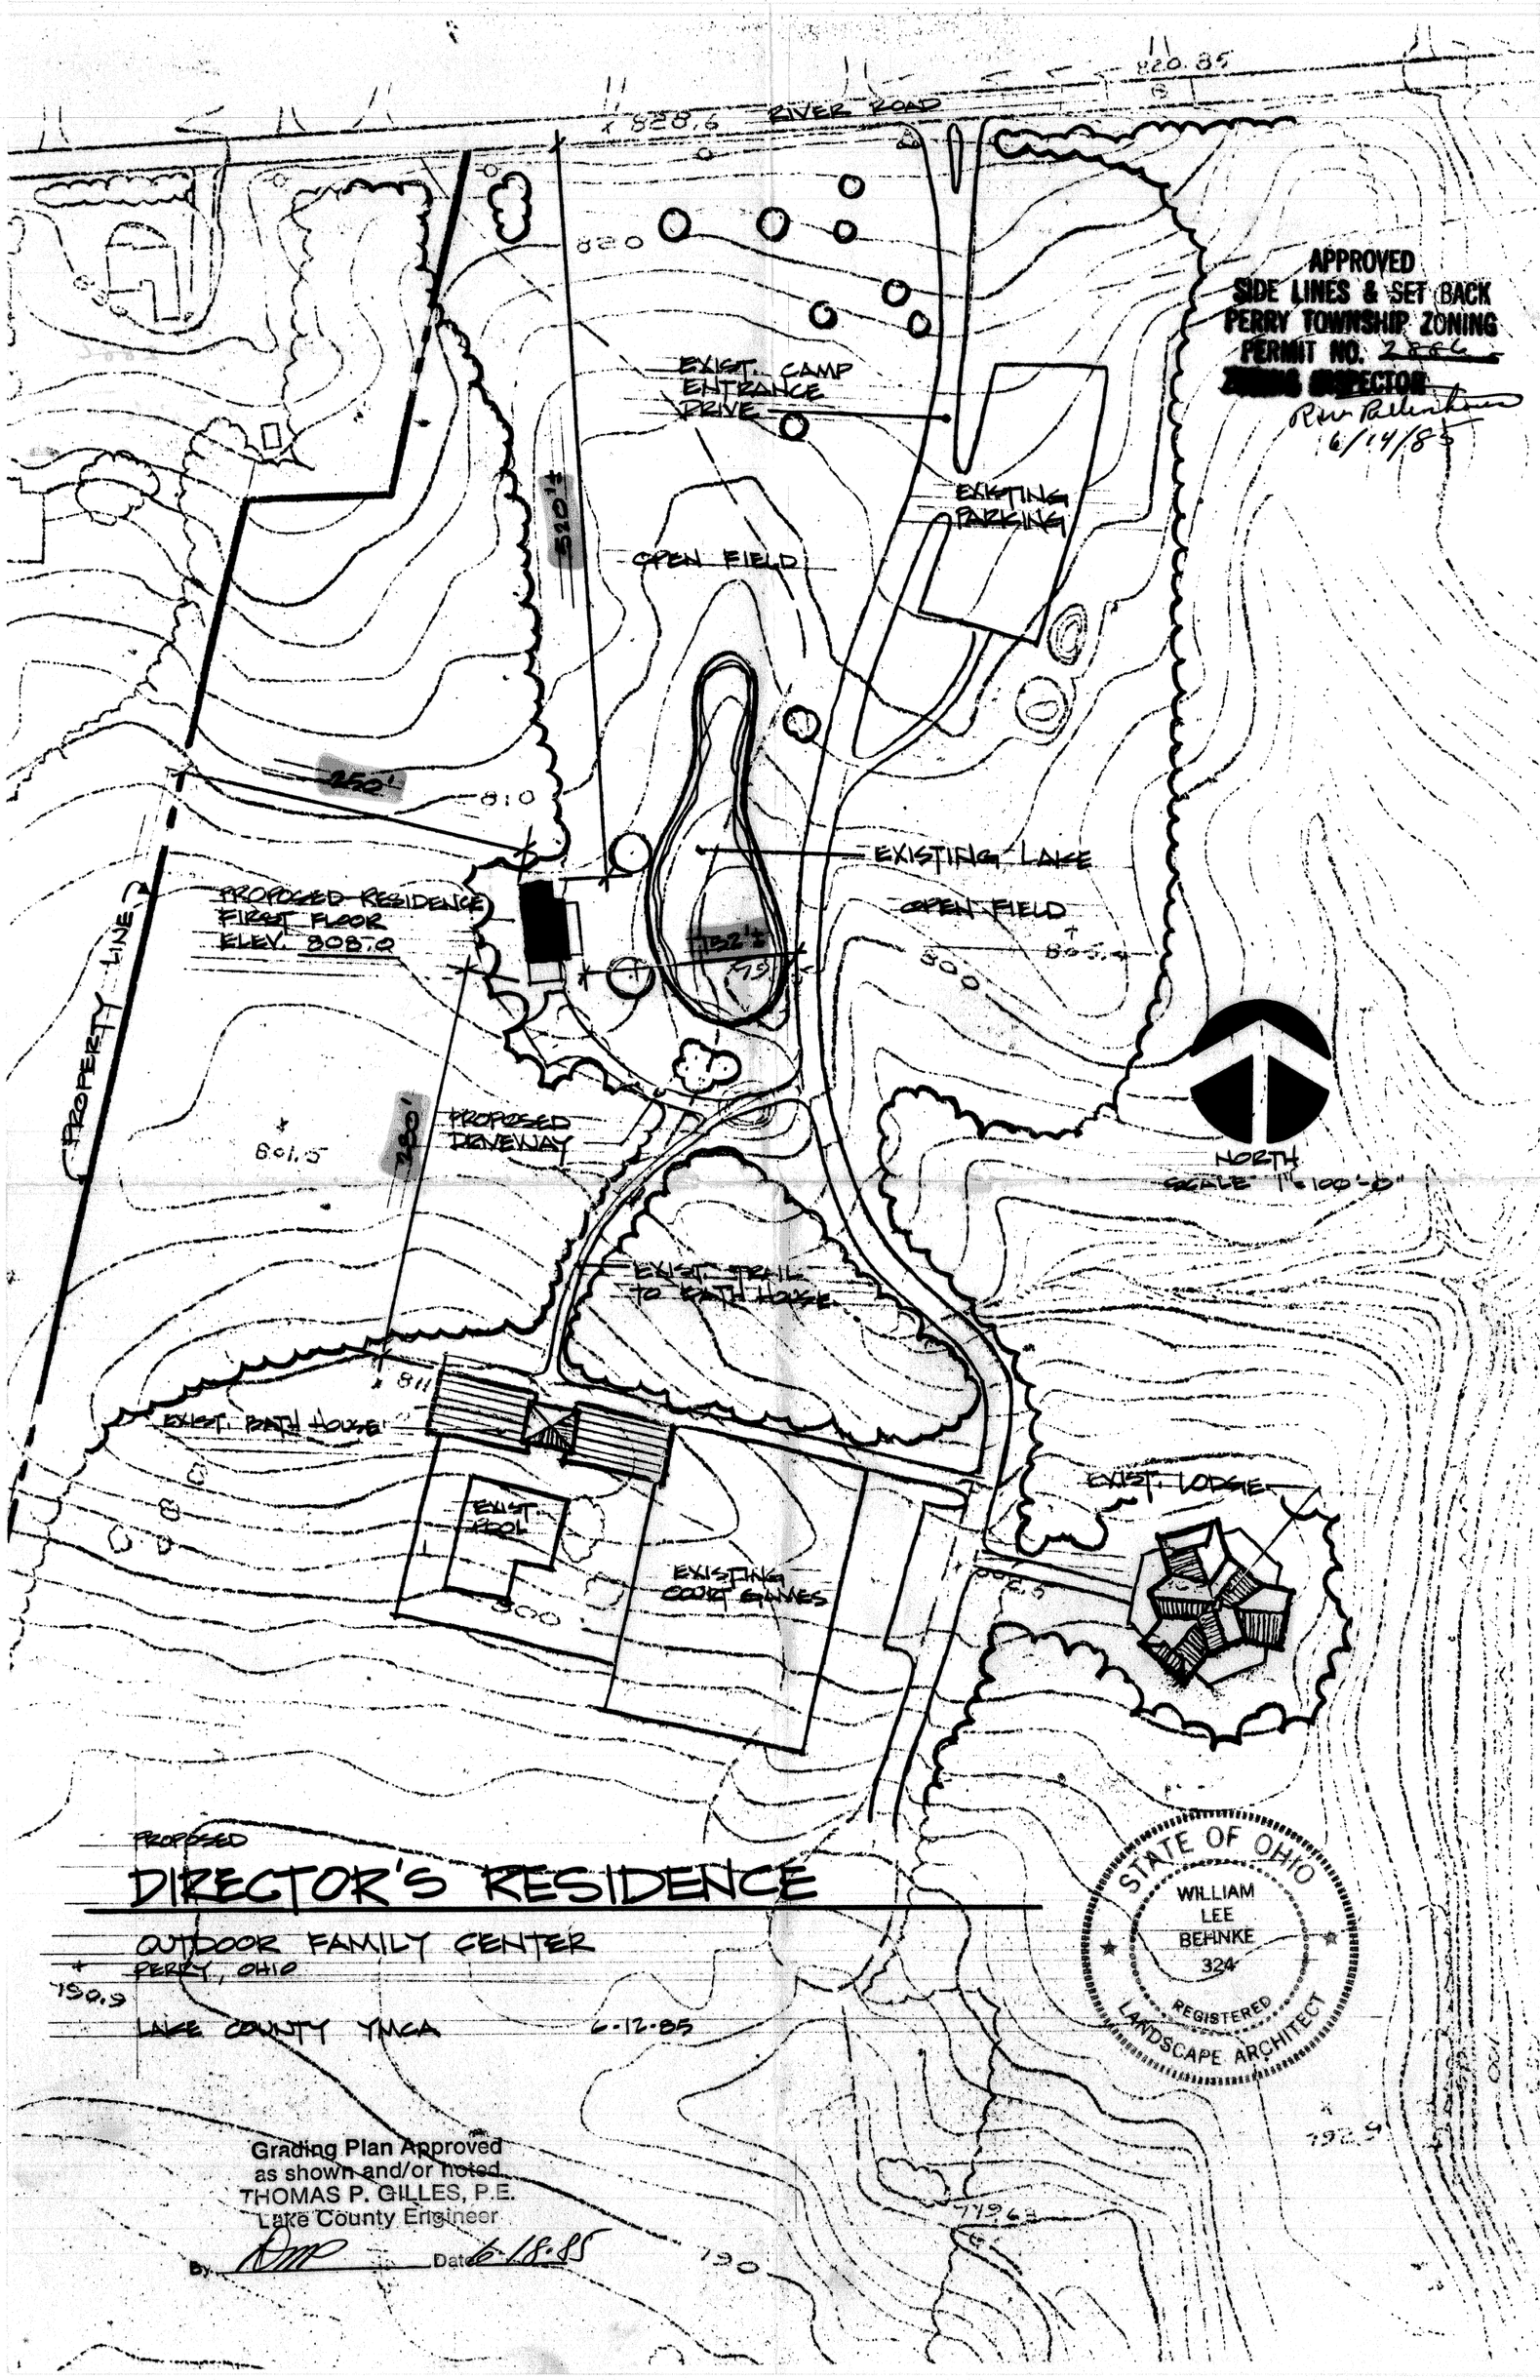

PROPOSED

DIRECTOR'S RESIDENCE

OUTDOOR FAMILY CENTER

PERRY, OHIO

LAKE COUNTY YMCA

6-12-85